
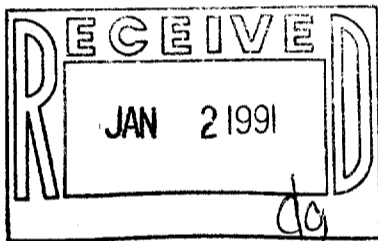


GENEVA LAKE

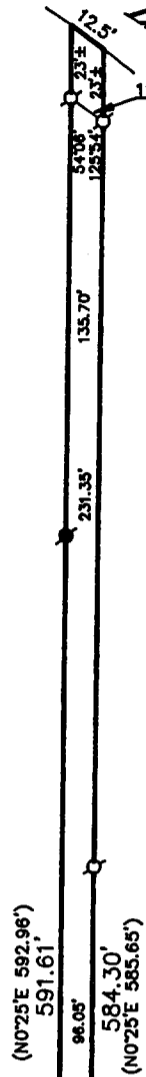

DETAIL SCALE  
1" = 30'

CONCRETE SLAB

RESIDENCE

DRIVEWAY

BLOCK 3

Curved boundary data (clockwise from top-left):

- CH=57.41' (CH=S70°21'E 57.39')
- (S40°29'E 8.47')
- CH=S12°28'E 44.32' (CH=S39°69')
- R=112'
- CH=101.46' (N14°28'E 59.69')
- 36.93' (S84°04'E 36.59')
- R=320'
- CH=86.00' (CH=S40°38'E 86.20')
- 26.6'
- CH=S21°11'E 56.41' (CH=S50°41')
- 27.1'
- R=51'
- CH=53.50' (CH=N43°48'E 53.39')

Residence dimensions (clockwise from top-left):

- 27'
- 26.1'
- 6.6'
- 13.7'
- 36.9'
- 31.9'
- 26.3'
- 7.6'
- 13.1'
- 32.9'
- 28'
- 32'

Driveway dimensions:

- 26.6'

BLOCK 3, TRINKE ESTATES, ALSO THE ENTIRE WESTERN 12'3" STRIP  
WEST OF LOT 1, BLOCK 1, TRINKE ESTATES, T 1 N, R 17 E, WALWORTH  
COUNTY.

- I HEREBY CERTIFY THAT I HAVE SURVEYED THE ABOVE DESCRIBED PROPERTY AND THAT THE ABOVE MAP IS A TRUE REPRESENTATION THEREOF AND SHOWS THE SIZE AND LOCATION OF THE PROPERTY, ITS EXTERIOR BOUNDARIES, THE LOCATION OF ALL VISIBLE STRUCTURES AND DIMENSIONS OF ALL PRINCIPAL BUILDINGS THEREON, BOUNDARY FENCES, APPARENT EASEMENTS, ROADWAYS AND VISIBLE ENCROACHMENTS, IF ANY, TO THE BEST OF MY KNOWLEDGE AND BELIEF.

THIS SURVEY IS MADE FOR THE USE OF THE PRESENT OWNERS OF THE PROPERTY AND ALSO THOSE WHO PURCHASE, MORTGAGE OR GUARANTEE THE TITLE THERETO WITHIN ONE (1) YEAR FROM DATE HEREOF.

Robert M. Baerenwald  
ROBERT M. BAERENWALD  
WISCONSIN REGISTERED LAND SURVEYOR, S-1508

DATE June 19, 1990 JOB NO. 1611

NOTE: THIS IS NOT A CERTIFIED COPY UNLESS SEALED.

117-1047

ITE 00037