



ASSUMED

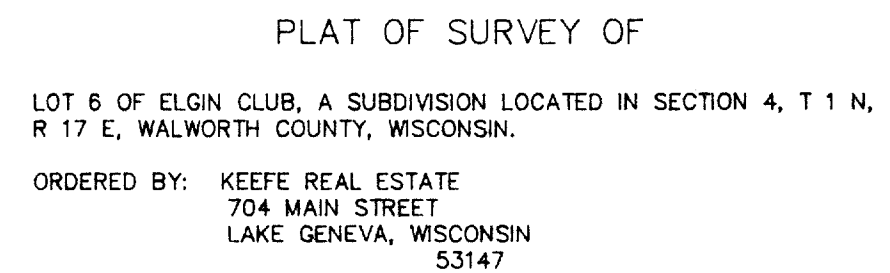

♂-IRON PIPE FOUND
 ○-IRON PIPE PLACED
 ●-STONE MONUMENT FOUND
 ()-RECORDED AS
 +-CUT CROSS IN CONCRETE

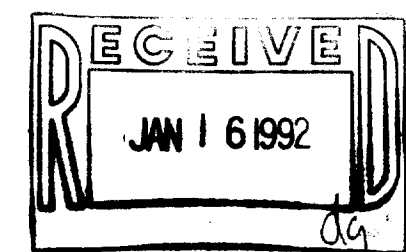

I HEREBY CERTIFY THAT I HAVE SURVEYED THE ABOVE DESCRIBED PROPERTY AND THAT THE ABOVE MAP IS A TRUE REPRESENTATION THEREOF AND SHOWS THE SIZE AND LOCATION OF THE PROPERTY, ITS EXTERIOR BOUNDARIES, THE LOCATION OF ALL VISIBLE STRUCTURES AND DIMENSIONS OF ALL PRINCIPAL BUILDINGS THEREON, BOUNDARY FENCES, APPARENT EASEMENTS, ROADWAYS AND VISIBLE ENCROACHMENTS, IF ANY, TO THE BEST OF MY KNOWLEDGE AND BELIEF.

THIS SURVEY IS MADE FOR THE USE OF THE PRESENT OWNERS OF THE PROPERTY AND ALSO THOSE WHO PURCHASE, MORTGAGE OR GUARANTEE THE TITLE THERETO WITHIN ONE (1) YEAR FROM DATE HEREOF.

HEREOF:

Robert M. Baerleinwald
ROBERT M. BAERLEINWALD
WISCONSIN REGISTERED LAND SURVEYOR, S-1508

DATE Feb. 5, 1998 JOB NO. 2802

NOTE: THIS IS NOT A CERTIFIED COPY UNLESS SEALED.