


KOLB LAND CONSULTING, INC.
LAND SURVEYING • SUBDIVIDING • LAND PLANNING

LAKE GENEVA, WISCONSIN 53147

WHITEWATER, WISCONSIN 53190

LEGEND

- - IRON PIPE 2" X 30", 3.65 LB./LIN. FT. MIN. WT.
- IRON PIPE 1 5/8" X 24", MIN. WT. 2.27 LB./LIN. FT. AT ALL OTHER LOT CORNERS
- - 6" X 30" ROUND CONCRETE MONUMENT FOUND

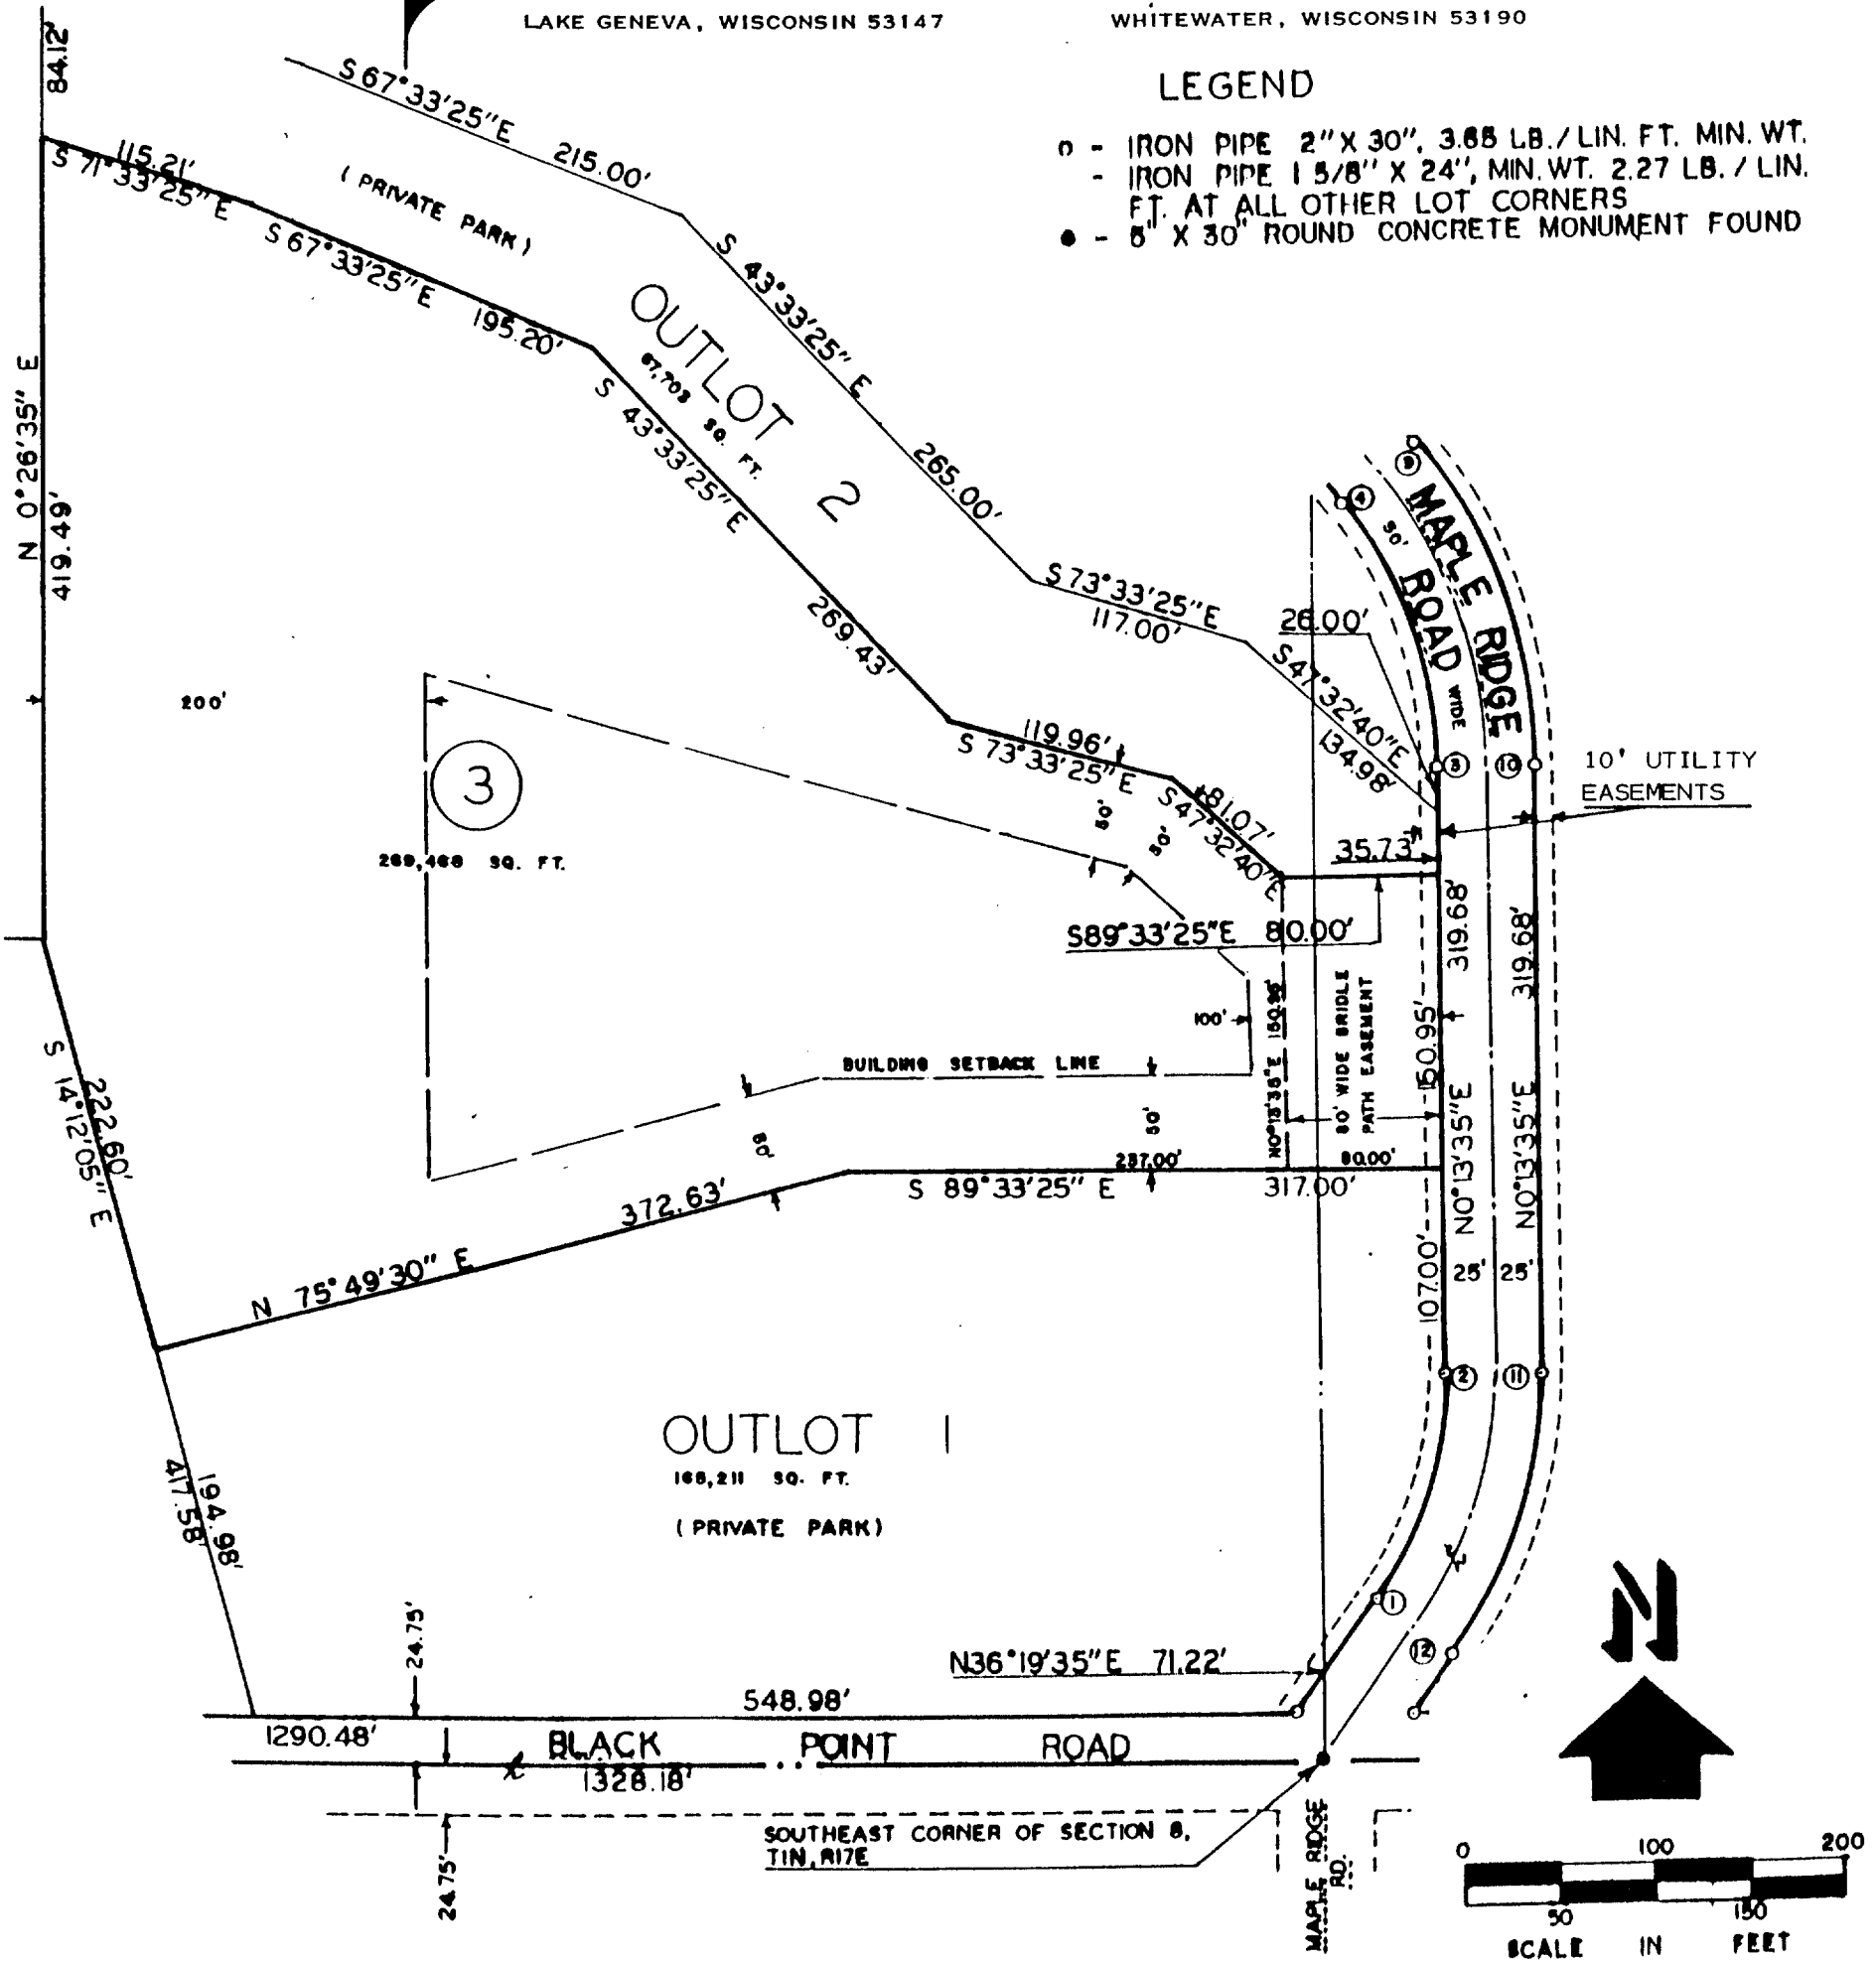

PLAT OF SURVEY OF

LOT 3, BLACK POINT FARM, A SUBDIVISION LOCATED
IN THE SE 1/4 OF SECTION 8 AND THE SW 1/4 OF
SECTION 9, T 1 N, R 17 E, TOWN OF LINN,
WALWORTH COUNTY, WISCONSIN

NOTE: BEARING ON THE SOUTH LINE OF SEC. 8
ASSUMED TO BE S 89°33'25" E


ORDERED BY: WILLIAM PETERSEN
1350 ASTER STREET
CHICAGO, IL. 60610

NOTE: ALL CORNERS OF LOT 3 FOUND OR
REPLACED.

I, HAROLD H. KOLB, DO HEREBY CERTIFY THAT
I HAVE SURVEYED THE PROPERTY HEREON DES-
CRIBED ACCORDING TO THE OFFICIAL RECORDS,
AND THAT THE PLAT HEREON IS A CORRECT REP-
RESENTATION OF THE LOT LINES TO THE BEST
OF MY KNOWLEDGE AND BELIEF.

SURVEY NOT VALID UNLESS SURVEYOR'S
SIGNATURE IS IN RED.

HAROLD H. KOLB
WISCONSIN REGISTERED LAND SURVEYOR, S-187
DATE JUNE 27, 1991

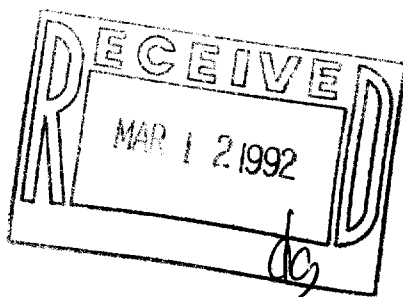


KOLB LAND CONSULTING, INC.
LAND SURVEYING • SUBDIVIDING • LAND PLANNING

LAKE GENEVA, WISCONSIN 53147

WHITEWATER, WISCONSIN 53190

LEGEND

- - IRON PIPE 2" X 30", 3.65 LB./LIN. FT. MIN. WT.
- IRON PIPE 1 5/8" X 24", MIN. WT. 2.27 LB./LIN. FT. AT ALL OTHER LOT CORNERS
- - 8" X 30" ROUND CONCRETE MONUMENT FOUND

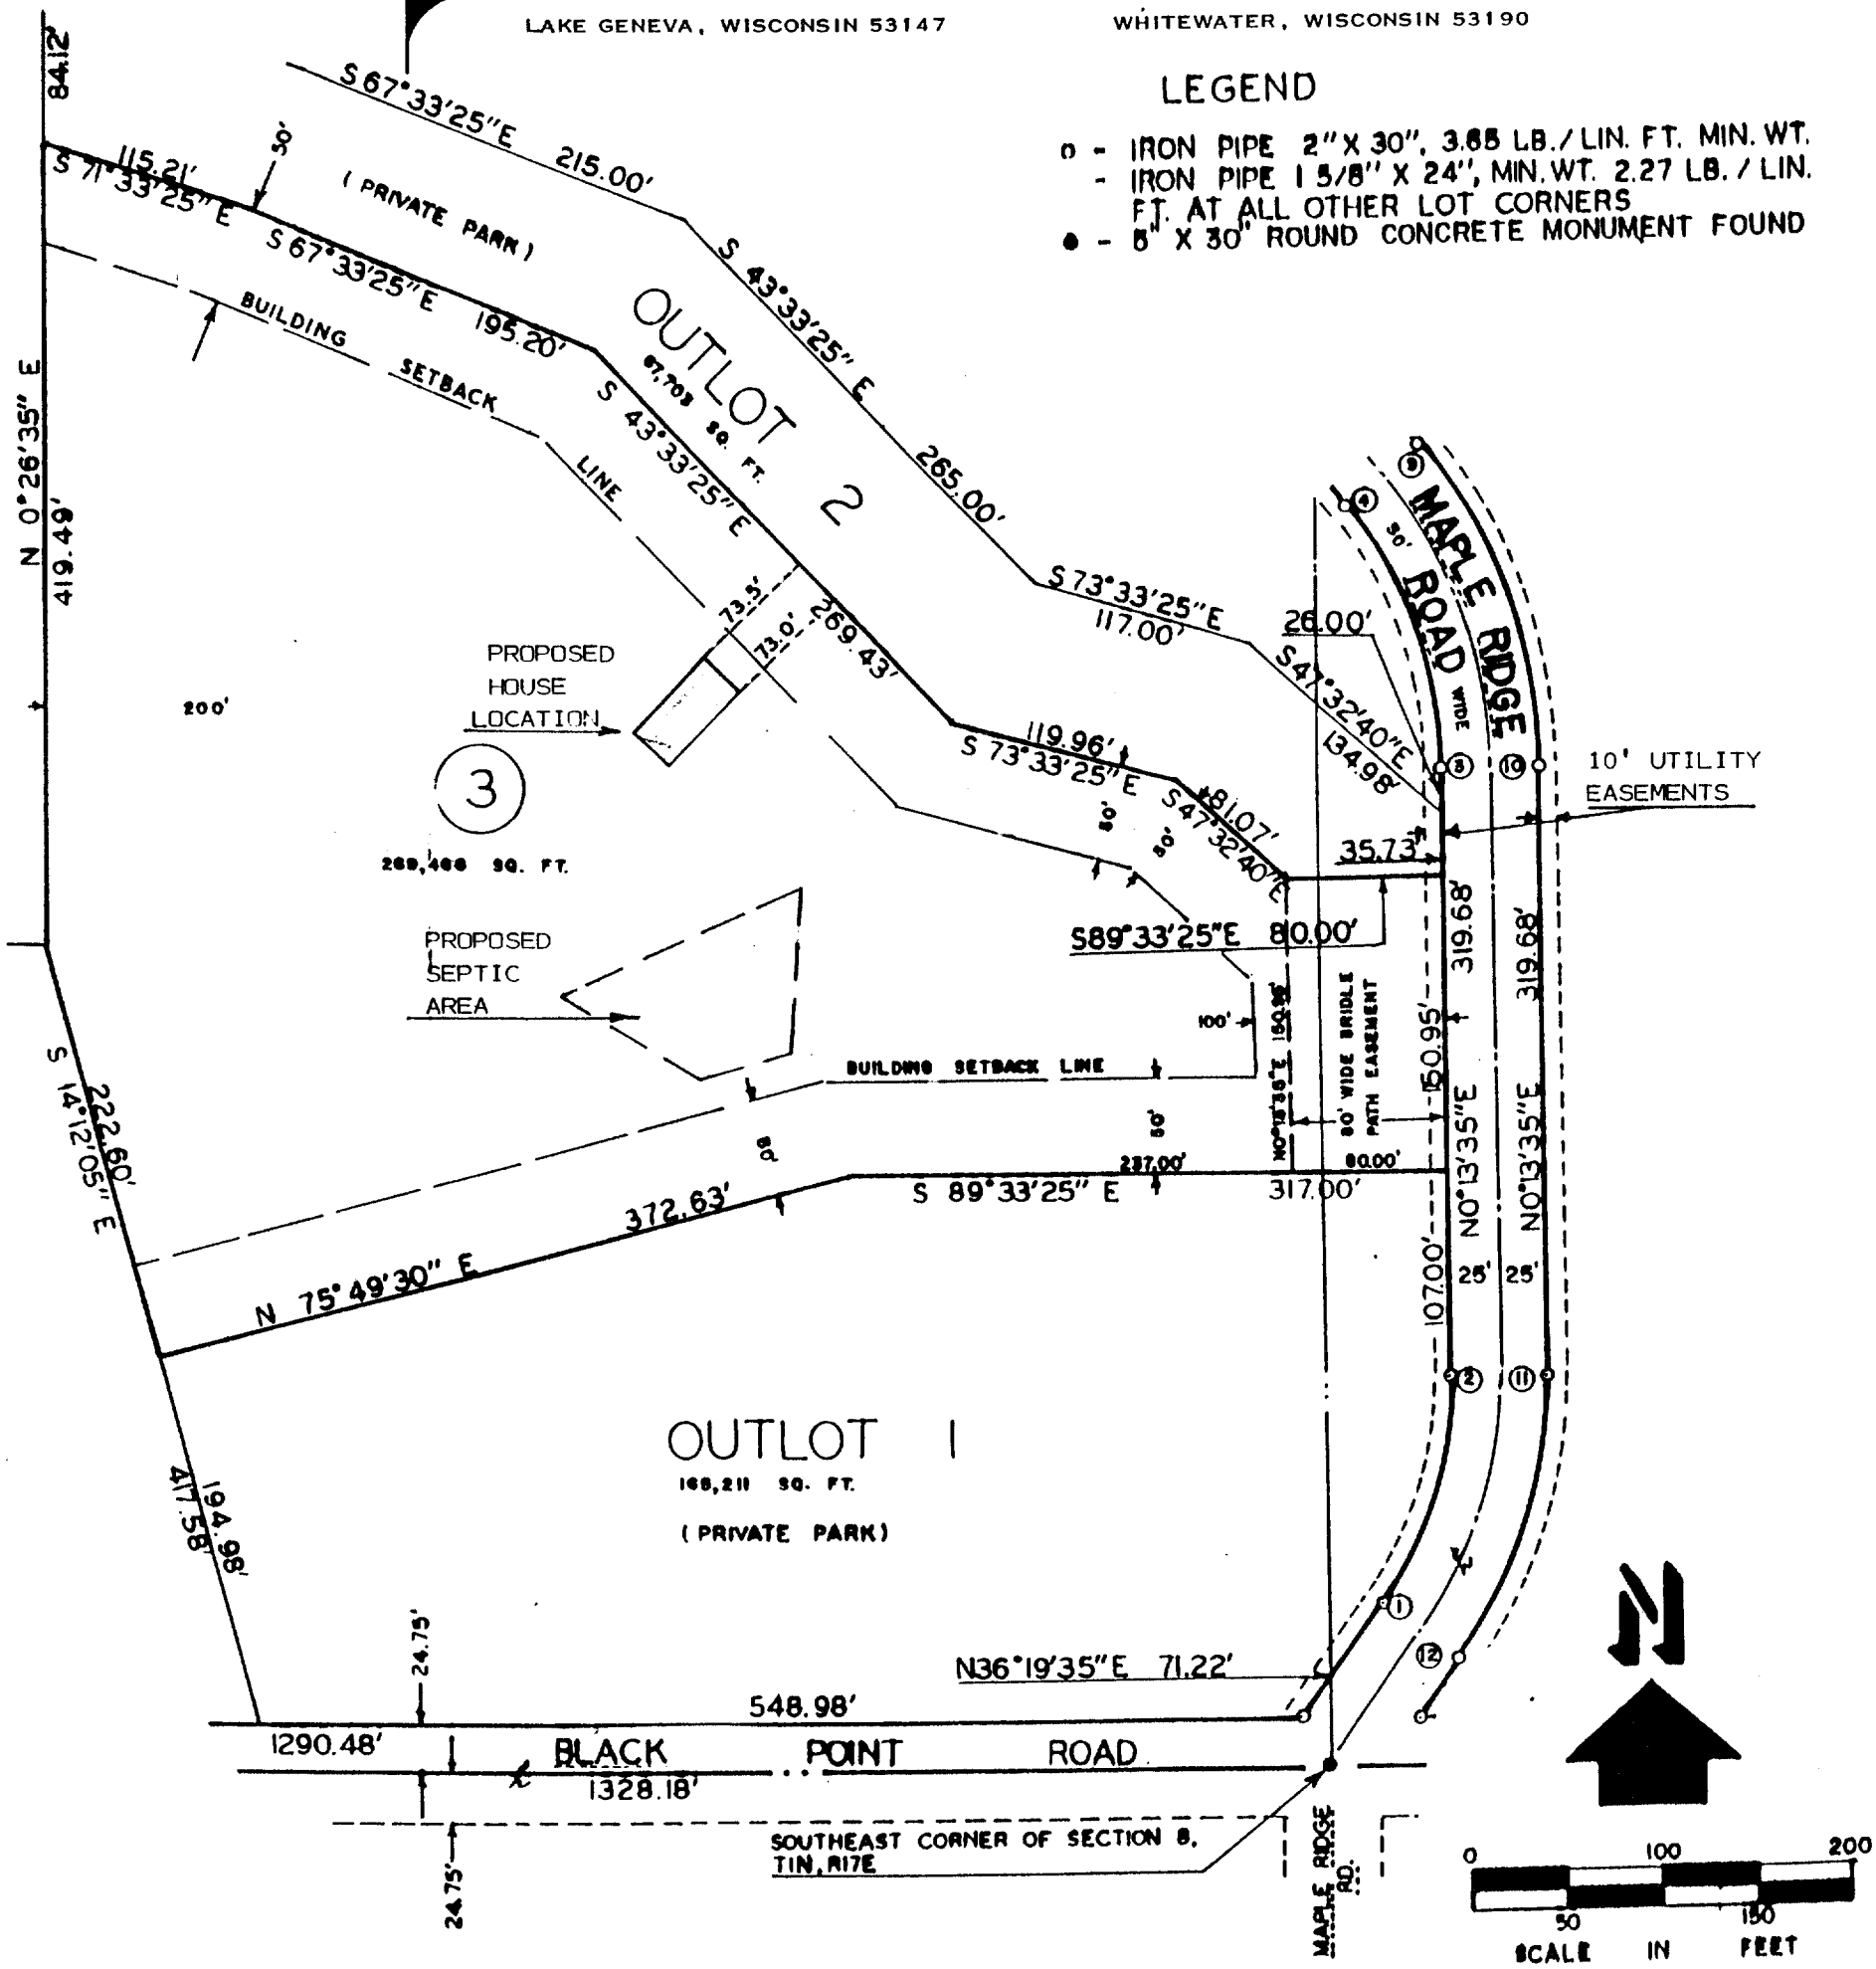

PLAT OF SURVEY OF

LOT 3, BLACK POINT FARM, A SUBDIVISION LOCATED
IN THE SE 1/4 OF SECTION 8 AND THE SW 1/4 OF
SECTION 9, T 1 N, R 17 E, TOWN OF LINN,
WALWORTH COUNTY, WISCONSIN

ORDERED BY: PETER KING
8/19/91 157 3RD AVE.
FONTANA, WI. 53125

NOTE: BEARING ON THE SOUTH LINE OF SEC. 8
ASSUMED TO BE S 89°33'25" E

ORDERED BY: WILLIAM PETERSEN
1350 ASTER STREET
CHICAGO, IL. 60610

NOTE: ALL CORNERS OF LOT 3 FOUND OR
REPLACED.

I, HAROLD H. KOLB, DO HEREBY CERTIFY THAT
I HAVE SURVEYED THE PROPERTY HEREON DES-
CRIBED ACCORDING TO THE OFFICIAL RECORDS,
AND THAT THE PLAT HEREON IS A CORRECT REP-
RESENTATION OF THE LOT LINES TO THE BEST
OF MY KNOWLEDGE AND BELIEF.

SURVEY NOT VALID UNLESS SURVEYOR'S
SIGNATURE IS IN RED.

HAROLD H. KOLB
WISCONSIN REGISTERED LAND SURVEYOR, S-187
DATE JUNE 27, 1991
REVISED AUGUST 19, 1991

