


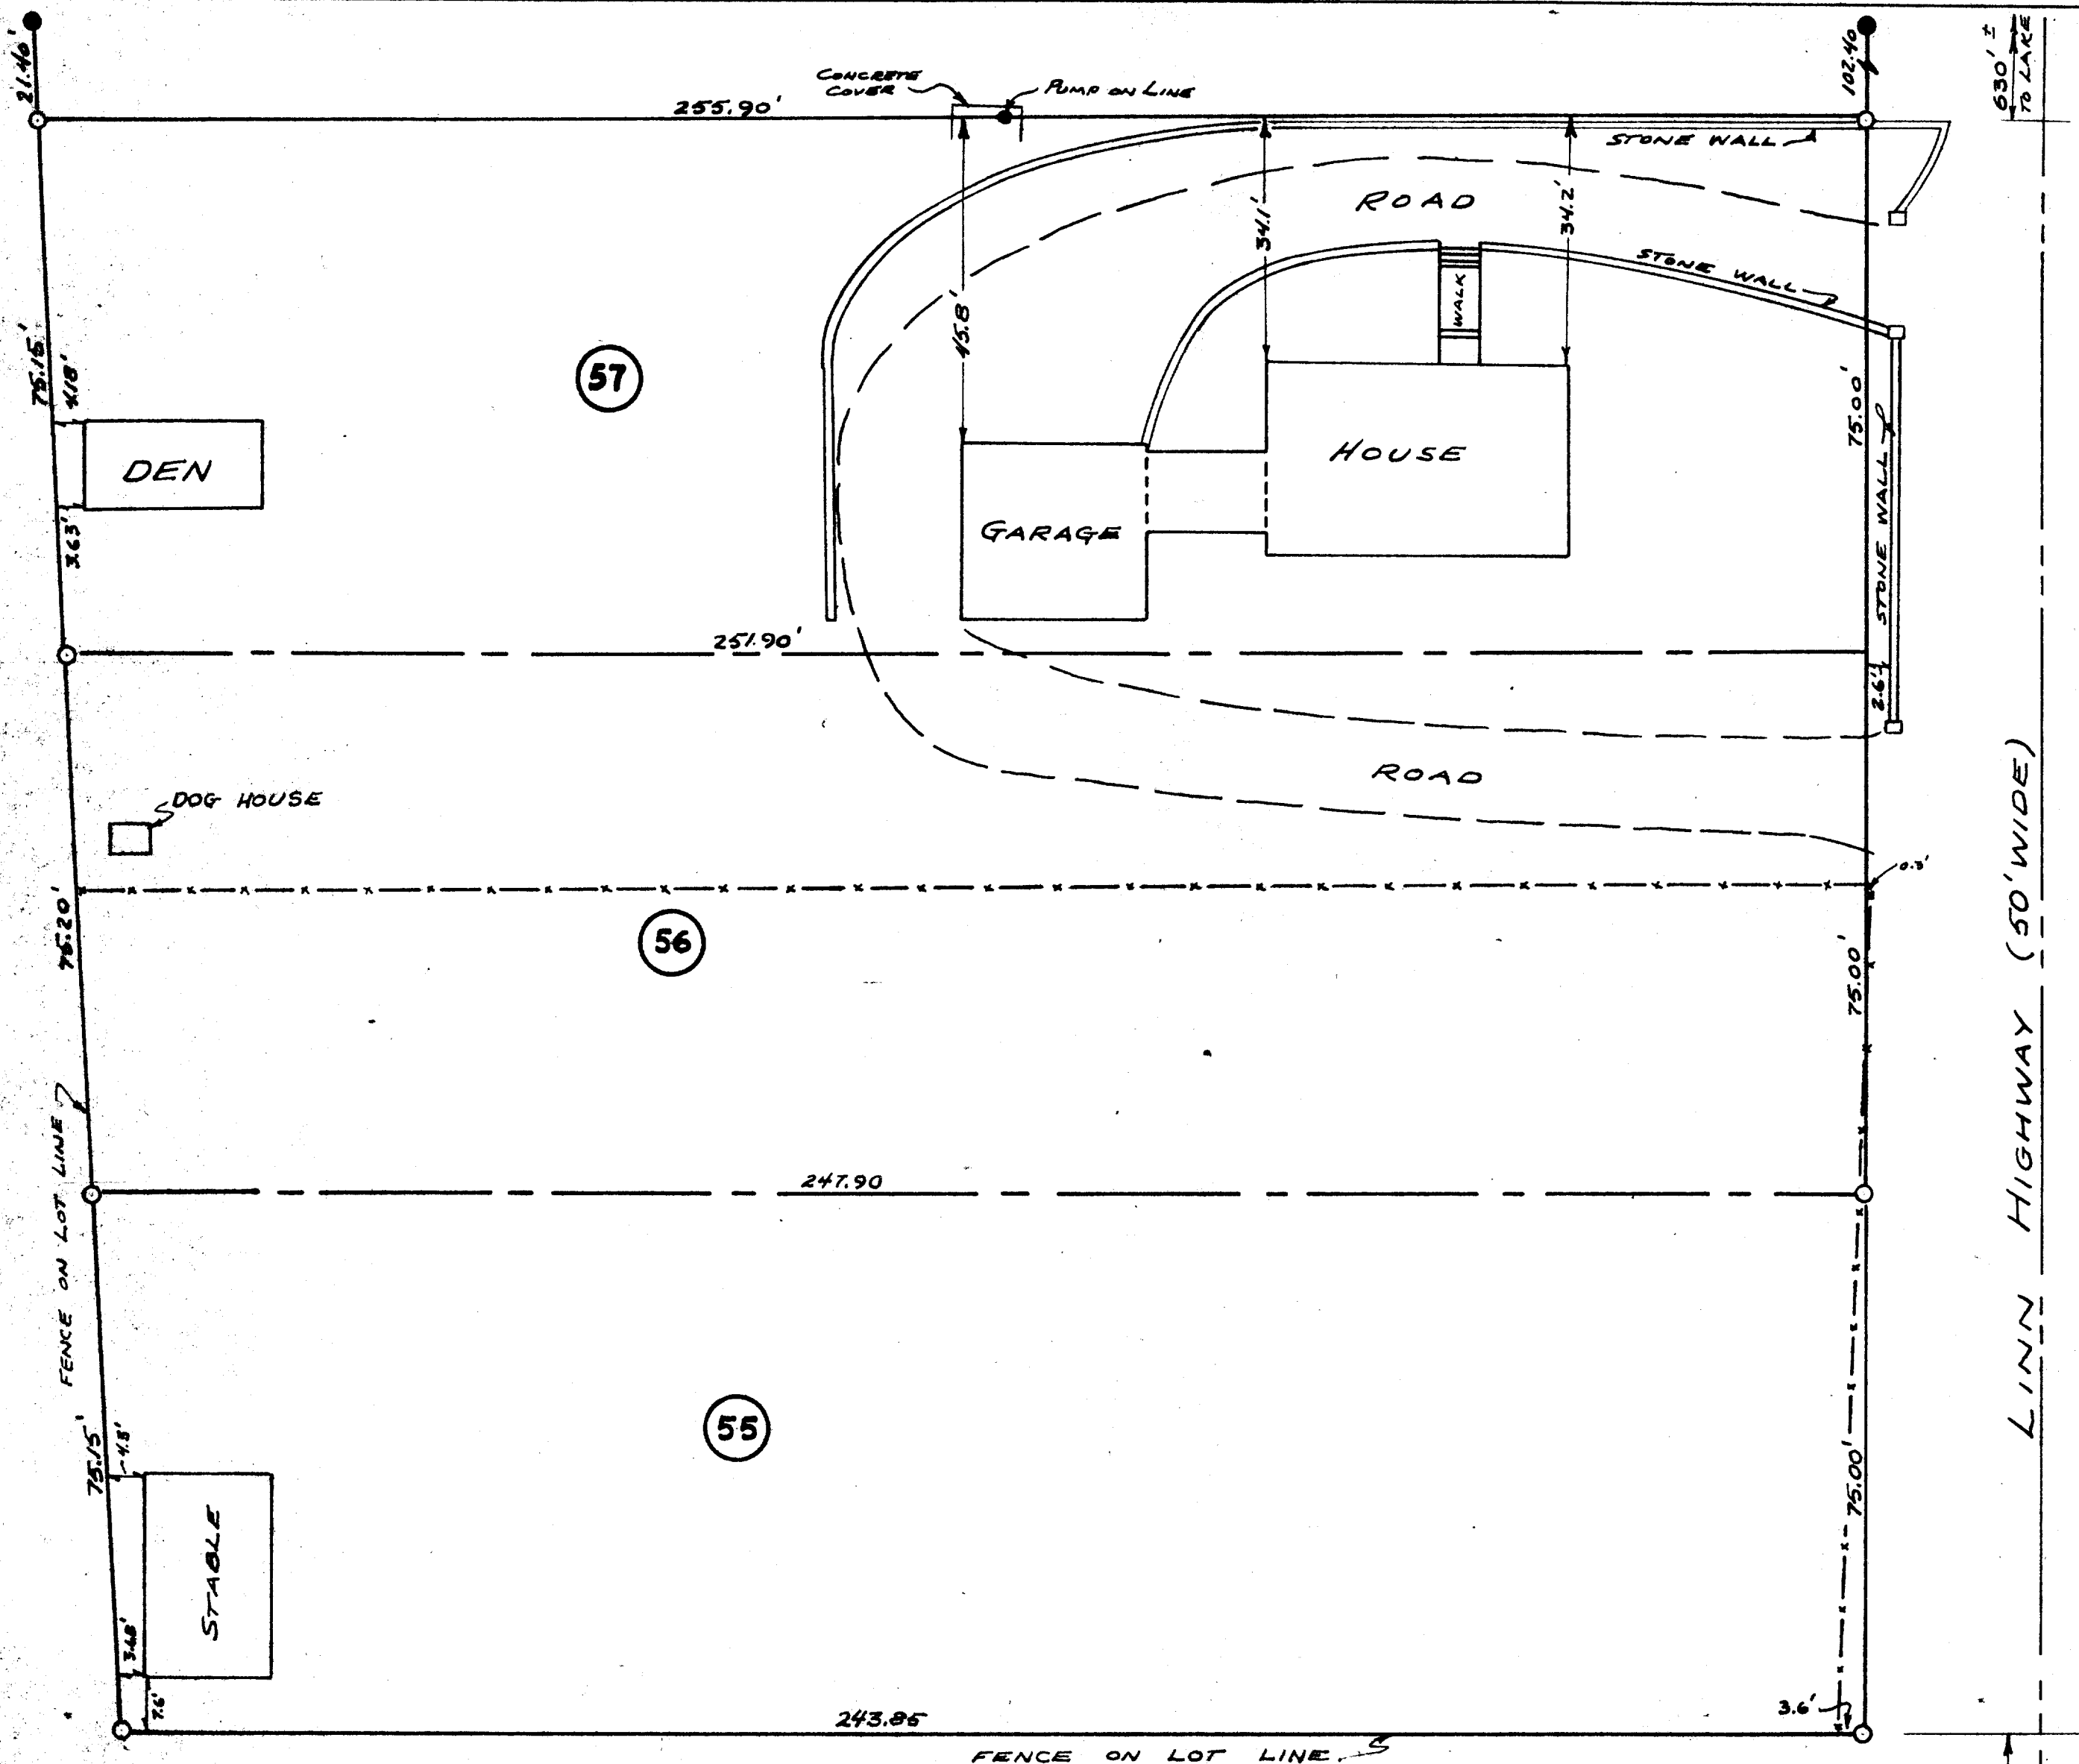

PLAT OF SURVEY OF LOTS 55, 56 AND 57 OF "THE BIRCHES FIRST ADDITION",
 LOCATED IN THE NORTHEAST FRACTIONAL $\frac{1}{4}$ OF SECTION 9, T1N17E OF WAL-
 WORTH COUNTY, WISCONSIN.

STATE OF WISCONSIN)
 COUNTY OF WALWORTH) S.S.

I, Lloyd L. Jensen do hereby certify that I have surveyed the property
 described above according to the official records, and that the plat above is a correct
 representation of the lot lines and principal lines of buildings thereon.

Elkhorn, Wisconsin, December 31, 1951

Lloyd L. Jensen
 LLOYD L. JENSEN, SURVEYOR

SCALE - 1" = 20'

● - CONC. MONU.
 ○ - IRON PIPE
 x - FENCE

IBAT - 38 A