

Block 5

Lot 35: Dimensions: 118.04' (top), 118' (right), 90°15'05" (bottom-left corner). Features: SHED (8.7' x 14.4'), SHED (7.9' x 12.4').

Lot 36: Dimensions: 120.06' (right). Features: SHED (7.9' x 12.4').

Lot 37: Dimensions: 39.95' (left), 118.13' (118') (bottom). Features: RESIDENCE (38.5' x 38.5'), DECK (26.2' x 26.1').

Lot 38: Dimensions: 8.7' (left), 8.7' (right), 118.22' (118') (bottom). Features: GRAVEL DRIVEWAY (37.5' wide).

Lot 39: Dimensions: 118.78' (left), 79.88' (right), 359.34' (360') (left), 118' (right).

Lot 40: Dimensions: 39.87' (right), 118.22' (118') (bottom).


Lot 41: Dimensions: 118.96' (right), 118.32' (118') (bottom).

Lot 42: Dimensions: 118.96' (right), 118.32' (118') (bottom).

Lot 43: Dimensions: 118.32' (118') (bottom), 89°56'40" (bottom-right corner).

Other Features: WOOD FENCE ALONG LINE (left), IRON PIPE 0.11' EAST OF LOT CORNER (top-left), IRON ROD 0.21' WEST OF LOT CORNER (top-right), GRAVEL PARKING AREA (top-right), OVERHEAD UTILITIES ALONG LINE (right), WOODSHED (left, symbol).

ORDERED BY: ASSURED REALTY
50 WEST GENEVA STREET
WILLIAMS BAY, WISCONSIN
53191

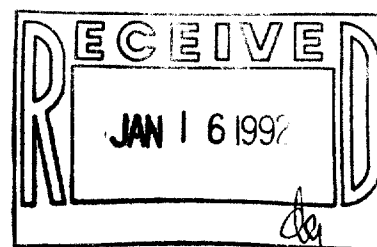

♂ - IRON PIPE FOUND
 ○ - IRON PIPE PLACED
 () - RECORDED AS

HEREOF.

Robert M. Baerenwald
ROBERT M. BAERENWALD
WISCONSIN REGISTERED LAND SURVEYOR, S-1508

DATE Oct. 18, 1990 JOB NO. 2654

NOTE: THIS IS NOT A CERTIFIED COPY UNLESS SEALED.

IMH-126
IMH-127
IMH-127A
IMH-130