

ABELL
SURVEYING & MAPPING

DELAVER, WISCONSIN 53115

414-728-6737

HILL

(HILLTOP ROAD)



SCALE 1"=30'


LEGEND

- ⊙ - IRON PIPE FOUND
- ~ - IRON PIN FOUND
- ⊗ - CONCRETE COVER
- - UTILITY PED
- * - CHAINLINK FENCE
- () - RECORDED AS

PLAT OF SURVEY OF

LOTS 2, 3, 8, AND 9, BLOCK 8, WOODDALE ADDITION,
LOCATED IN T1N. R17E, WALWORTH COUNTY, WISCONSIN.

ORDERED BY: KEEFE REAL ESTATE
704 MAIN STREET
LAKE GENEVA, WI. 53147

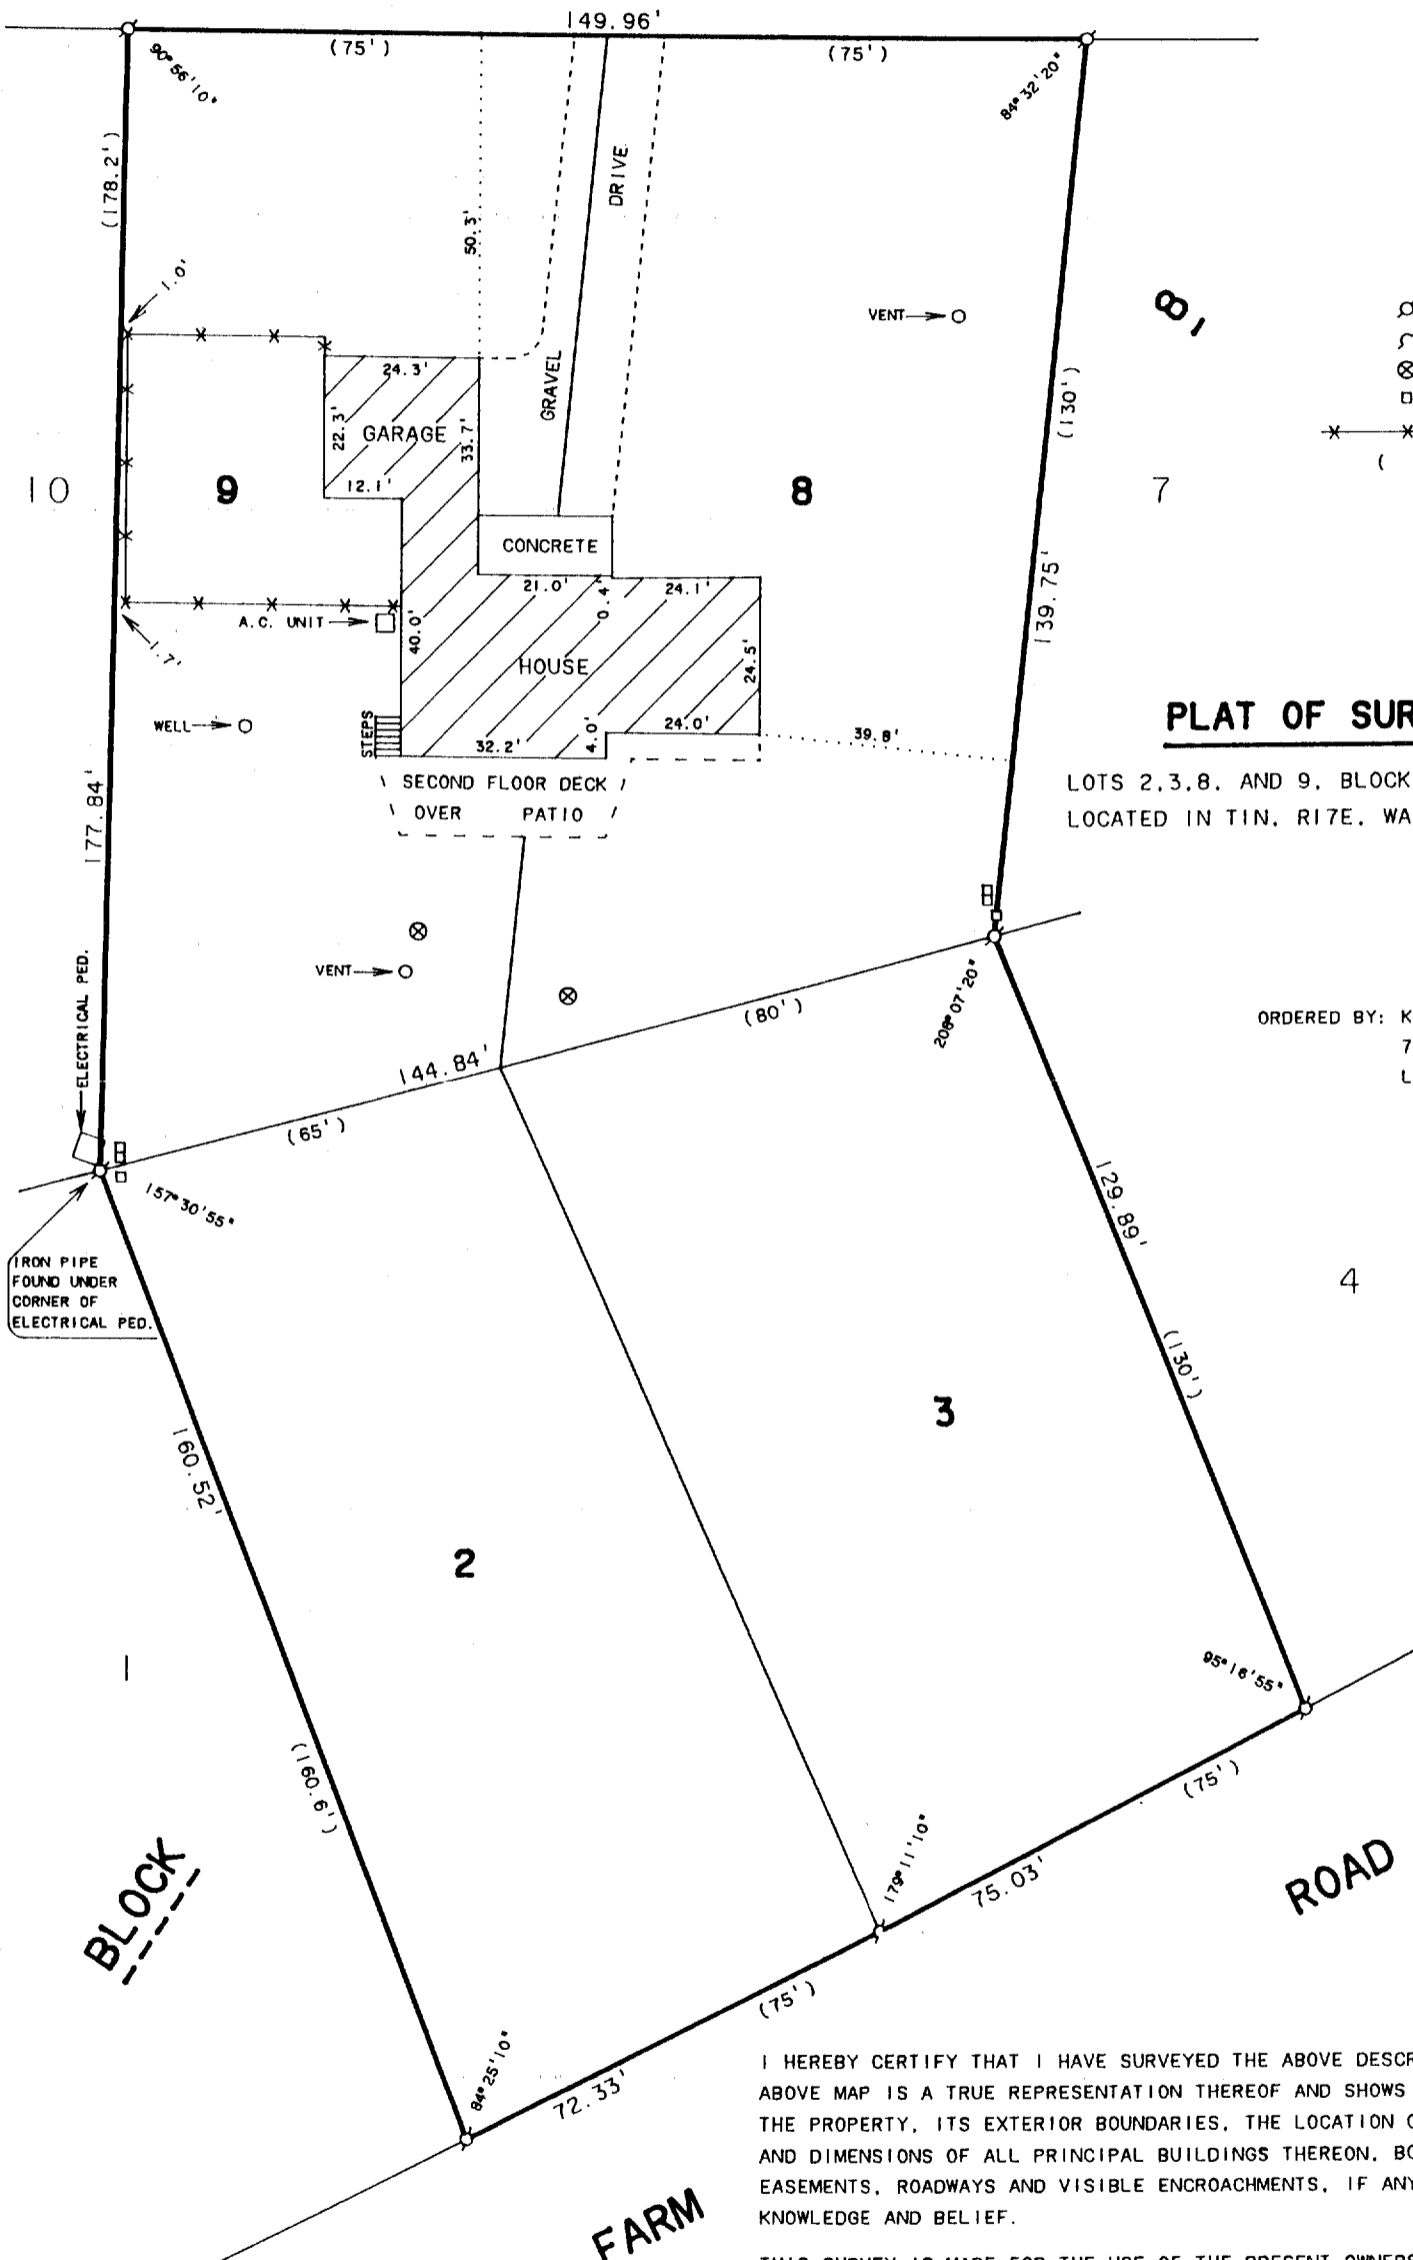

I HEREBY CERTIFY THAT I HAVE SURVEYED THE ABOVE DESCRIBED PROPERTY AND THAT THE ABOVE MAP IS A TRUE REPRESENTATION THEREOF AND SHOWS THE SIZE AND LOCATION OF THE PROPERTY, ITS EXTERIOR BOUNDARIES, THE LOCATION OF ALL VISIBLE STRUCTURES AND DIMENSIONS OF ALL PRINCIPAL BUILDINGS THEREON, BOUNDARY FENCES, APPARENT EASEMENTS, ROADWAYS AND VISIBLE ENCROACHMENTS, IF ANY, TO THE BEST OF MY KNOWLEDGE AND BELIEF.

THIS SURVEY IS MADE FOR THE USE OF THE PRESENT OWNERS OF THE PROPERTY, AND ALSO THOSE WHO PURCHASE, MORTGAGE, OR GUARANTEE THE TITLE THERETO WITHIN ONE (1) YEAR FROM DATE HEREOF.

David F. Abell

DAVID F. ABELL

WISCONSIN REGISTERED LAND SURVEYOR, S-1596

December 12, 1991

DATE

JOB NUMBER - 91261

NOTE: THIS IS NOT A CERTIFIED COPY UNLESS SEALED.

