


LAND SURVEYING · SUBDIVIDING · LAND PLANNING

PLAT OF SURVEY OF

NE CORNER
SEC. 16-1-17

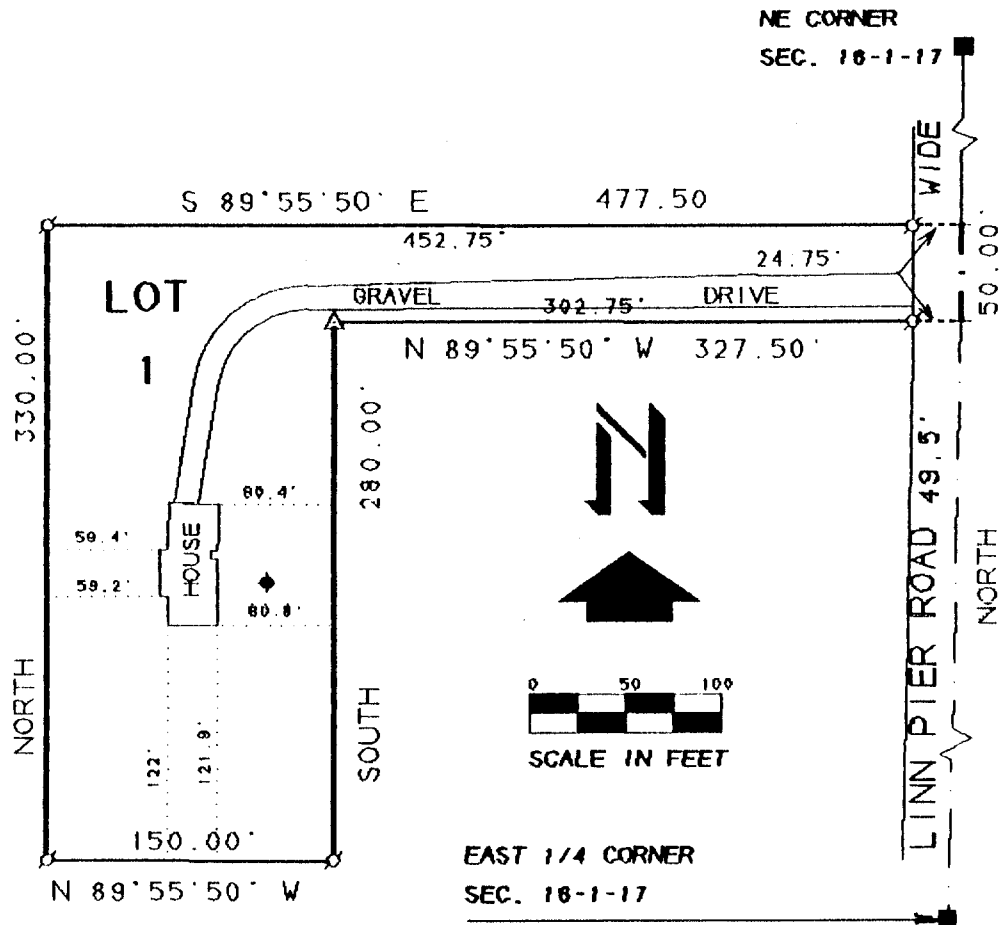

RECEIVED
MAR 12 1992

DATE: JUNE 18, 1991