



PLAT OF SURVEY

LOTS 16 THRU 21 OF BLOCK I
KUEBKER'S ADDITION
SEC. 28, T. 1 N., R. 17 E.
WALWORTH COUNTY, WI.

ASSIGNED EAST LINE PLEASANT STREET
N 00° 00' E

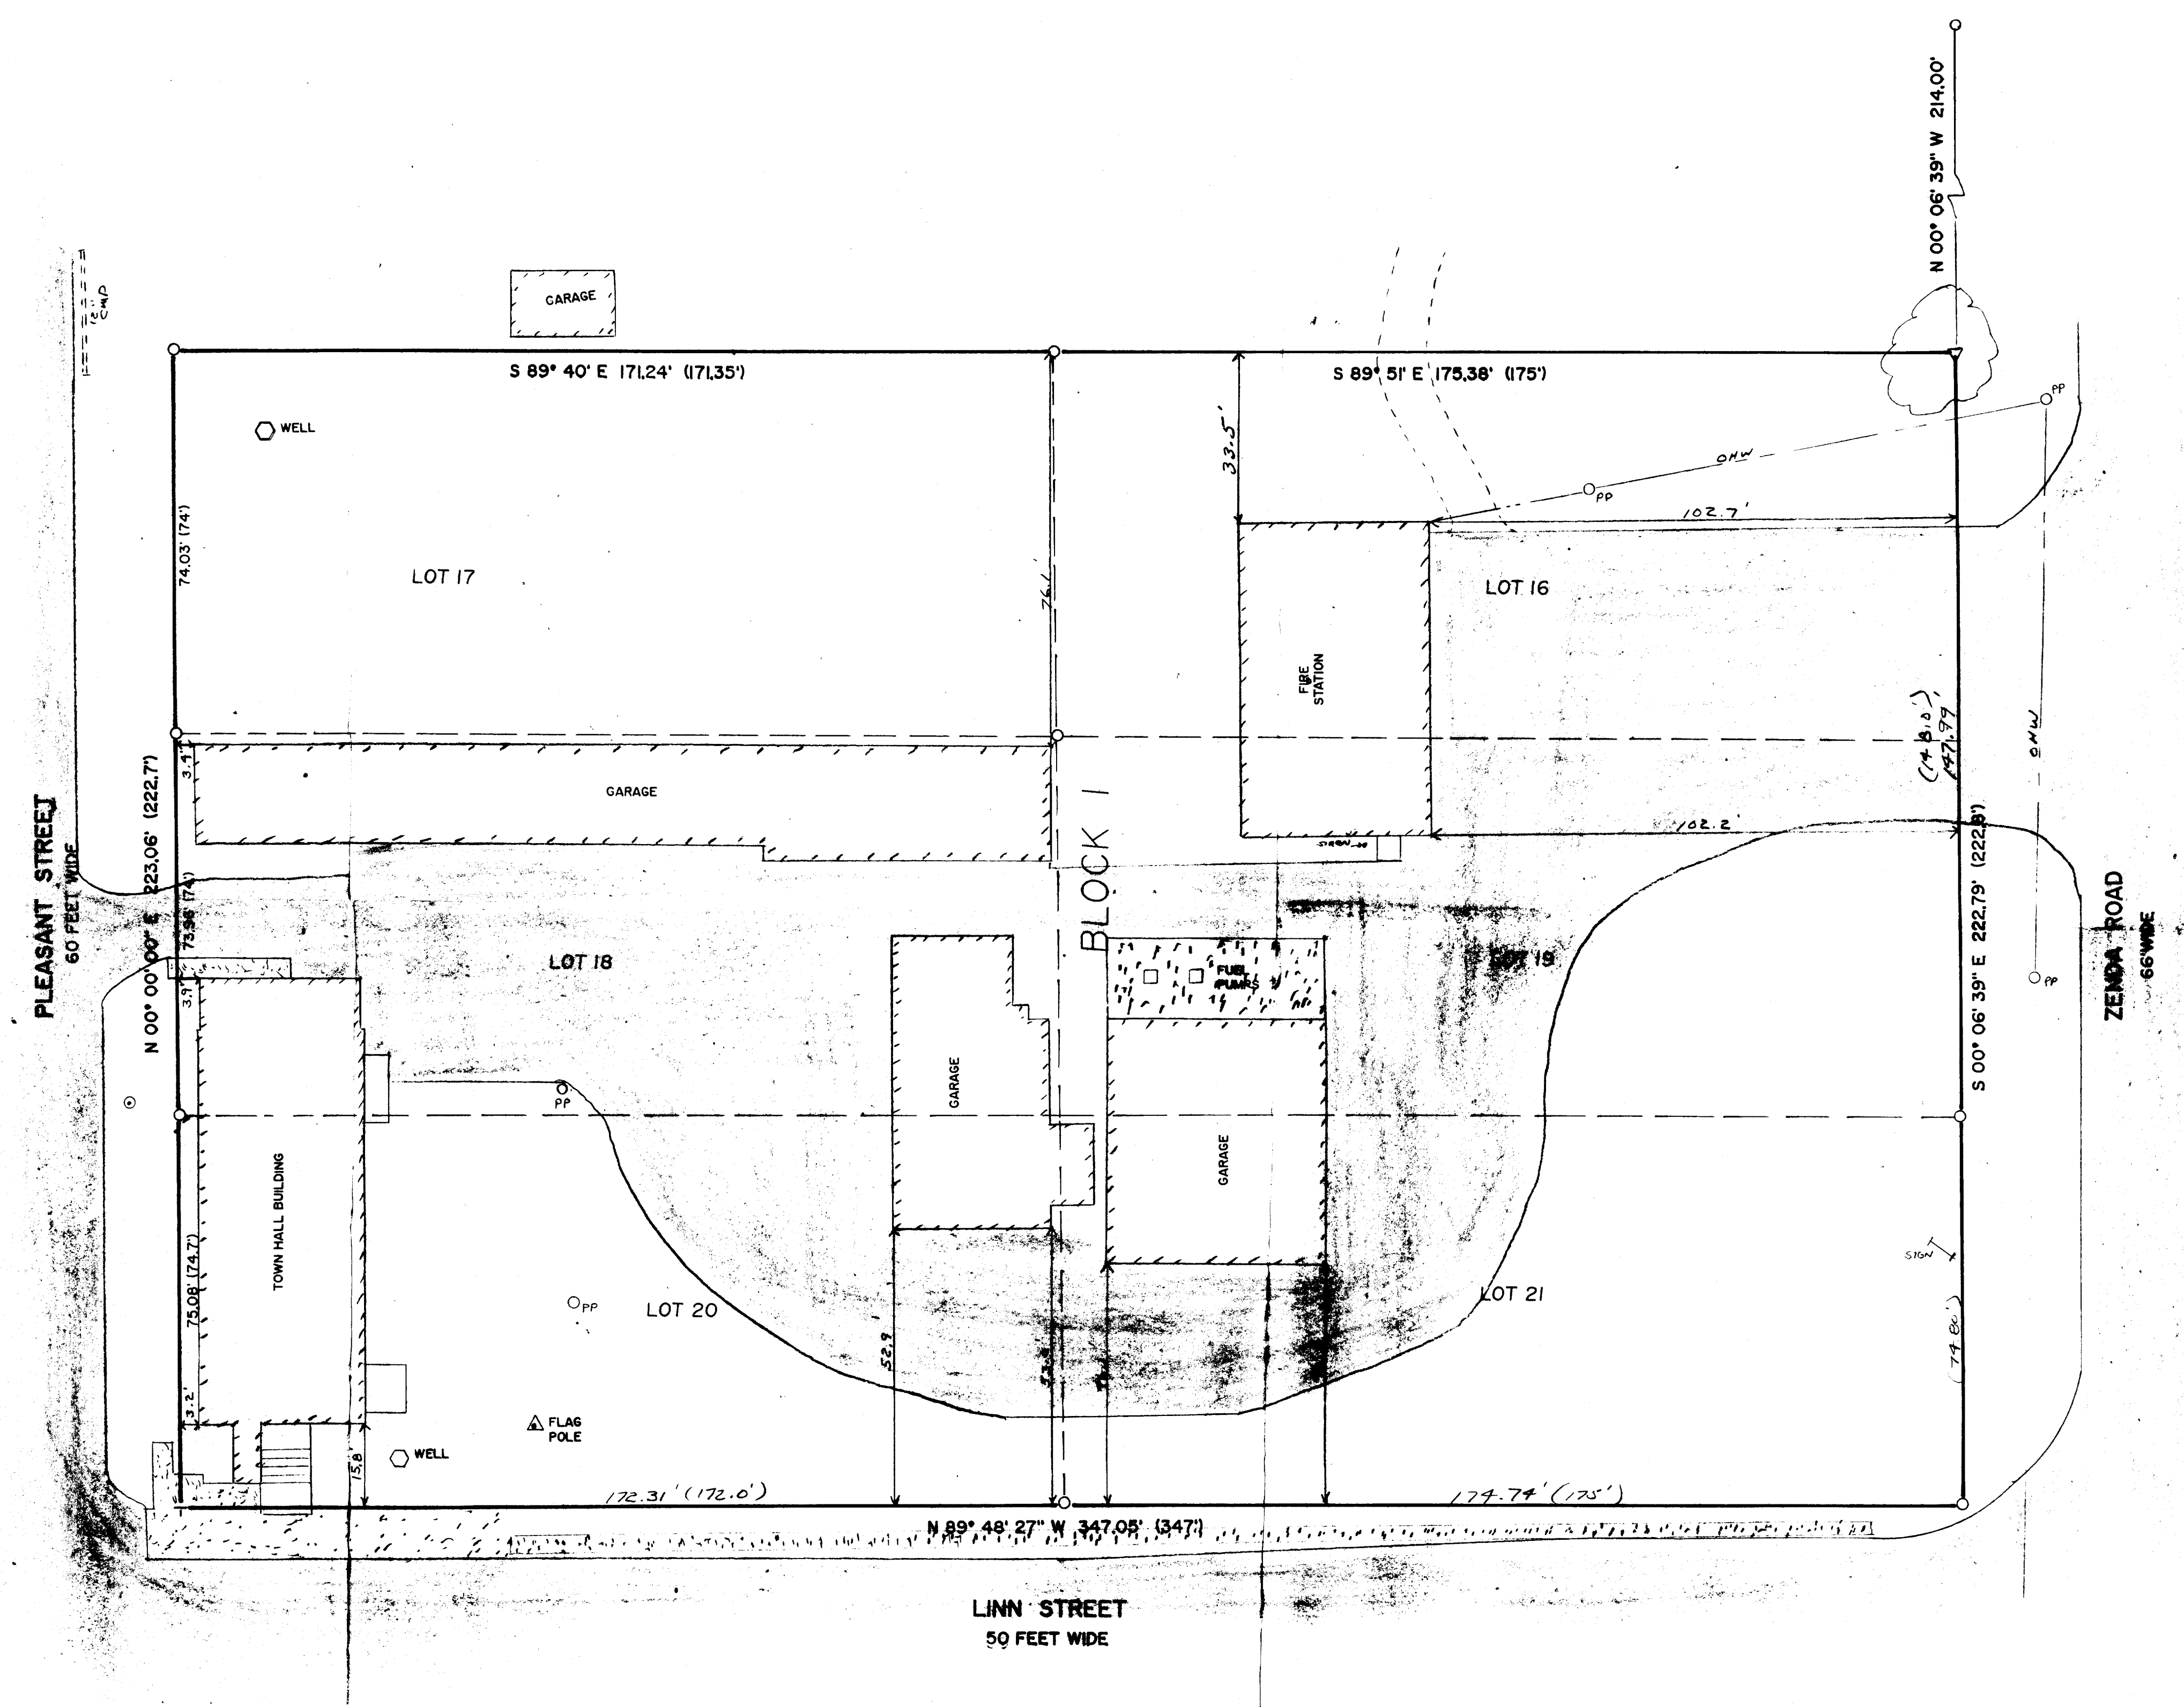



LEGEND
○ = FOUND IRON PIPE STAKE
▽ = SET NAIL IN ROOT OF MAPLE TREE
+ = POINT IN CONCRETE WALK
NO MONUMENT SET
(X X X) = RECORDED AS

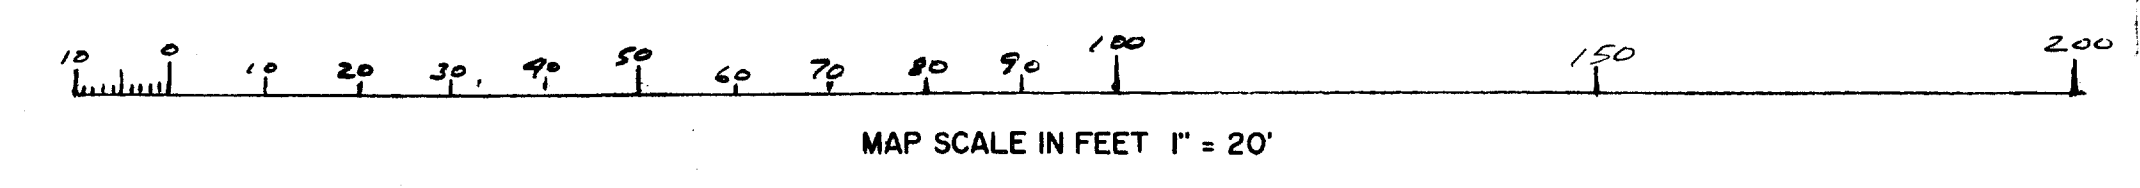

NOTE: COPIES OF THIS MAP TO WHICH THE FOLLOWING CERTIFICATE WILL APPLY ARE BLUE LINE PRINTS SHOWING SURVEYOR'S ORIGINAL SEAL AND SIGNATURE IN BLACK INK. COPIES BY ANY OTHER MEANS MAY HAVE ALTERATIONS WHICH DO NOT REPRESENT THE SURVEYOR'S WORK PRODUCT.

I HEREBY CERTIFY THAT THIS PLAT OF SURVEY IS A TRUE AND ACCURATE REPRESENTATION OF THE BOUNDARY LINES OF THE SUBJECT PARCEL TO THE BEST OF MY KNOWLEDGE AND BELIEF. THIS SURVEY IS MADE FOR THE USE OF THE PRESENT OWNERS OF THE PROPERTY, ID ALSO THOSE WHO PURCHASE, MORTGAGE, OR GUARANTEE THE TITLE THEREO WITHIN ONE YEAR FROM THE DATE HEREOF.

DATED: 08/03/1993
PETER S. GORDON RLS 2101

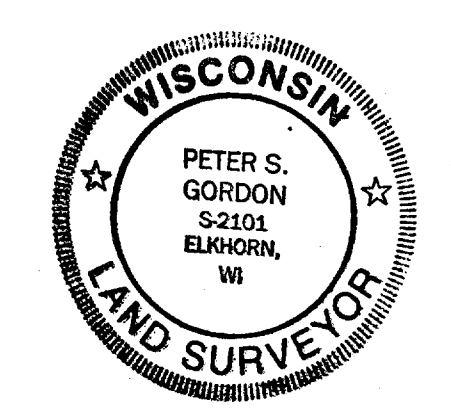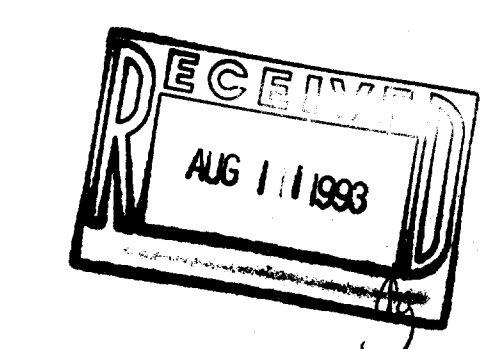

PLAT OF SURVEY
LOTS 16 THRU 21 OF BLOCK I
KUEBKER'S ADDITION
SEC. 28, T. 1 N., R. 17 E.
WALWORTH COUNTY, WI.

WORK ORDERED BY:
EUGENE BEHRENS
TOWN OF LINN
BOX 130
ZENDA, WI

FARRIS, HANSEN & ASSOCIATES, INC.
Engineering, Architecture, Surveying
7 Ridgway Court P.O. Box 437
ELKHORN, WISCONSIN 53121
Office: (414) 723-2098
Fax: (414) 723-8886

REVISIONS	
PROJECT NO.	3892
DATE	08/02/1993
SHEET NO.	1 OF 1

12K-6 12K-6A