

ABERNATHY and ASSOCIATES


Kenneth B. Abernathy Jr.

Wisconsin Registered Land Surveyor S-1594

W4056 Bray Road
Elkhorn, Wisconsin 53121
Phone (414) 723-4260 (office)
(414) 723-4813 (residence)

PLAT OF SURVEY

Lot 2 of Certified Survey Map Number 675, located
in part of the Northeast 1/4 of Section 5,
Town 1 North, Range 17 East, Town of Linn,
Walworth County, Wisconsin.

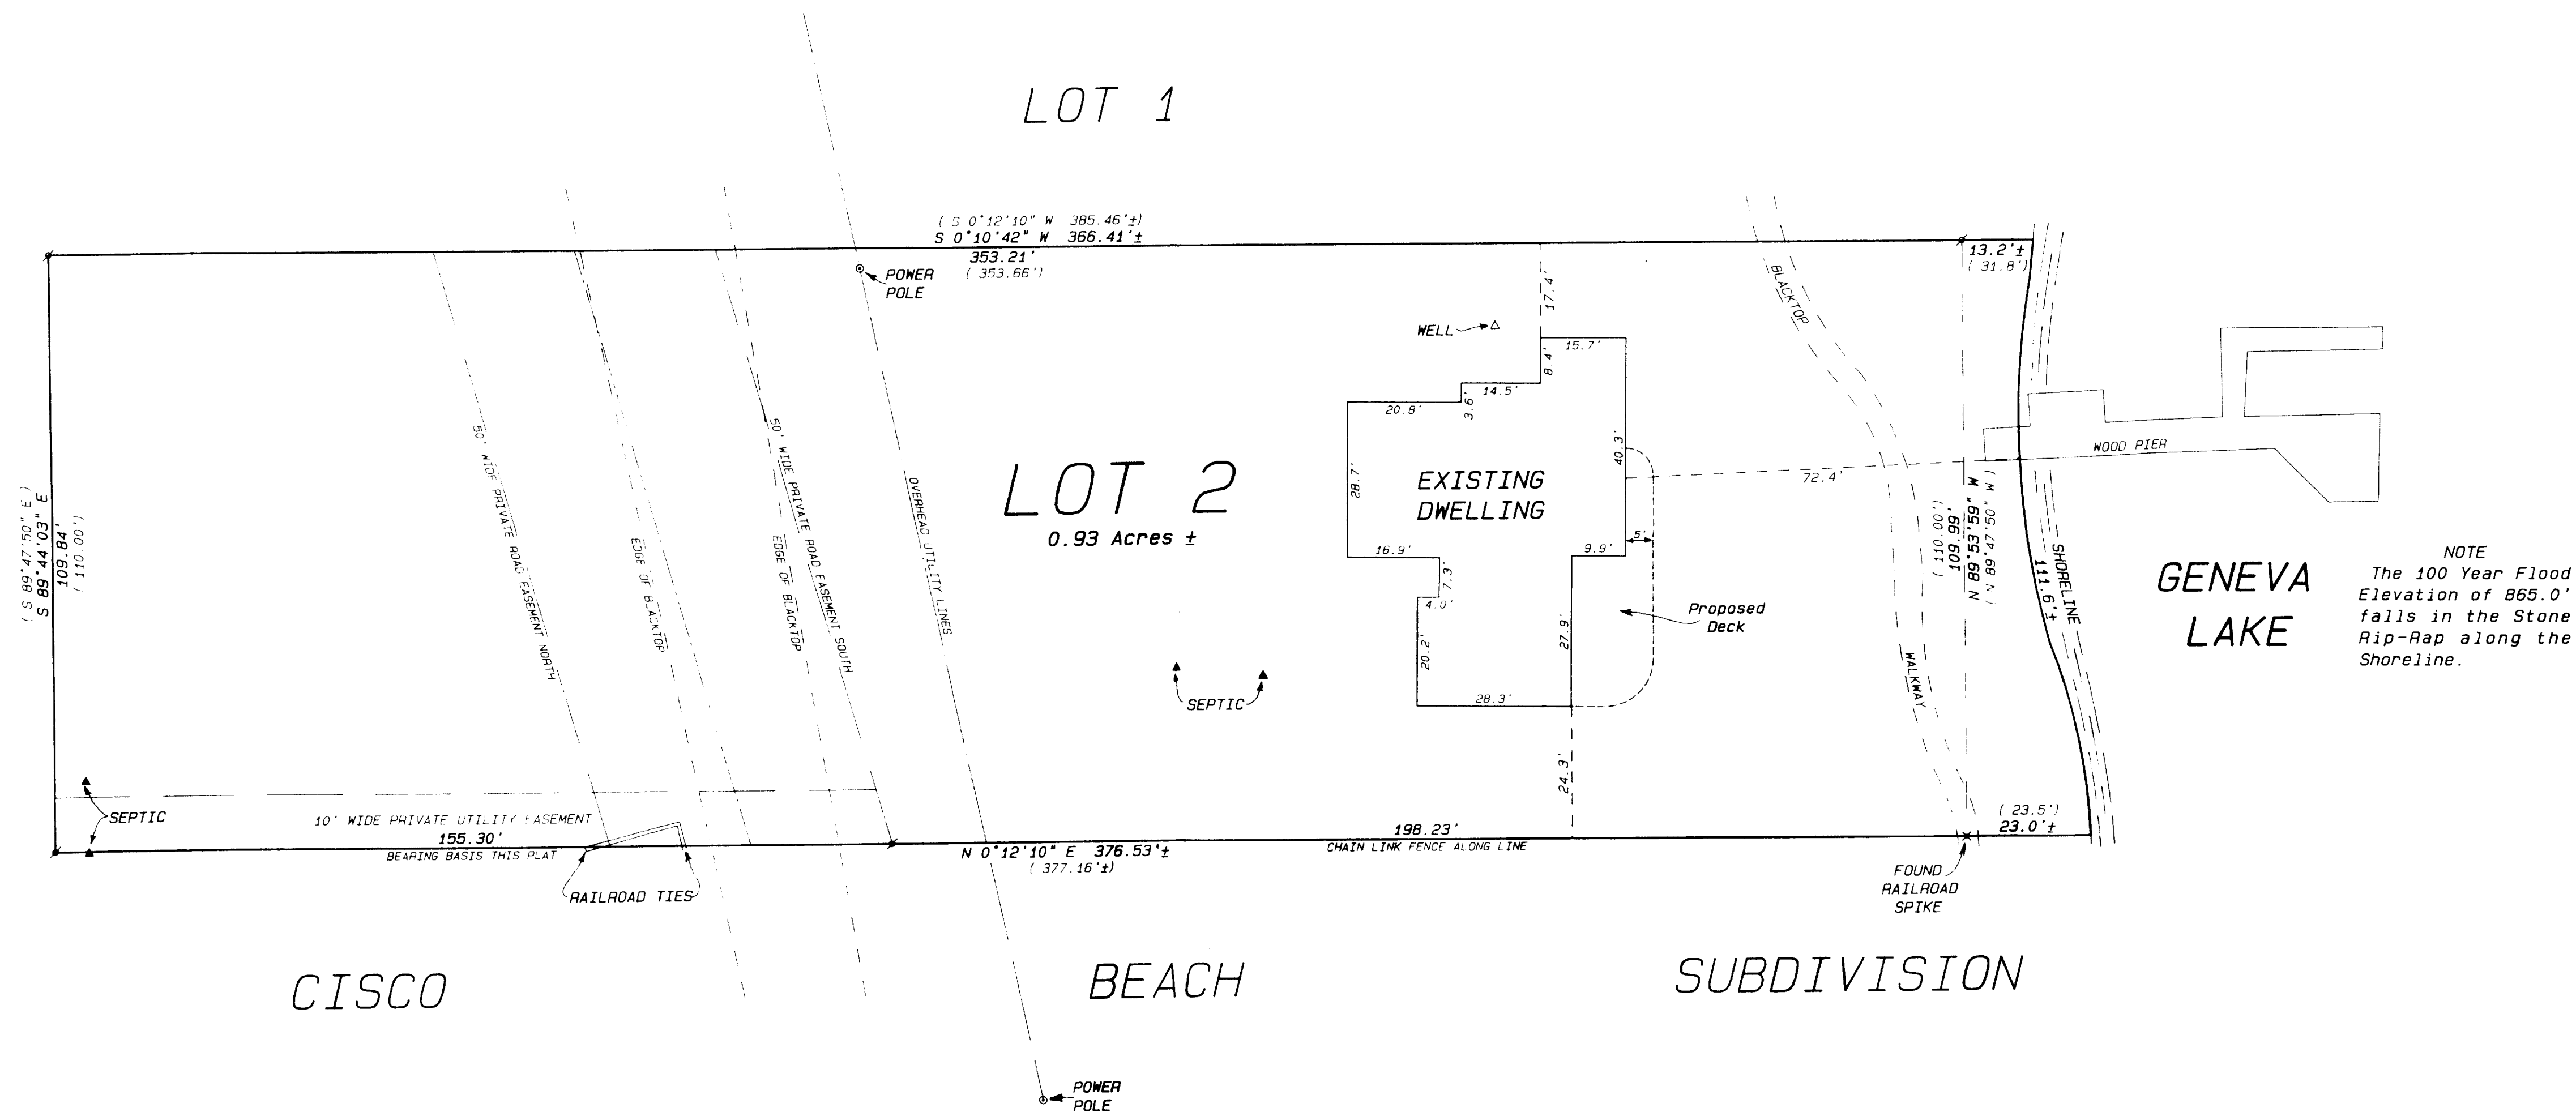

NOTE
The 100 Year Flood
Elevation of 865.0'
falls in the Stone
Rip-Rap along the
Shoreline.

Ordered by: Dale Castleman
B & J Tree & Landscape Service, Inc.
W3041 Kruger Road
Lake Geneva, Wisconsin 53546

Owners: Robert & Karol Karlblom
559 Westminster
Lake Forest, Illinois 60045


NOTE
Subject to easements
recorded or unrecorded.

Legend

- FOUND IRON PIPE
- FOUND IRON ROD
- FOUND BRASS LAPPED MONUMENT
- FOUND CONCRETE MONUMENT
- CHISEL CUT IN CONCRETE
- SET IRON ROD, 24" LONG, WEIGHING 1.5 LBS. LINEAL FT. 3/4" DIA.
- SET IRON ROD, 30" LONG, WEIGHING 4.5 LBS. LINEAL FT. 1 1/16" DIA.
- RECORDED AS DIMENSION
- EXISTING FENCE



SCALE: 1"= 20 FEET

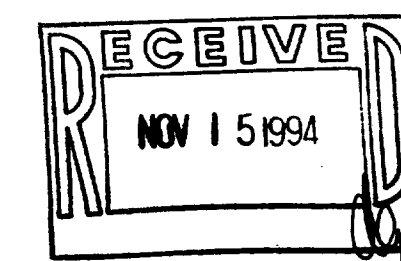

I hereby certify that the above described property has been surveyed by me or under my direction and that the above map is a true and correct representation of the survey and shows the size and location of the property, its exterior boundaries, the location of all visible structures and improvements, all principles bounding thereon, boundary lines, apparent easements, railroads and visible encroachments, if any.

This survey is made for the use of the present owners of the property and also those who purchase mortgage or guarantee the debt thereof within one year from date hereof.

Kenneth B. Abernathy, Jr.

KENNETH B. ABERNATHY, JR.
WISCONSIN REGISTERED LAND SURVEYOR, S-1594
Revised November 2, 1994
Date: October 17, 1994 Job No. 1994.922

117-7414