
ABELL SURVEYING & MAPPING DELAVAN, WISCONSIN 53115 414-728-6787

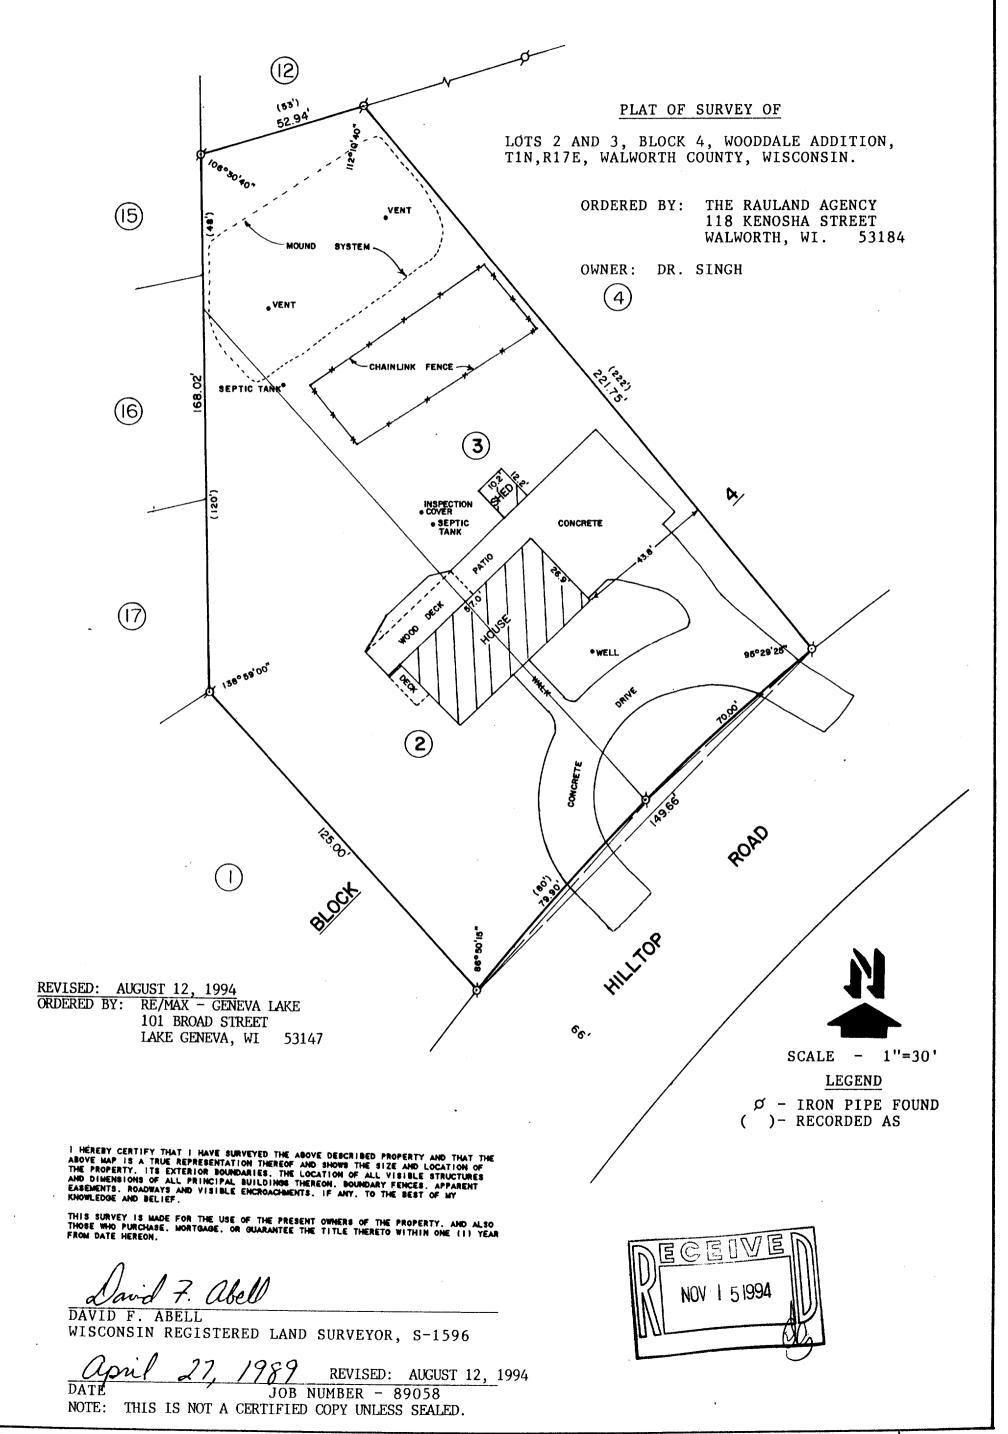

IW-44