


GENEYA LAKE

CONCRETE MONUMENT SET BY W^M CHILDS
IN 1927 ON LINE BETWEEN GOVERN-
MENT LOTS 2 AND 3, LOCATION
AFFIRMED BY SUPREME COURT
OF WISCONSIN IN AUGUST 1930.

FOUND IRON PIPE SET AS SHOWN
IN DESC. OF N.M. & N.A.
LOCATED 1 1/2 RODS E. OF WEST
LINE OF LOT 3.

N.W. CORNER OF GOVERN. LOT 3
FOUND CEDAR STAKE, REPLACED
WITH CONC. MONU.

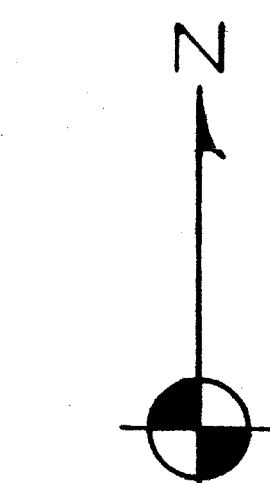

SCALE 1"=50'
O=IRON PIPE
●=CONC. MONU.

PLAT OF SURVEY WORK ON GOVERNMENT LOTS 2 AND 3
SECTION 16, T19N R17E OF WALWORTH COUNTY
WISCONSIN
J. R. SLATTERY
COUNTY SURVEYOR
1943

1/4 SECTION CORNER LOCATED,
PLACED CONC. MONU. AS A MARKER.
S.W. COR. OF GOVERN. LOT NO. 3.

MIDDLE 1/4 SECTION CORNER OF
SECTION 16, T19N R17E, AS SET BY
FORMER SURVEYORS LOCATION
AFFIRMED BY SUPREME COURT OF WIS.
IN AUGUST 1930.

FOUND IRON PIPE SET BY SURVEYOR (?)
AS 1 1/2 RODS EAST OF S.W. COR. OF
LOT NO. 3

FOUND IRON PIPE SET AT 1/4
SECTION CORNER, REPLACED
WITH CONCRETE MONUMENT.
SOUTHEAST CORNER OF
GOVERNMENT LOT NO. 2

