

# Plat of Survey

of  
Lot 9 and Lot 10 in Block 7 of Genevista Subdivision, located in the Southwest 1/4 of  
Section 10, Town 1 North, Range 17 East, Town of Linn, Walworth County, Wisconsin.

Surveyed for:

**Edward P. Cremerius**

Cremerius & Associates  
236 East Northwest Highway  
Palatine, Illinois. 60067

## Oakrest Avenue

(50' Wide)

N 89°47'16" E 116.51

Metal O  
Cover

House

Well

Garage

Alley  
N 00°14'11" E 150.00  
(16' Wide)

Lot 8

Lot 9

Lot 10

B L O C K 7

Alley  
N 89°47'16" E 115.89  
(16' Wide)

Note: This survey plat is not  
certified unless signed  
and sealed in red ink.

Copy \_\_\_\_\_ of \_\_\_\_\_.

Lawrence's Addition  
to Genevista

JUL 29 1996

Copyright © 1995 by Jensen Surveying & Mapping S.C.

All rights reserved. No part of this survey plat may be reproduced  
or transmitted in any form by any means - graphic, electronic, or  
mechanical, including photocopying, tracing, or information storage  
and retrieval systems - without permission in writing from Thomas  
P.A. Jensen, Jensen Surveying & Mapping S.C..

I, Thomas P.A. Jensen, Wisconsin Registered Land Surveyor, do  
hereby certify that this survey was performed by me, or under my  
direction in full compliance with the owner's / agent's instructions  
and Chapter A-E 7 of the Wisconsin Administrative Code "Minimum  
Standards for Property Surveys"; and that this map is as accurate  
representation thereof to the best of my knowledge and belief.

Date: Sept 1995

Thomas P.A. Jensen R.L.S. 1084


### Legend

- Found Iron Pipe
- Found P.K. Nail
- ≡ Concrete Surface
- == Blacktop Surface
- ( ) Recorded Information
- Overhead Wires
- ⊗ Utility Pole
- \*\* Fence

**Jensen Surveying & Mapping S.C.**

45 South Wisconsin Street P.O. Box 322  
Elkhorn, Wisconsin. 53121  
Telephone & Facsimile (414) 723-3434

Scale in feet: 1" = 30'

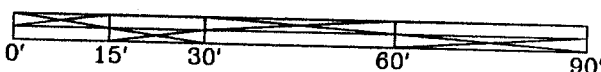

Mapping Date: Sept. 15, 1995.

Revisions:

Sheet 1 of 1 Sheets

Job Reference No.

1995.079

CGV-39  
17-1535