


PLAT OF SURVEY




LOTS 16 AND 17 AND TWO 10 FOOT STRIPS OF LAND ON THE WATER FRONT DESIGNATED AS PARCELS NO. 8 AND 9 OF ALTA VISTA ESTATES, LOCATED IN GOVERNMENT LOT 2, AND IN THE SOUTHEAST 1/4 OF THE NORTHEAST 1/4 OF SECTION 4, TOWN 1 NORTH, RANGE 17 EAST, WALWORTH COUNTY, WISCONSIN.

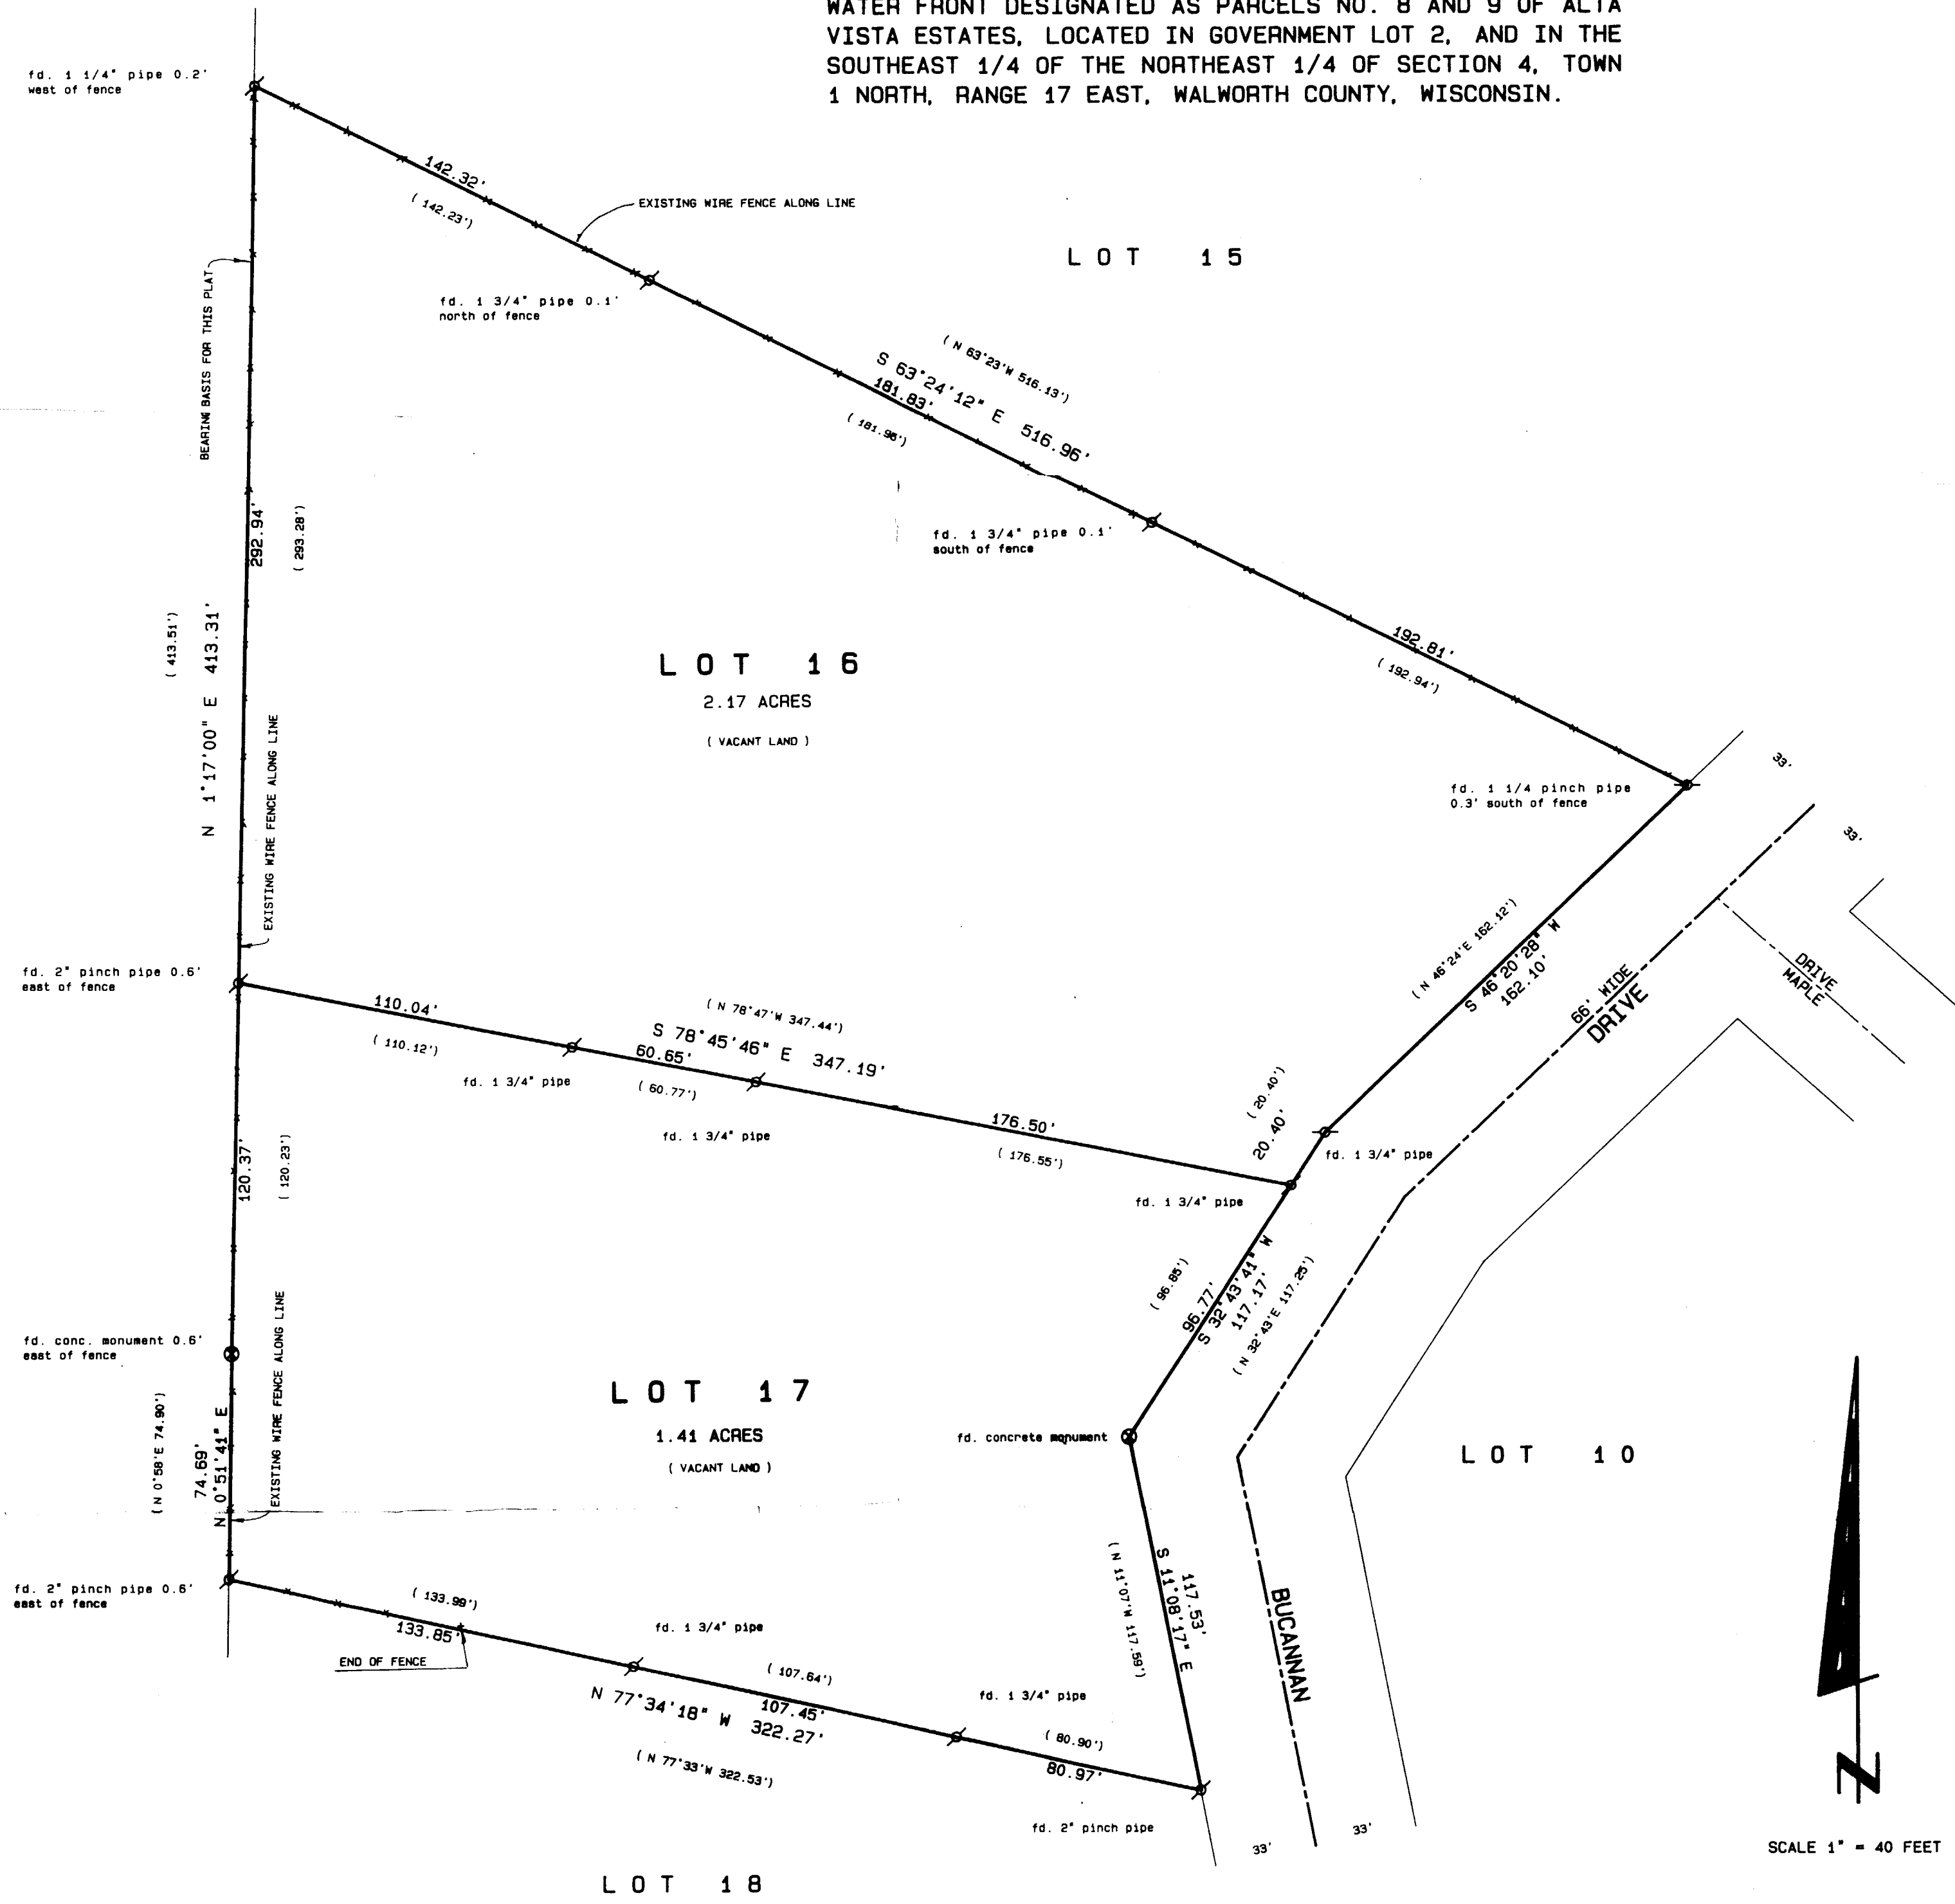

LEGAL DESCRIPTION

WARRANTY DEED RECORDED IN VOL. 619 P. 487 AS DOCUMENT NO. 570600 DATED JUNE 3rd, 1965. ERWIN J JANICKE AND GERDA JANICKE, husband and wife TO RICHARD H. HOWLAND and MARILYN M. HOWLAND, his wife.

OWNERS: RICHARD H. HOWLAND and MARILYN M. HOWLAND
985 FOREST TRAIL
SUGAR GROVE, IL. 60554

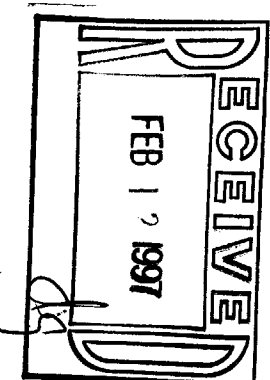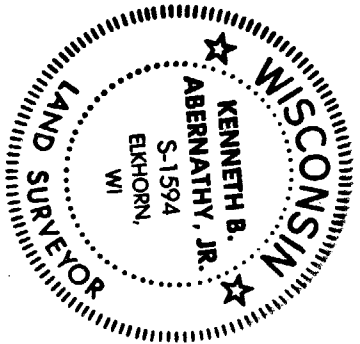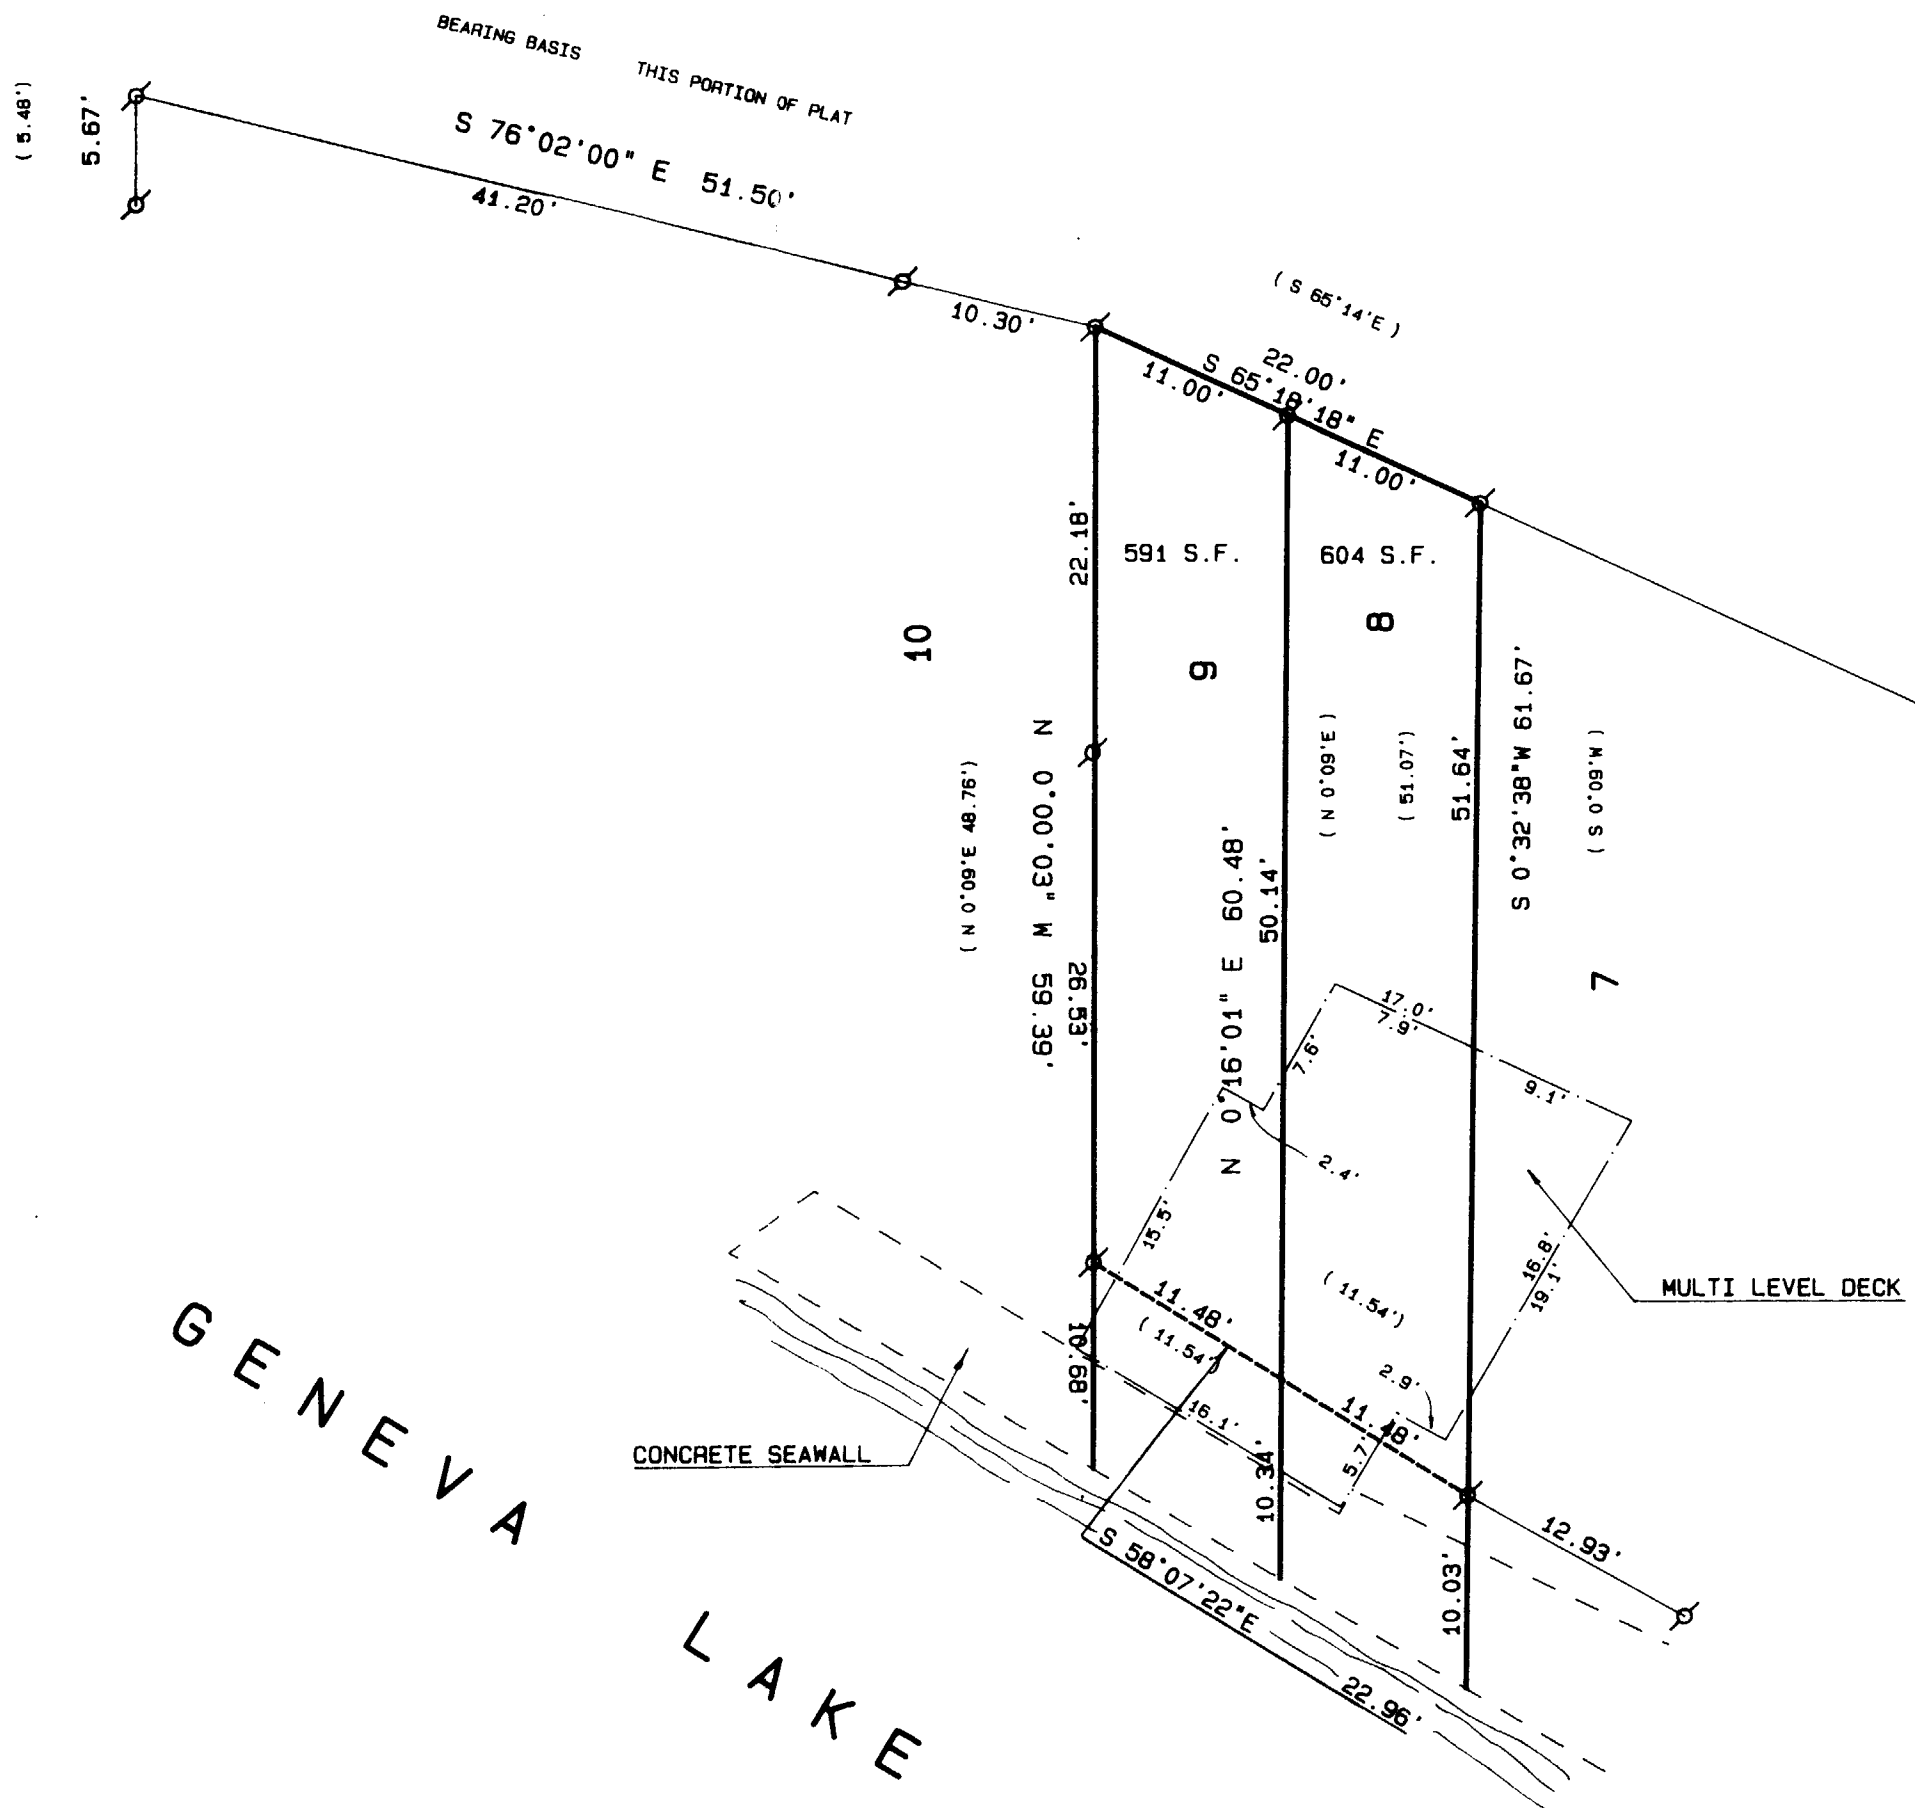

- Legend
- FOUND MON PIPE
 - FOUND MON ROD
 - FOUND MON ROD MONUMENT
 - FOUND CONCRETE MONUMENT
 - CAST IRON MONUMENT
 - SET MON ROD 2" LONG WEIGHING 15 LBS LINEAL FT 1" DIA
 - SET MON ROD 2" LONG WEIGHING 15 LBS LINEAL FT 1" DIA
 - RECORDED AS DIMENSION
 - EXISTING FENCE

SCALE: 1"=40 FEET

Kenneth B. Abernathy, Jr.
WISCONSIN REGISTERED LAND SURVEYOR
S-1594
Date: February 7, 1997 JOB NO. 97-205