


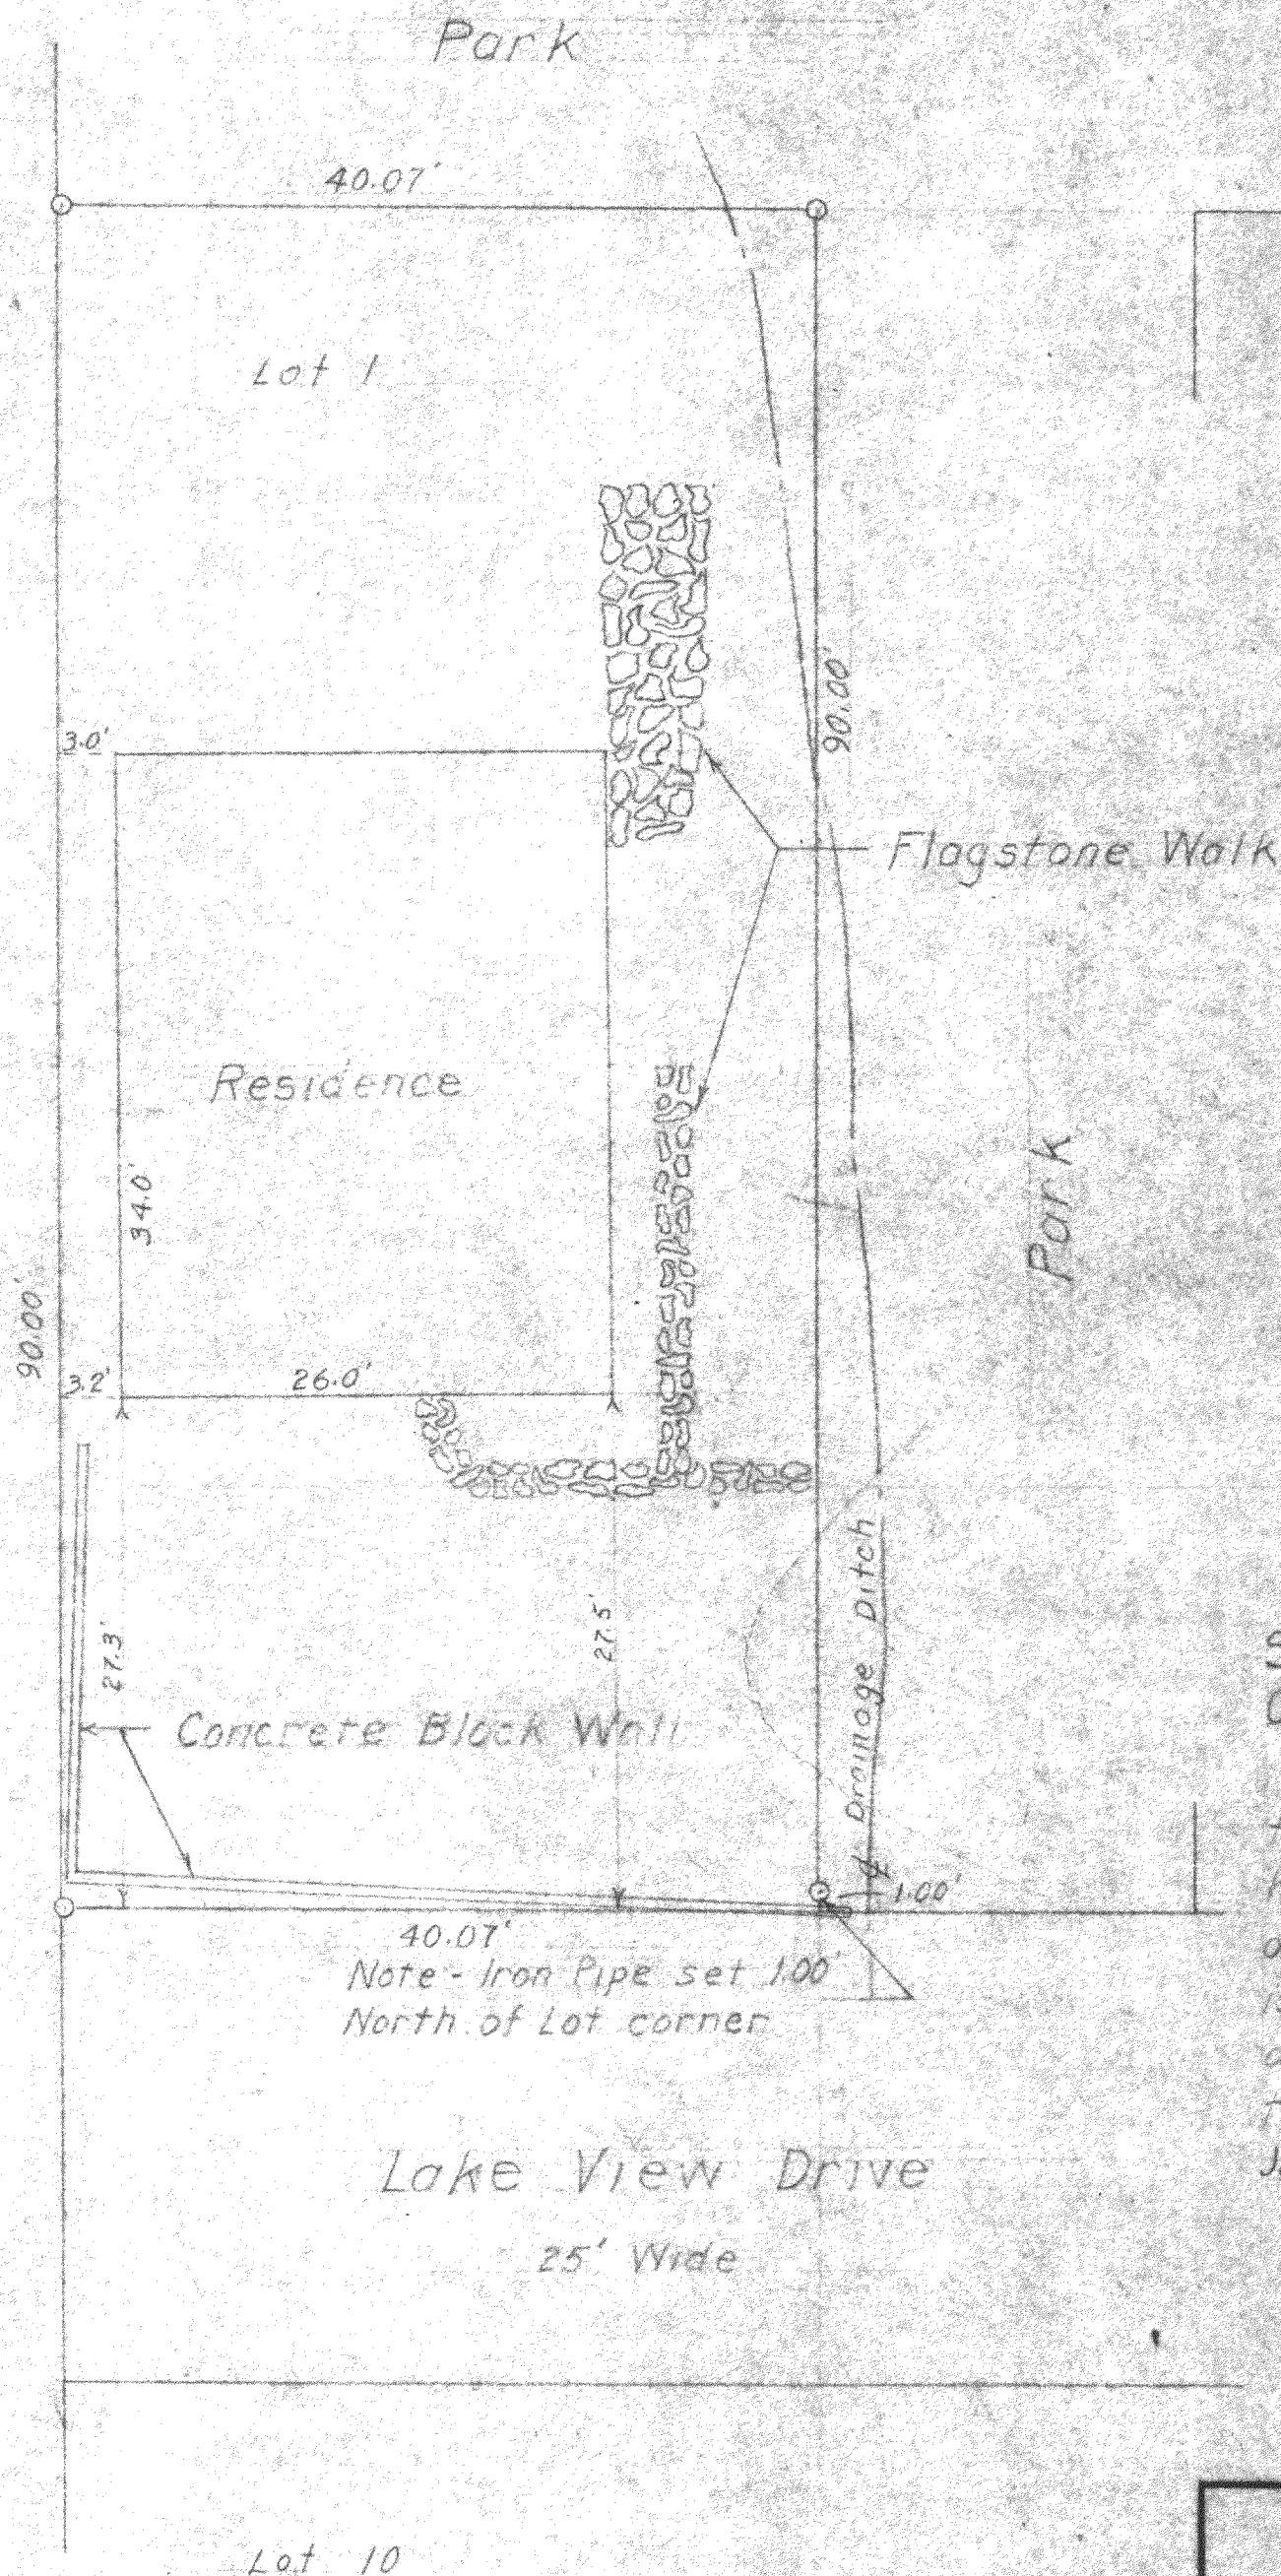

State of Wisconsin)
County of Walworth)

I, Lloyd L. Jensen, do hereby certify
that I have surveyed the property
hereon described according to the
official records, and that the plat hereon
is a correct representation of the lot lines
and principal lines of the buildings
thereon.

July, 1957

Lloyd L. Jensen
Surveyor

or Iron Pipe

PLAT OF SURVEY OF

Lot 1, Edgewater Terrace, located in
Section 9, T1N, R1E, Walworth
County, Walworth

Lloyd L. Jensen
Surveyor

SCALE 1" = 10'

DATE July, 1957

117-160.1