

FARRIS, HANSEN & ASSOCIATES, INC.

7 RIDGEWAY COURT, P.O. BOX 437
ELKHORN, WISCONSIN 53121


PHONE: (414) 723-2098
FAX: (414) 723-5886

LOCATION: LOT 8 EXCEPT THE NORTH 14',
& THE NORTH 21' OF LOT 9
OAK SHORES
SEC. 18, T. 1 N., R. 17 E.
WALWORTH COUNTY, WISCONSIN

WORK ORDERED BY: CARY KERGER
1801 S. MEYERS RD., SUITE 220
OAKBROOK TERRACE, IL. 60181

MAP LEGEND

- = IRON PIPE STAKE FOUND
- = IRON PIPE STAKE SET
- = IRON ROD STAKE FOUND
- = IRON ROD STAKE SET
- = CONCRETE MONUMENT FOUND
- = RECORD DIMENSION


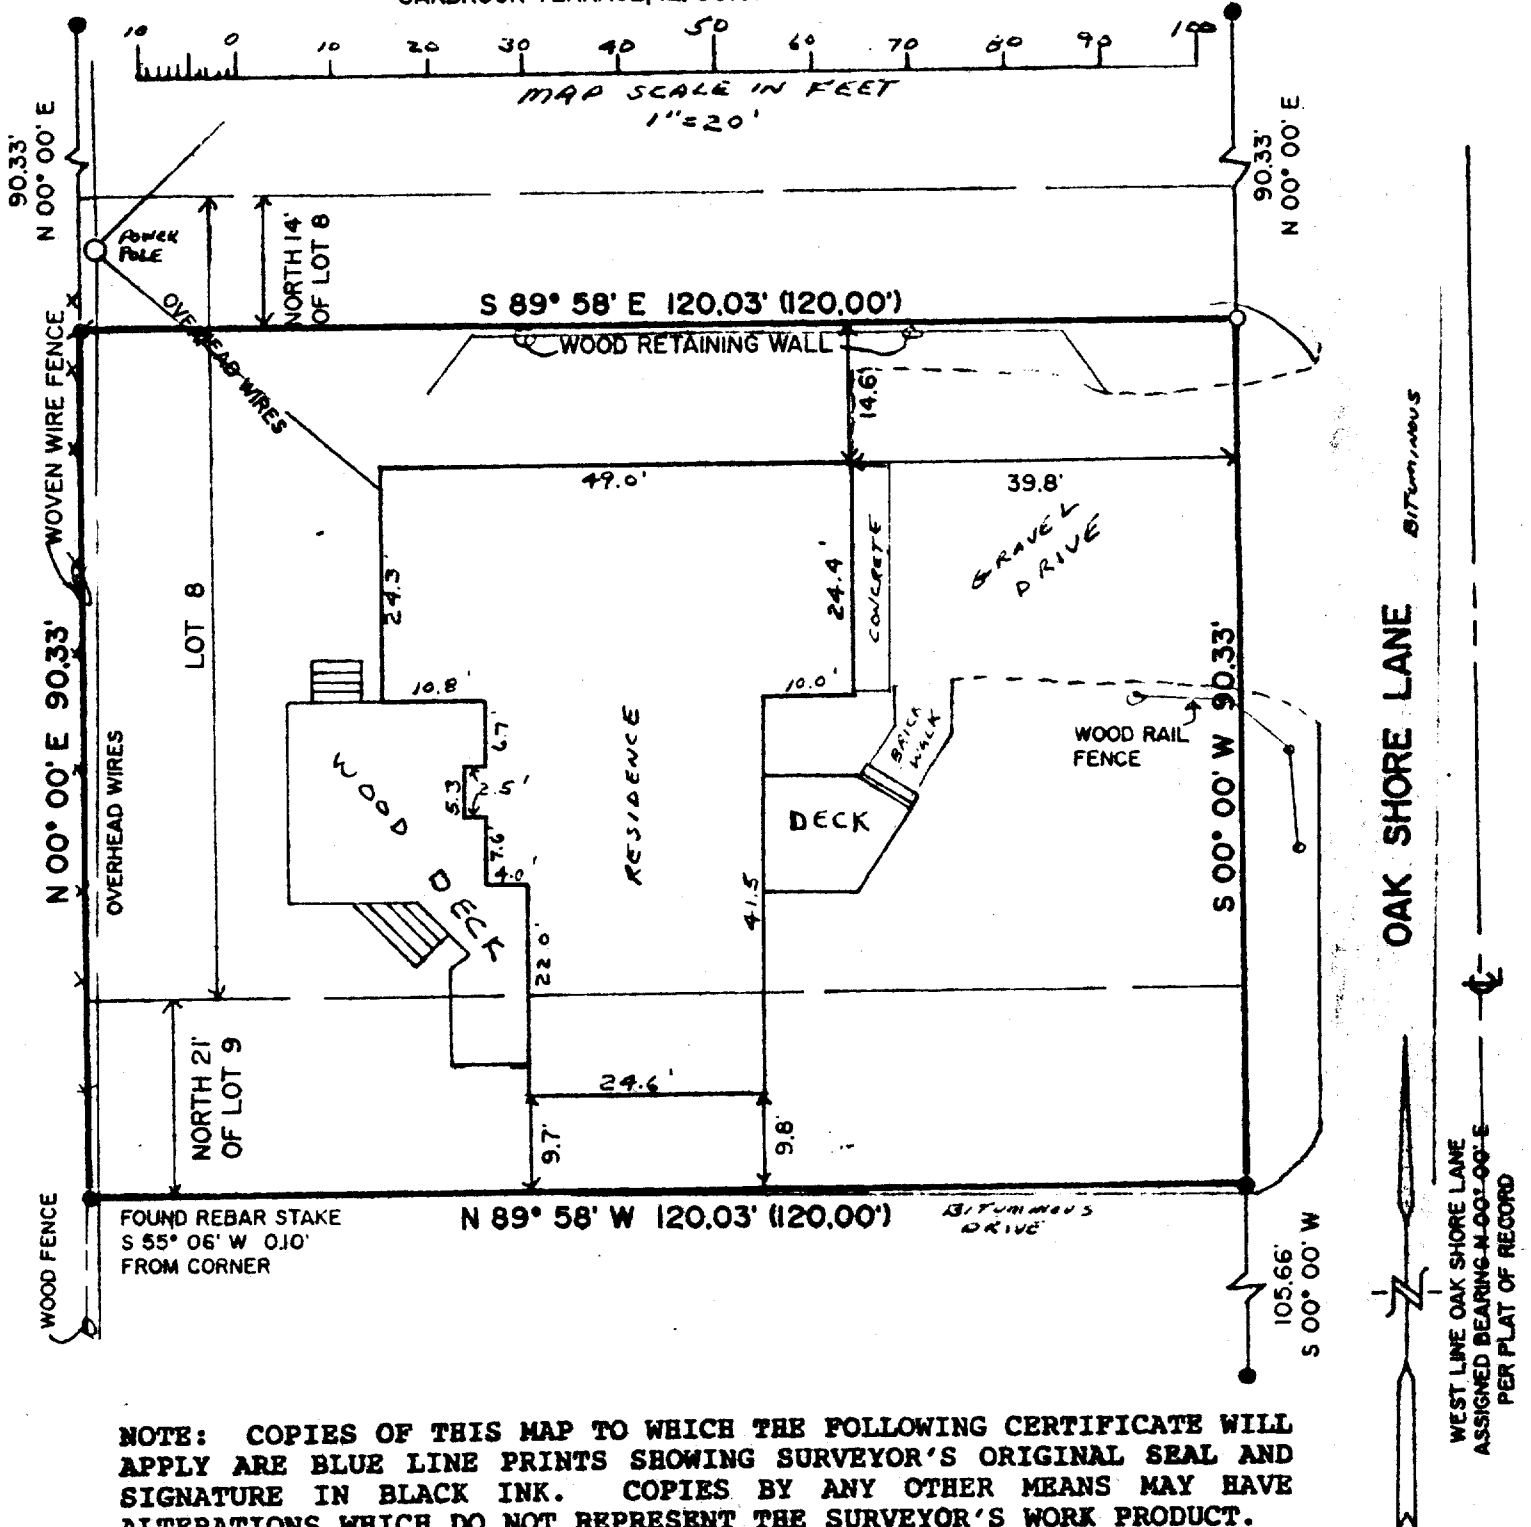


NOTE: COPIES OF THIS MAP TO WHICH THE FOLLOWING CERTIFICATE WILL APPLY ARE BLUE LINE PRINTS SHOWING SURVEYOR'S ORIGINAL SEAL AND SIGNATURE IN BLACK INK. COPIES BY ANY OTHER MEANS MAY HAVE ALTERATIONS WHICH DO NOT REPRESENT THE SURVEYOR'S WORK PRODUCT.

I HEREBY CERTIFY THAT THIS PLAT OF SURVEY IS A TRUE AND ACCURATE REPRESENTATION OF THE BOUNDARY LINES OF THE SUBJECT PARCEL AND SHOWS THE SIZE AND LOCATION OF ALL BUILDINGS ON THE PARCEL SHOWN HEREON, TO THE BEST OF MY PROFESSIONAL KNOWLEDGE AND BELIEF. THIS SURVEY IS MADE FOR THE USE OF THE PRESENT OWNERS OF THE PROPERTY AND ALSO THOSE WHO PURCHASE, MORTGAGE, OR GUARANTEE THE SAME THERETO WITHIN ONE YEAR FROM THE DATE HEREOF.

DATED: 5/21/98

PETER S. GORDON RLS 2101

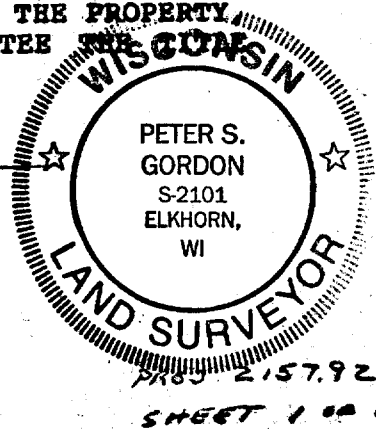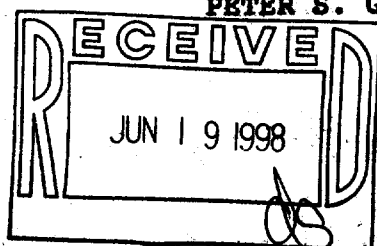

117-1716
10-8

SHEET 1 OF 1