


REGISTERED PROFESSIONAL LAND SURVEYOR
LAKE GENEVA, WISCONSIN



lots 11 and 12, Block 15, Wooddale, a subdivision located in Section 16, T 1 N, R 17 E, Walworth County, Wisconsin.

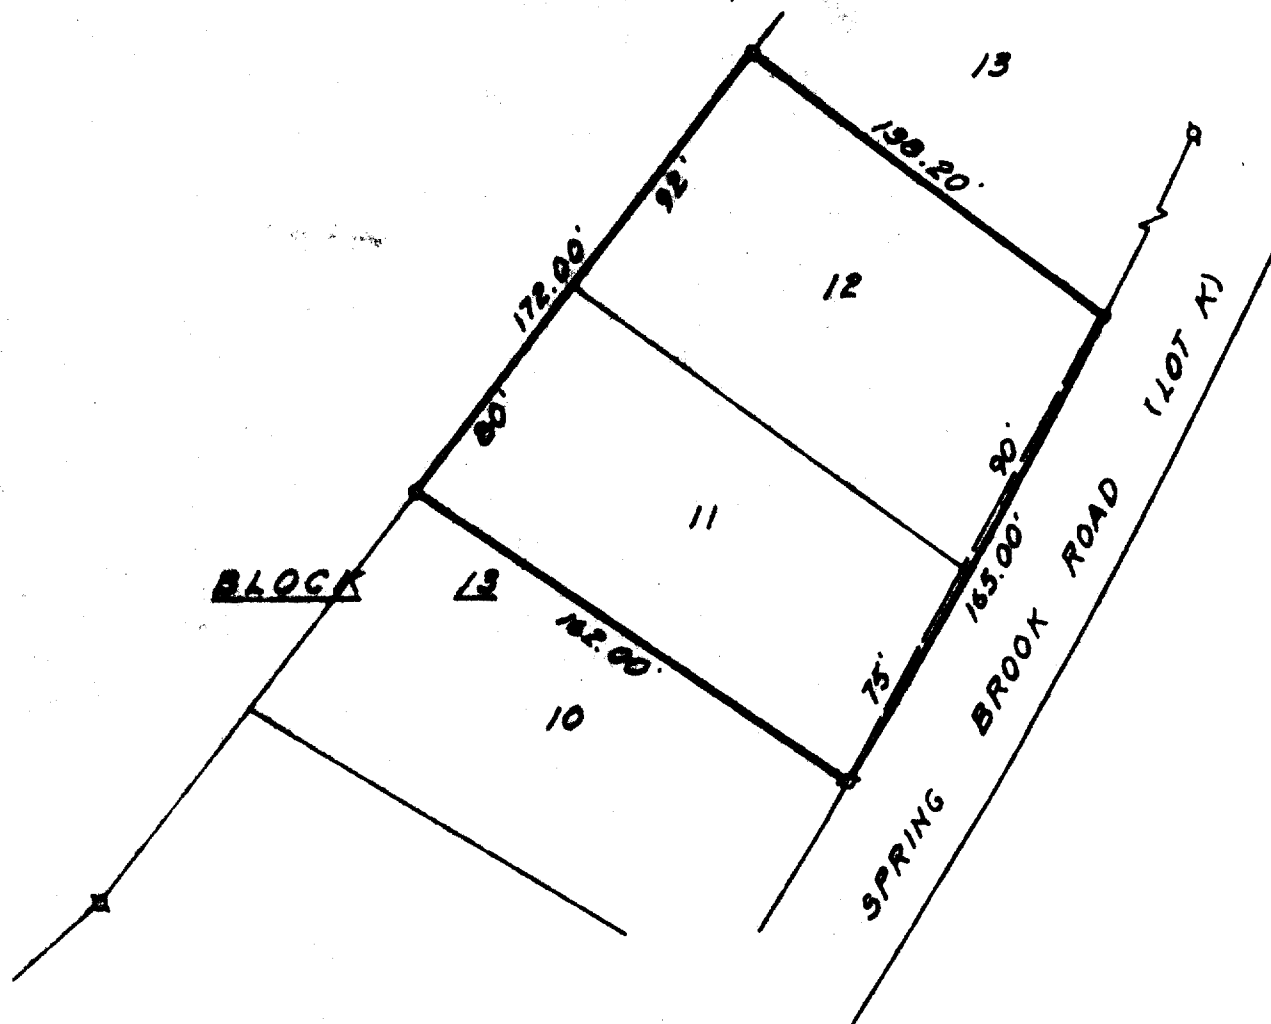

LEGEND

- / - IRON PIPE FOUND
 O - IRON PIPE PLACED
 @ - CONCRETE MONUMENT
 X - SPIKE

I, HAROLD H. KOLB, DO HEREBY CERTIFY THAT I HAVE SURVEYED THE PROPERTY HEREON DESCRIBED ACCORDING TO THE OFFICIAL RECORDS, AND THAT THE PLAT HEREON IS A CORRECT REPRESENTATION OF THE LOT LINES.

Harold H. Kolt
HAROLD H. KOLT

WISCONSIN REGISTERED LAND SURVEYOR, S-187

DATE November 1, 1965

IW-69C

117-175

1-17-76-15