


PLAT OF


PATHFINDER SURVEYING
FORMERLY KOLB LAND CONSULTING
929 WILLIAMS STREET LAKE GENEVA, WI. 53147
(414) 248-3697

ORDERED BY:
PETER BAZOS
1250 LARKIN AVE.
100
ELGIN IL. 60123



DATE: 11 / 02 / 1998

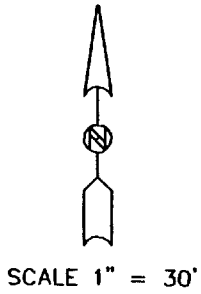

GENEVA
LAKE

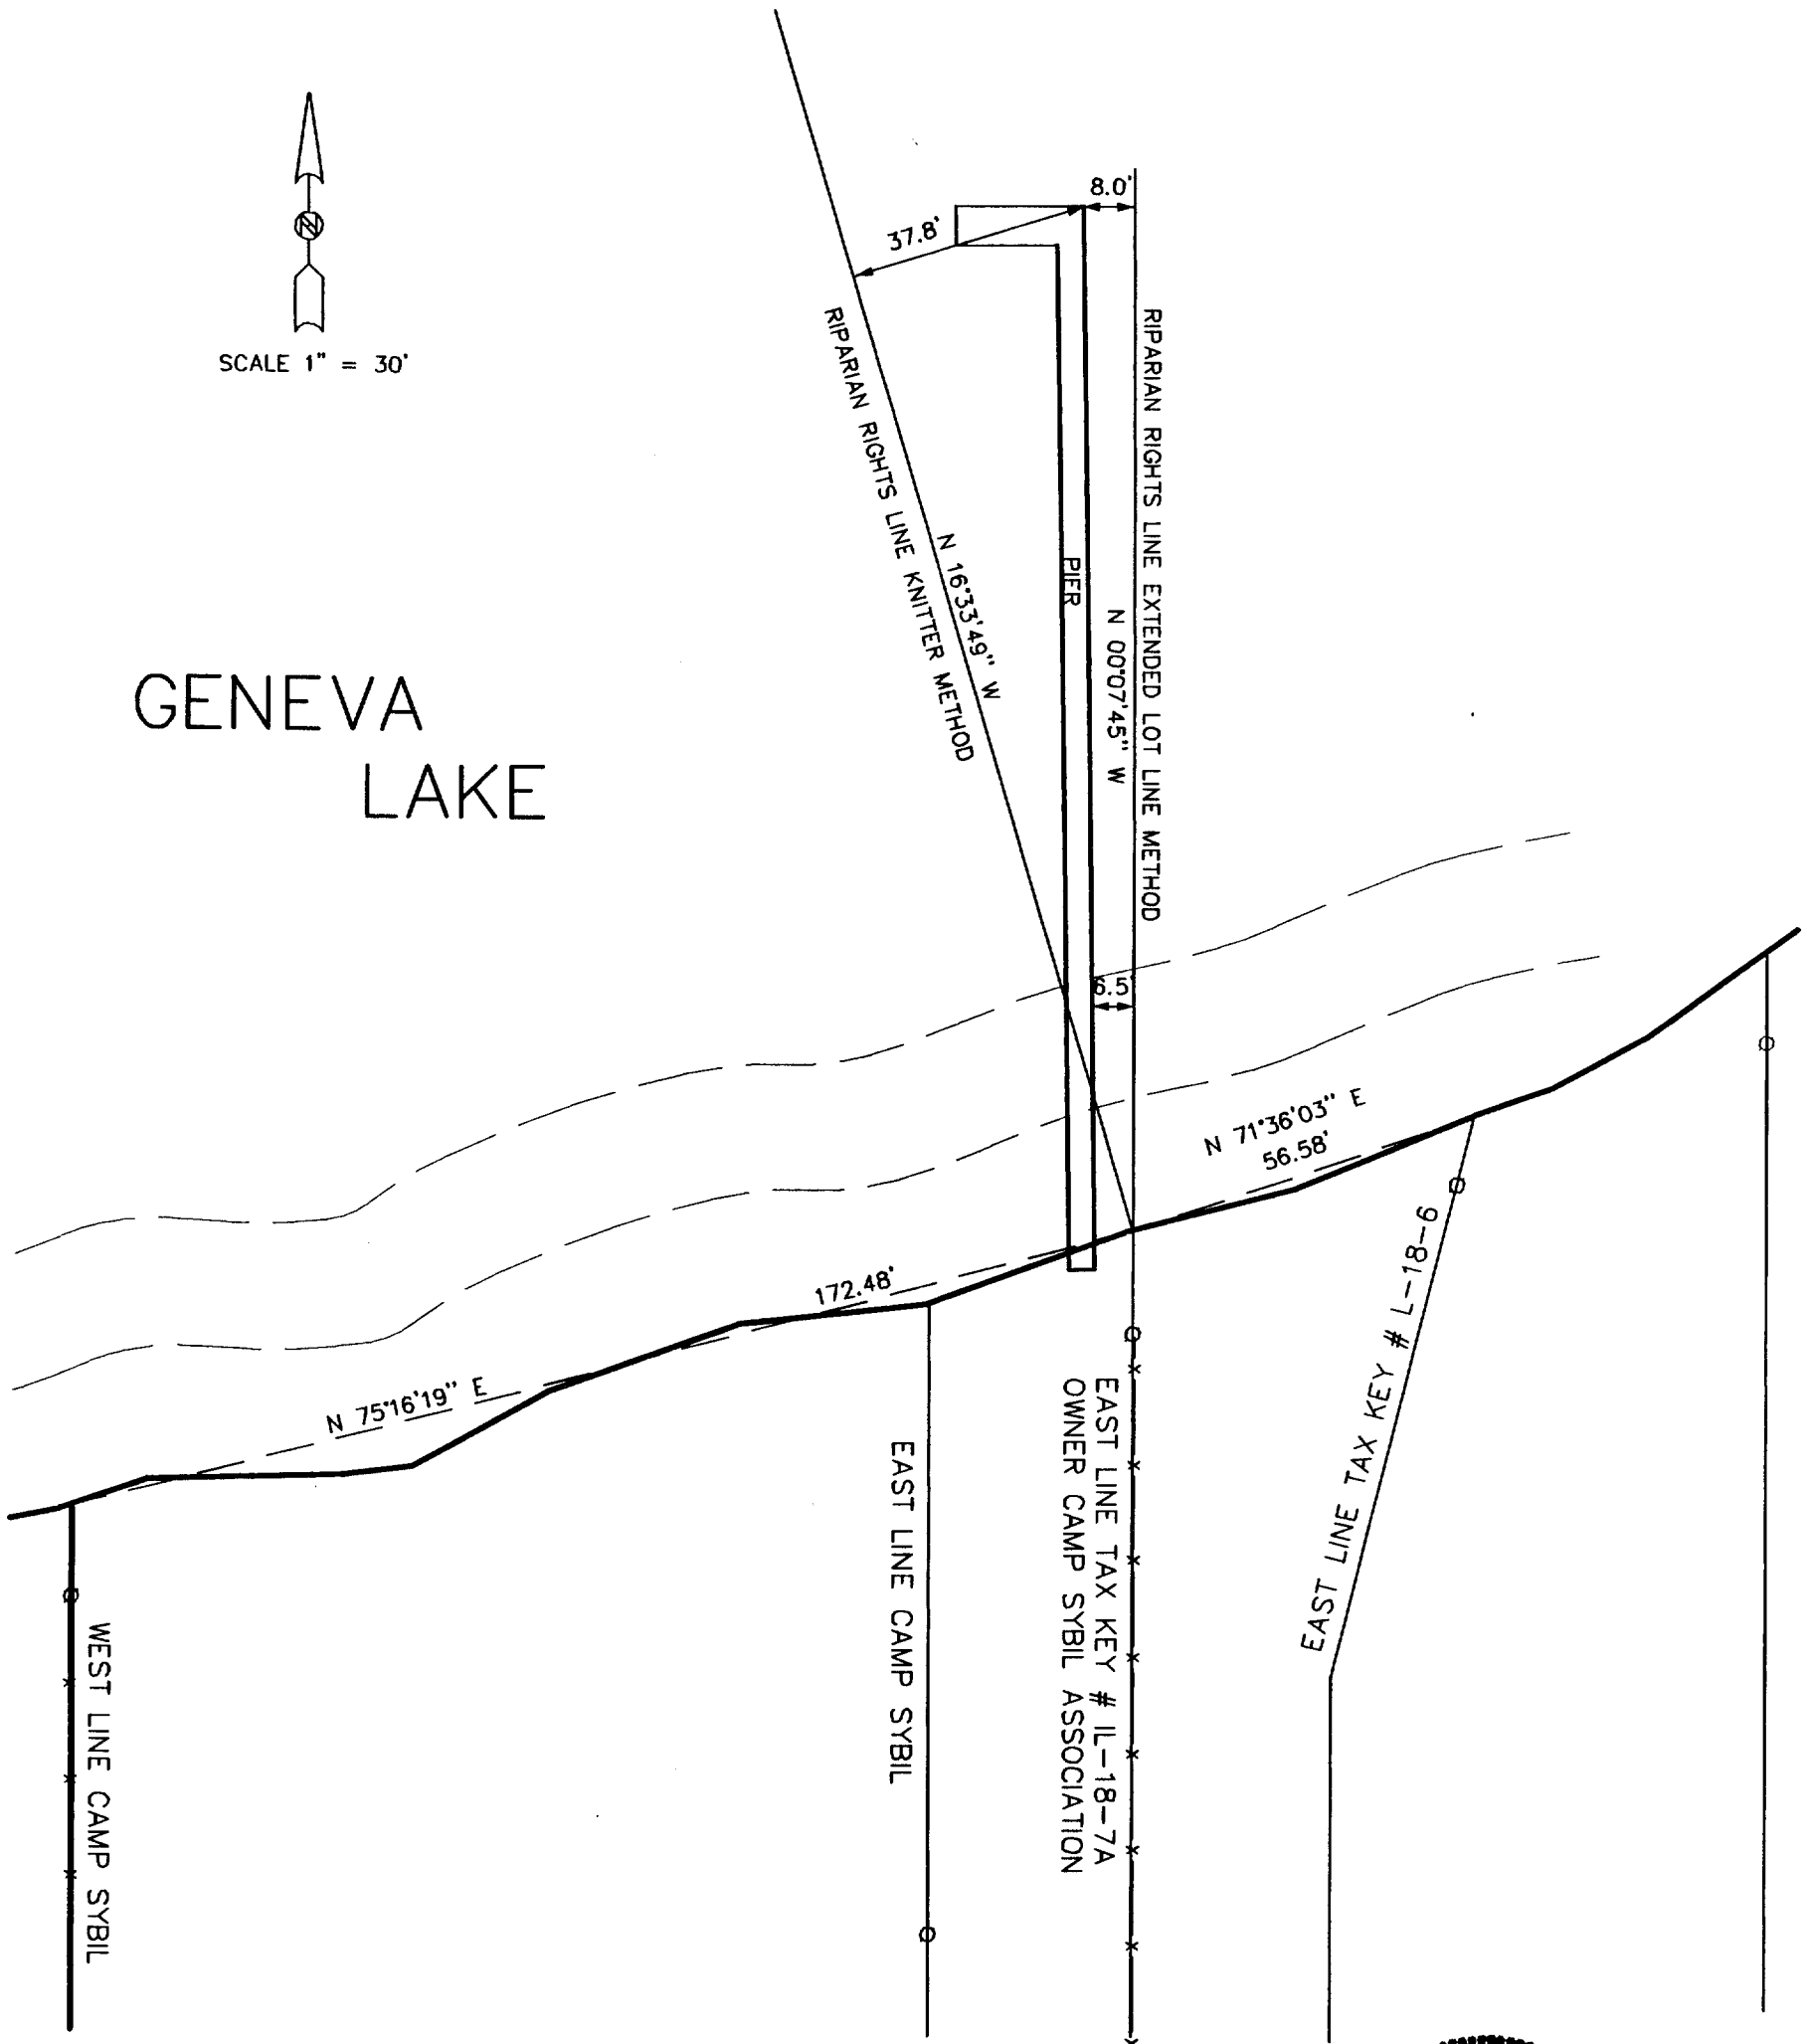

PLAT OF A PARCEL OF LAND LOCATED IN THE NORTHEAST 1/4
OF SECTION 18, TOWN 1 NORTH, RANGE 18 EAST BEING PART
OF CAMP SYBIL SUBDIVISION AND PART OF TAX KEY # IL-18-

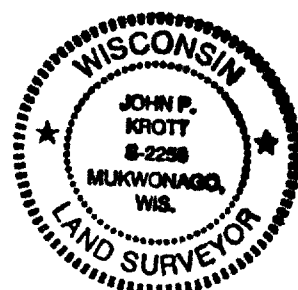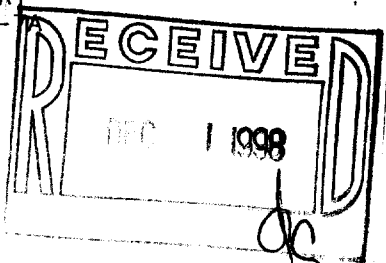

NOTE: THIS IS NOT A CERTIFIED COPY
UNLESS SEAL IS IN RED.

JOHN P. KROTT, R.L.S. 2258

JOB NUMBER: 98187 1-17-CAMP SYBIL ASSOCIATION

IL-18-7A

117-1759