



AMBIT LAND SURVEYING  
P. O. Box 42  
Bassett, WI. 53101

# PLAT OF SURVEY

## OF

PHONE 414-537-4874  
FAX 414-537-4221

Lots 10 and 11, Block "D" of CISCO BEACH, a subdivision located in part of the Section 5, Township 1 North, Range 17 East of the 4th Principal Meridian, Town of Linn, Walworth County, Wisconsin.

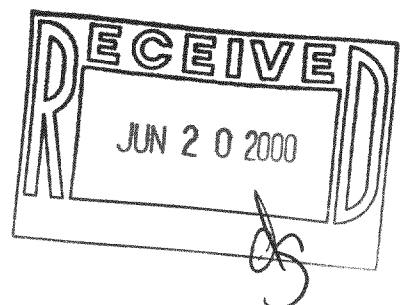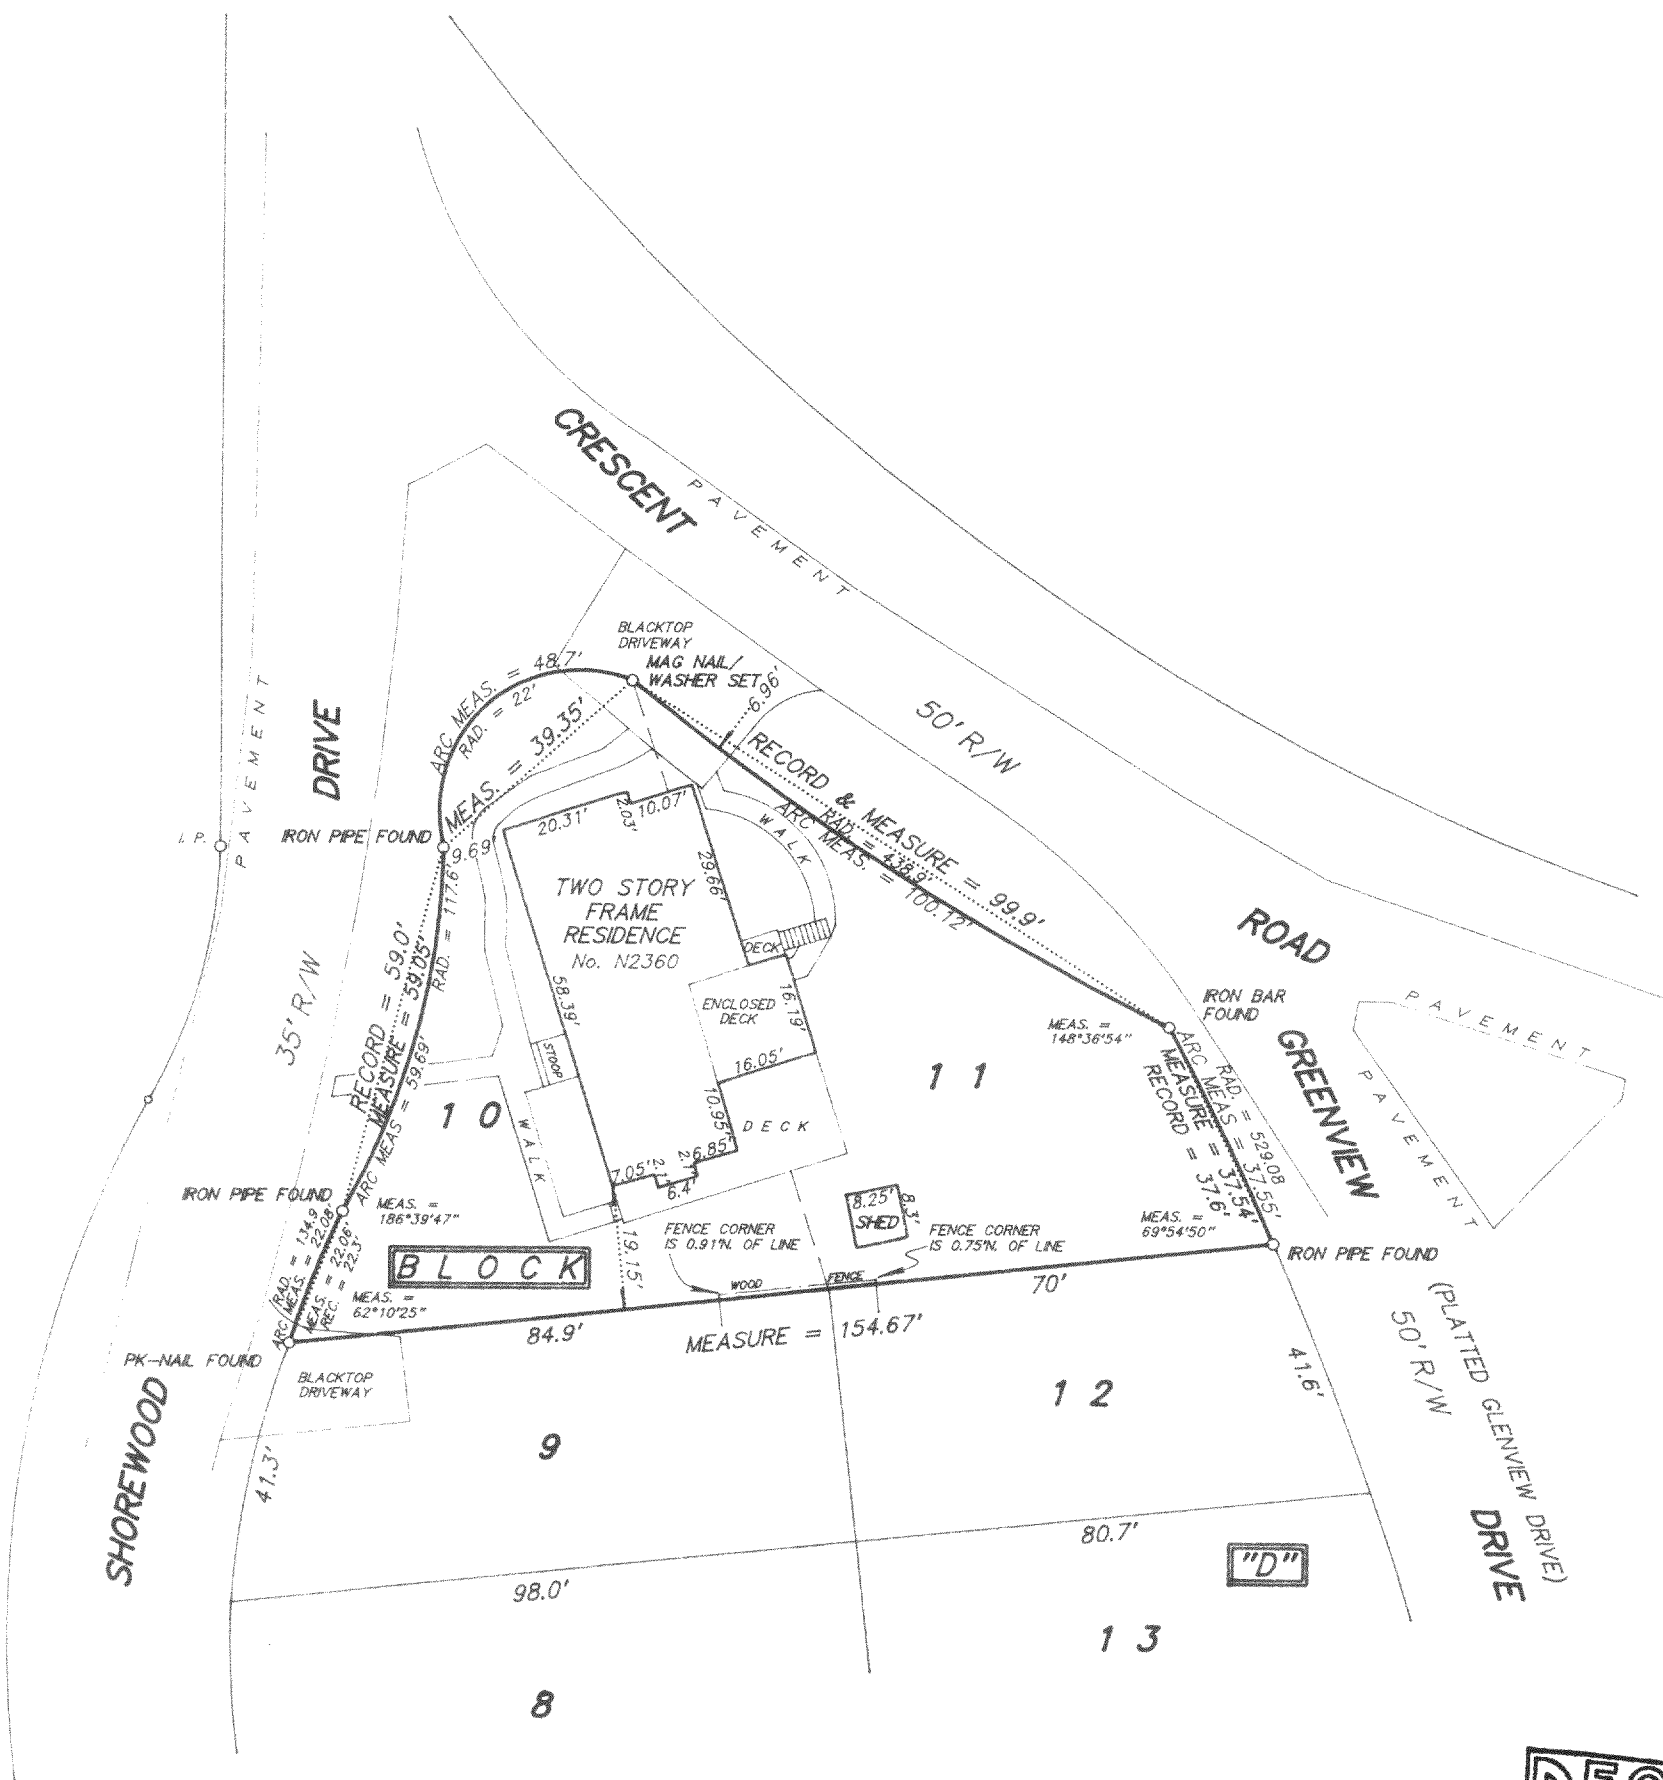

SCALE 1 inch = 30 feet

ORDERED BY D. Schiltz/Davison, Mulligan & Schiltz, LTD.

JOB NO. 9 8 3 7 5

PLAT REVISED THIS 4TH DAY OF DECEMBER, 1998.

I hereby certify that I have surveyed the above described property and the above plat is a true representation thereof and shows the size and location of the property, its exterior boundaries, the location and dimensions of all visible structures thereon, boundary fences, apparent easements and roadways and visible encroachments, if any.

This survey is made for the exclusive use of the present owners of the property, and also those who purchase, mortgage, or guarantee the title thereto within one year from the date hereof.

Dated at Bassett, Wisconsin this \_\_\_\_\_ day of \_\_\_\_\_ 1998.

Mark A. Bolender  
Wisconsin Registered Land Surveyor S - 1784

ICI-84  
117-1880