

BENCH MARK - "X" CUT IN
CONCRETE STEEL (KNIGHT RINGS)
ELEVATION 112.15

SHADY LANE

S 35° 24' W 96.75'

S 49° 31' W 503.95'

S 75° 31' E 261.01'


S 61° 46' W 102.13'

S 22° 34' E 279.30'

BUILDING SETBACK LINE

GENEVA LAKE

WATER ELEVATION OCT. 7, 1960 - 35.83

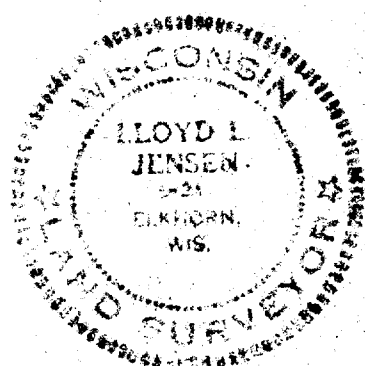

O — IRON PIPE FOUND
ALL LOT DIMENSIONS AS PLATTED

PLAT OF SURVEY OF

GROUND ELEVATIONS
OF
LOT 2, BLOCK 1
FOREST REST SUBDIVISION
WALWORTH COUNTY
WISCONSIN

Lloyd L. Jensen
SURVEYOR

SCALE 1" = 20'

DATE OCT. 7, 1960

elevation map