
## ABELL SURVEYING & MAPPING

1140 SEQUOIA STREET . DELAVAN, WISCONSIN 53115 262-728-6737

BORDER

50 FEET WIDE

S 88°41'01" E (N 88°40' W )

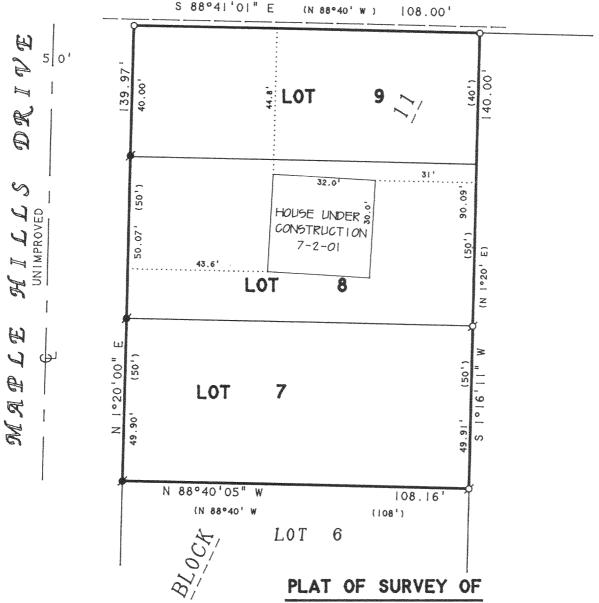

ORDERED BY:

PAULINE WILLARD 641 QUINCY BRIDGE LANE

GLENVIEW, IL 60025

LOTS 7-9, BLOCK II, MAPLE HILLS "A" SUBDIVISION, LOCATED IN TIN. RI7E, WALWORTH COUNTY, WISCONSIN.

NOTE: BEARINGS ARE REFERENCED TO THE RECORDED SUBDIVISION PLAT.

REVISED: JULY 2, 2001 TO SHOW HOUSE UNDER CONSTRUCTION.

REVISED: MARCH 9, 2001 TO SHOW PROPOSED HOUSE AND GARAGE ORDERED BY: JOHN WENDT

I HEREBY CERTIFY THAT I HAVE SURVEYED THE ABOVE DESCRIBED PROPERTY AND THAT THE ABOVE MAP IS A TRUE REPRESENTATION THEREOF AND SHOWS THE SIZE AND LOCATION OF THE PROPERTY, ITS EXTERIOR BOUNDARIES, THE LOCATION OF ALL VISIBLE STRUCTURES AND DIMENSIONS OF ALL PRINCIPAL BUILDINGS THEREON, BOUNDARY FENCES, APPARENT EASEMENTS, ROADWAYS AND VISIBLE ENCROACHMENTS, IF ANY, TO THE BEST OF MY KNOWLEDGE AND BELIEF.

NI703 WOODDALE ROAD LAKE GENEVA, WI 53147





SCALE | " = 30 '

LEGEND

-IRON PIPE FOUND

-IRON ROD FOUND
-IRON PIPE SET, found 7/2/01
-OVERHEAD UTILITY LINES

)-RECORDED AS

DAVID F. ABELL WISCONSIN REGISTERED LAND SURVEYOR, S-1596

June 12, 1997

JOB NUMBER - 9711082
THIS IS NOT A CERTIFIED COPY UNLESS SEALED.

