


LOT 4 OF THE BIRCHES FIRST ADDITION WALWORTH COUNTY, WISCONSIN

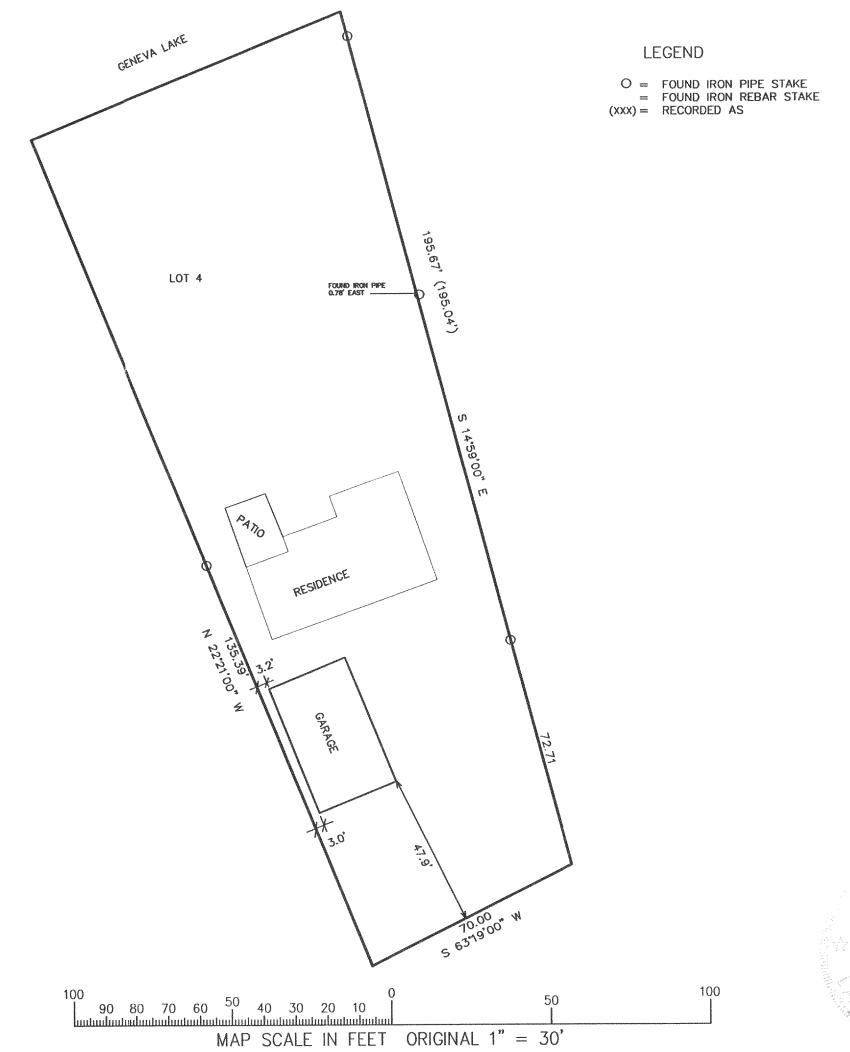


REVISIONS

NOTE: COPIES OF THIS MAP TO WHICH THE FOLLOWING CERTIFICATE WILL APPLY SHOW SURVEYOR'S ORIGINAL SEAL AND SIGNATURE IN RED INK. COPIES BY ANY OTHER MEANS MAY HAVE ALTERATIONS WHICH DO NOT REPRESENT THE SURVEYOR'S WORK PRODUCT. I HEREBY CERTIFY THAT THIS PLAT IS A TRUE AND ACCURATE REPRESENTATION OF THE LOCATION OF THE AS BUILT GARAGE IN RELATION TO THE MONUMENTS FOUND AND SHOWN TO THE BEST OF MY PROFESSIONAL KNOWLEDGE AND BELIEF. NOTE THIS IS NOT A PLAT OF SURVEY AS DEFINED IN CHAPTER A-E 7 OF WISCONSIN



PETER S. GORDON RLS 2101

IBA1-3

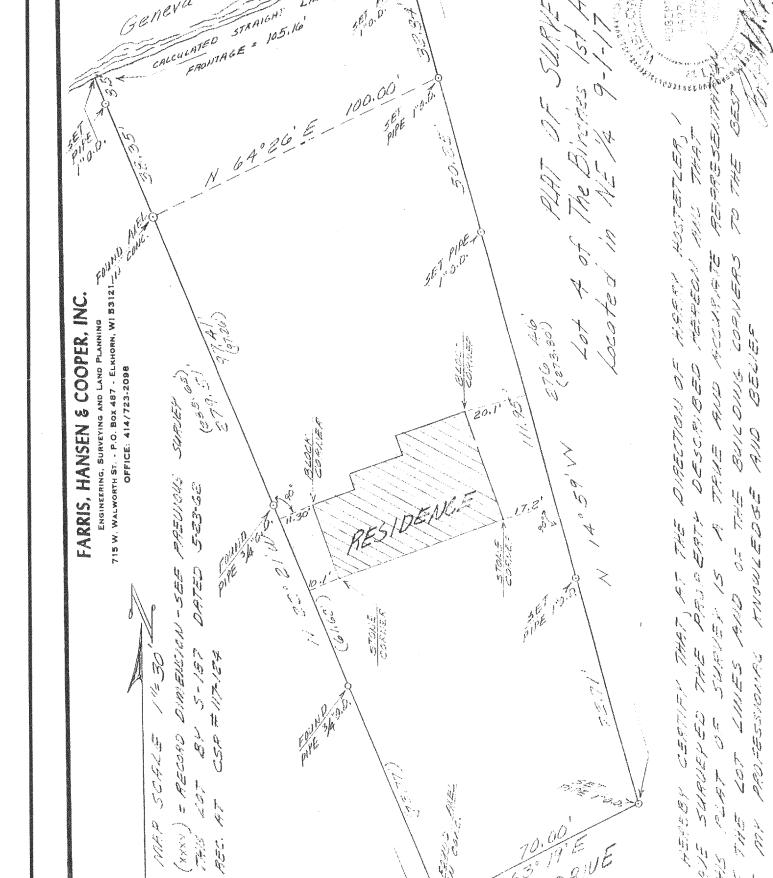



PROJECT NO. 1968.01

DATE: 07-11-01 SHEET NO.

1 OF 1