


PLAT OF SURVEY

LOTS 16 AND 17 AND TWO 10 FOOT STRIPS OF LAND ON THE WATER FRONT DESIGNATED AS PARCELS NO. 8 AND 9 OF ALTA VISTA ESTATES, LOCATED IN GOVERNMENT LOT 2, AND IN THE SOUTHEAST 1/4 OF THE NORTHEAST 1/4 OF SECTION 4, TOWN 1 NORTH, RANGE 17 EAST, WALWORTH COUNTY, WISCONSIN.

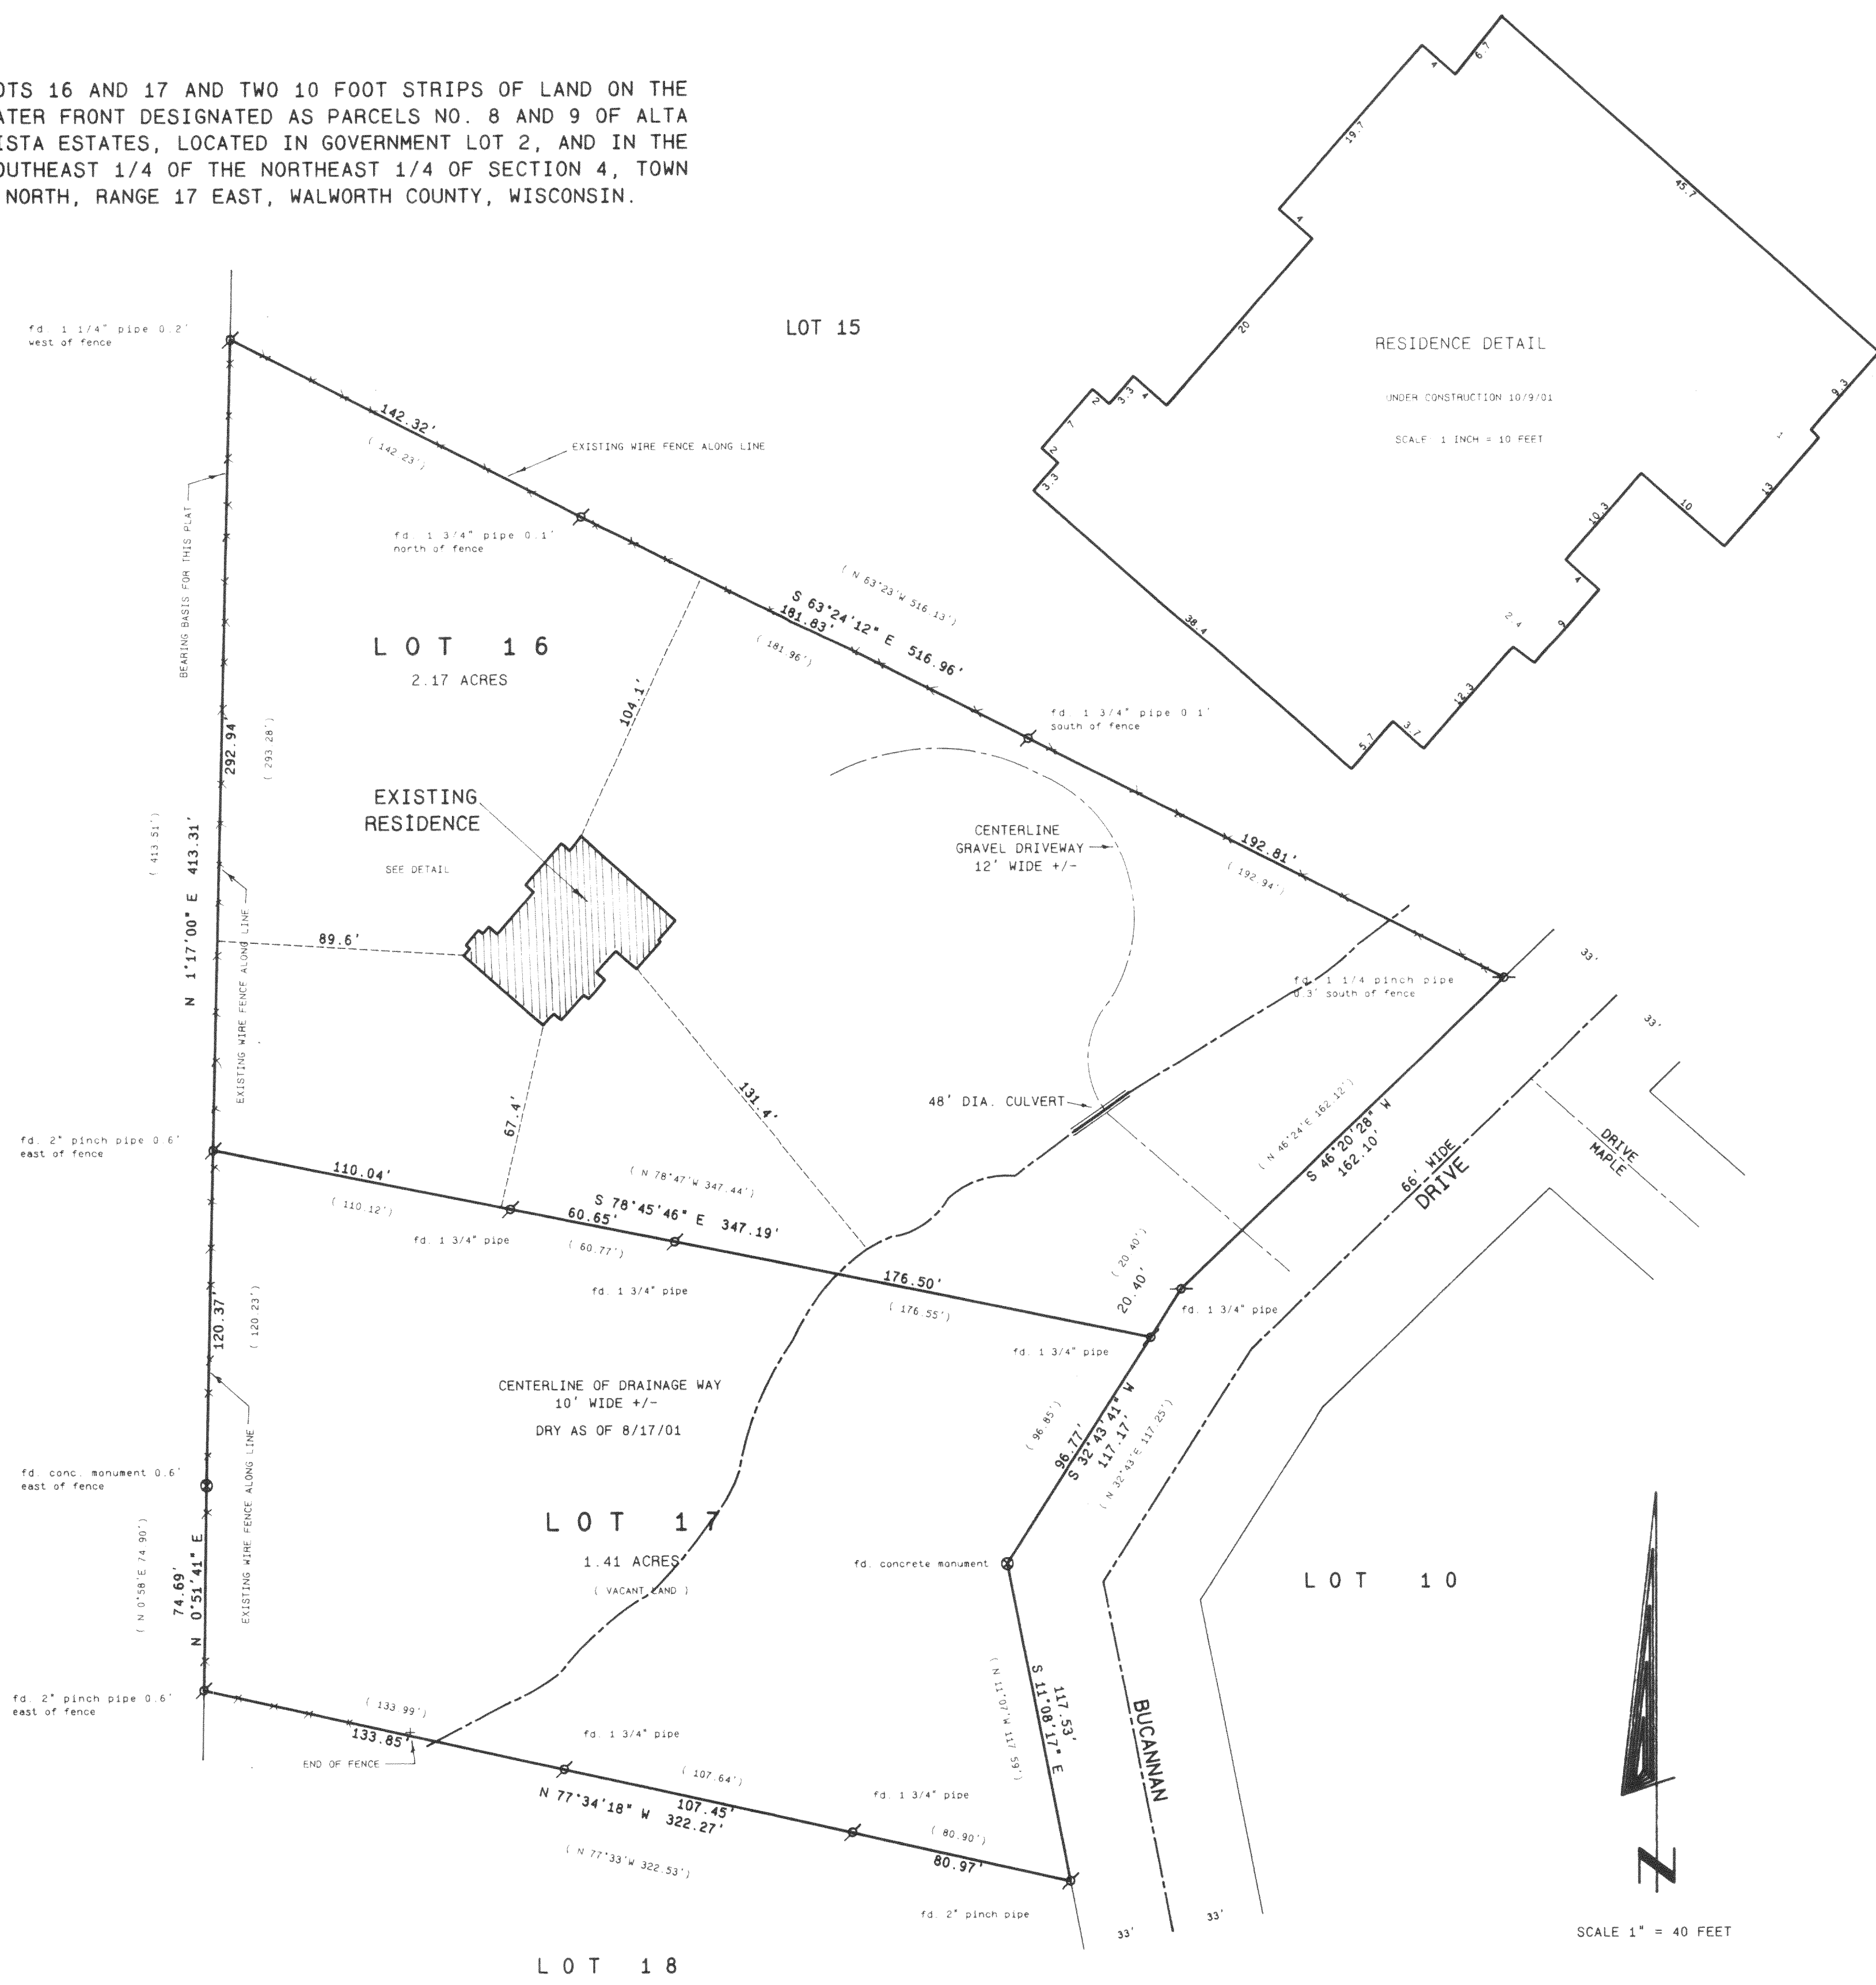




LEGAL DESCRIPTION

WARRANTY DEED RECORDED IN VOL. 619 P. 487
AS DOCUMENT NO. 570600 DATED JUNE 3rd,
1965. ERWIN J JANICKE AND GERDA JANICKE,
husband and wife TO RICHARD H. HOWLAND and
MARILYN M. HOWLAND, his wife.

OWNERS: JOHN and JEAN BLIX
549 SIOUX DRIVE
FONTANA, WI. 53125

REVISED 8/17/01 TO SHOW PROPOSED
RESIDENCE, DRAINAGE WAY, DRIVE AND
CULVERT.

REVISED 10/10/01 TO SHOW EXISTING
RESIDENCE "AS BUILT".

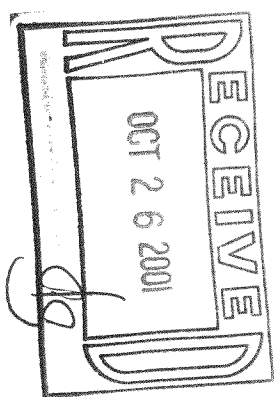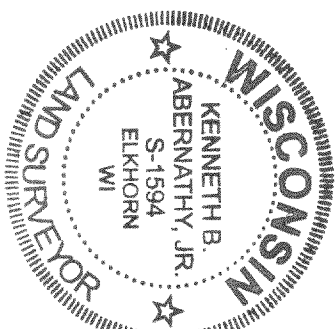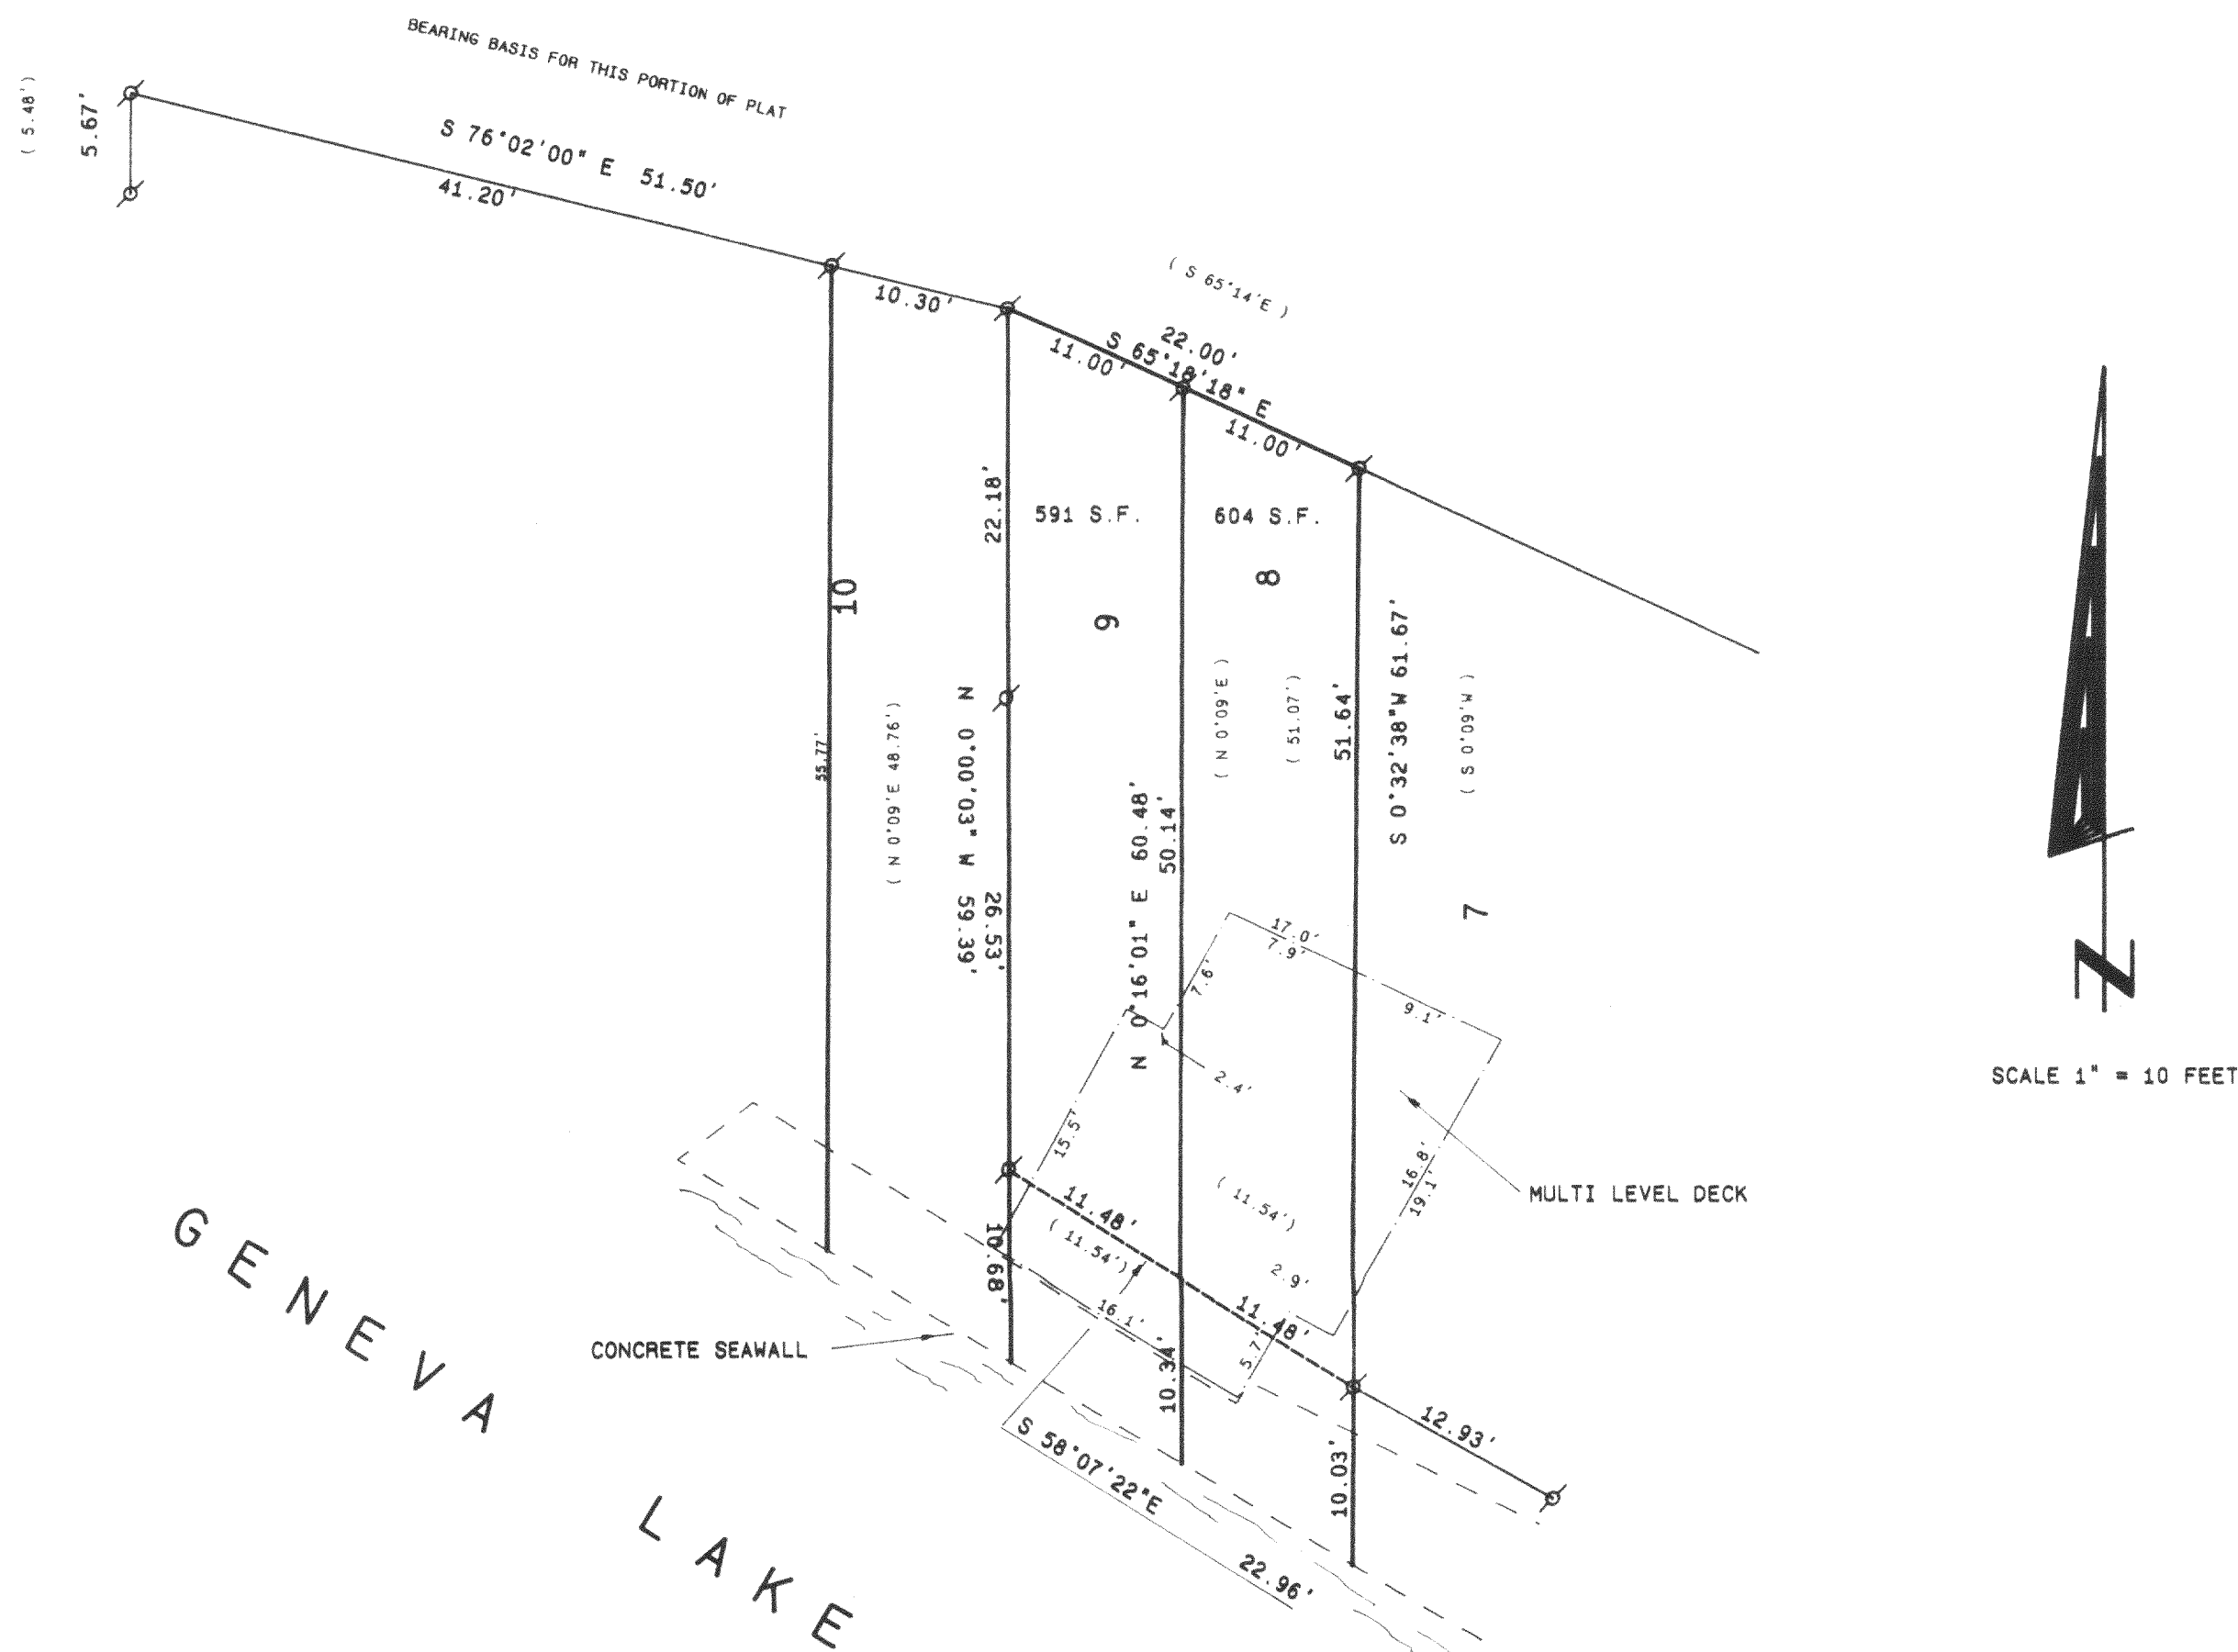

SCALE: 1"=40 FEET

Legend

- | Symbol | Description |
|--------|---|
| | FOUND IRON PIPE |
| | FOUND IRON ROD |
| | FOUND BRASS CAPPED MONUMENT |
| | FOUND CONCRETE MONUMENT |
| | CHISEL CUT IN CONCRETE |
| | SET IRON ROD, 24" LONG, WEIGHING 1.5 LBS., LINEAL FT., 3/4" DIA. |
| | SET IRON ROD, 30" LONG, WEIGHING 4.5 LBS., LINEAL FT., 1-1/16" DIA. |
| | RECORDED AS DIMENSION |
| | EXISTING FENCE |

0
KENNETH B. ABERNATHY, JR.
WISCONSIN REGISTERED LAND SURVEYOR
S-1594
Date: EEB, 7, 1997 Job No. 97.205

117-2676

IAV-14
IAV-15