



PLAT OF SURVEY

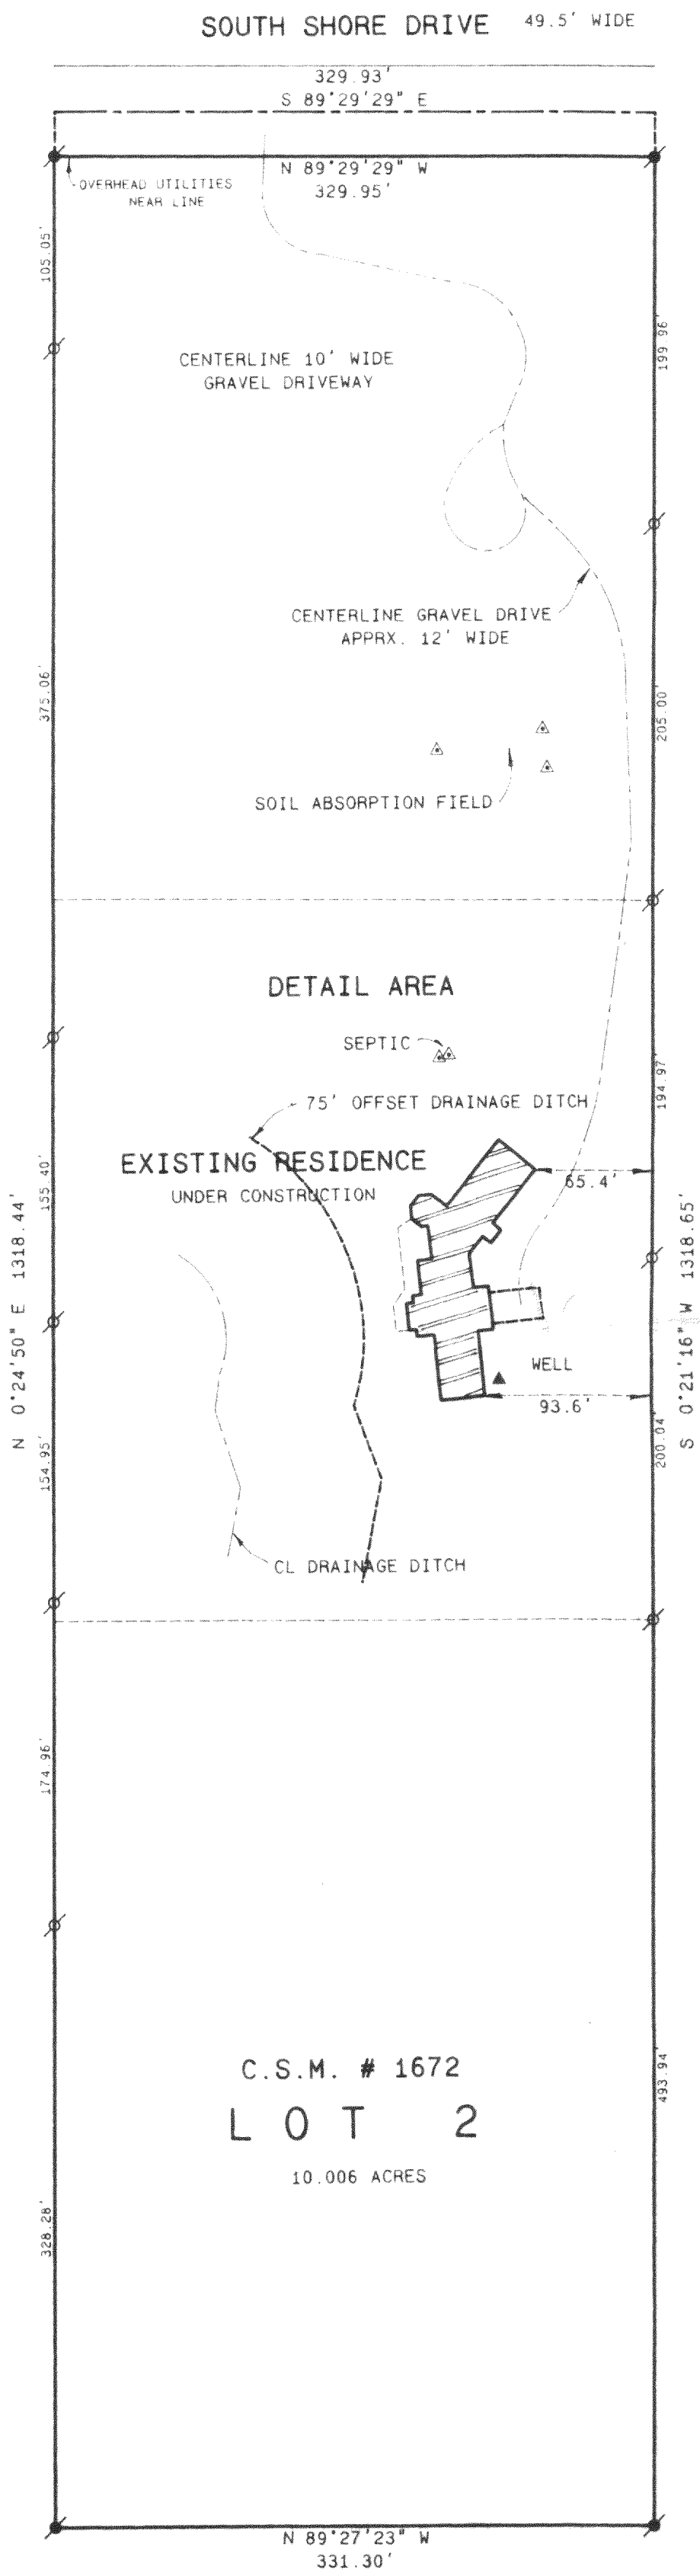


OWNERS: DR. and MRS. FUEREDI
3622 N. HACKETT
SHOREWOOD, WI. 53211

Ordered by: Engerman Contracting
W3411 County Highway BB
Lake Geneva, Wisconsin 53147

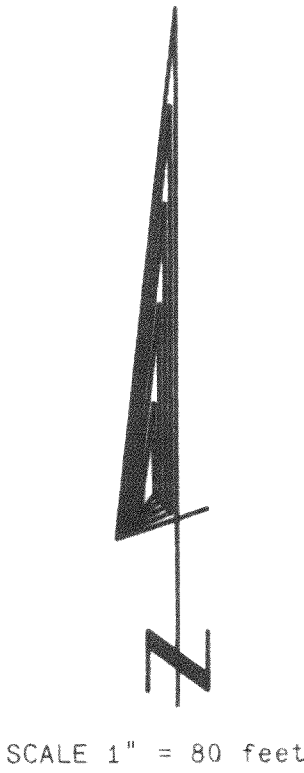


LOT 2 OF CERTIFIED SURVEY MAP
NUMBER 1672 AS RECORDED IN VOLUME
8 OF CERTIFIED SURVEY MAPS AS
PAGES 36 AND 37 AS DOCUMENT NO.
159543, LOCATED IN THE NORTHWEST
1/4 OF THE SOUTHWEST 1/4 OF
SECTION 17, TOWN 1 NORTH, RANGE
17 EAST, WALWORTH COUNTY,
WISCONSIN.

RESIDENCE DETAIL
SCALE 1" = 10 FEET

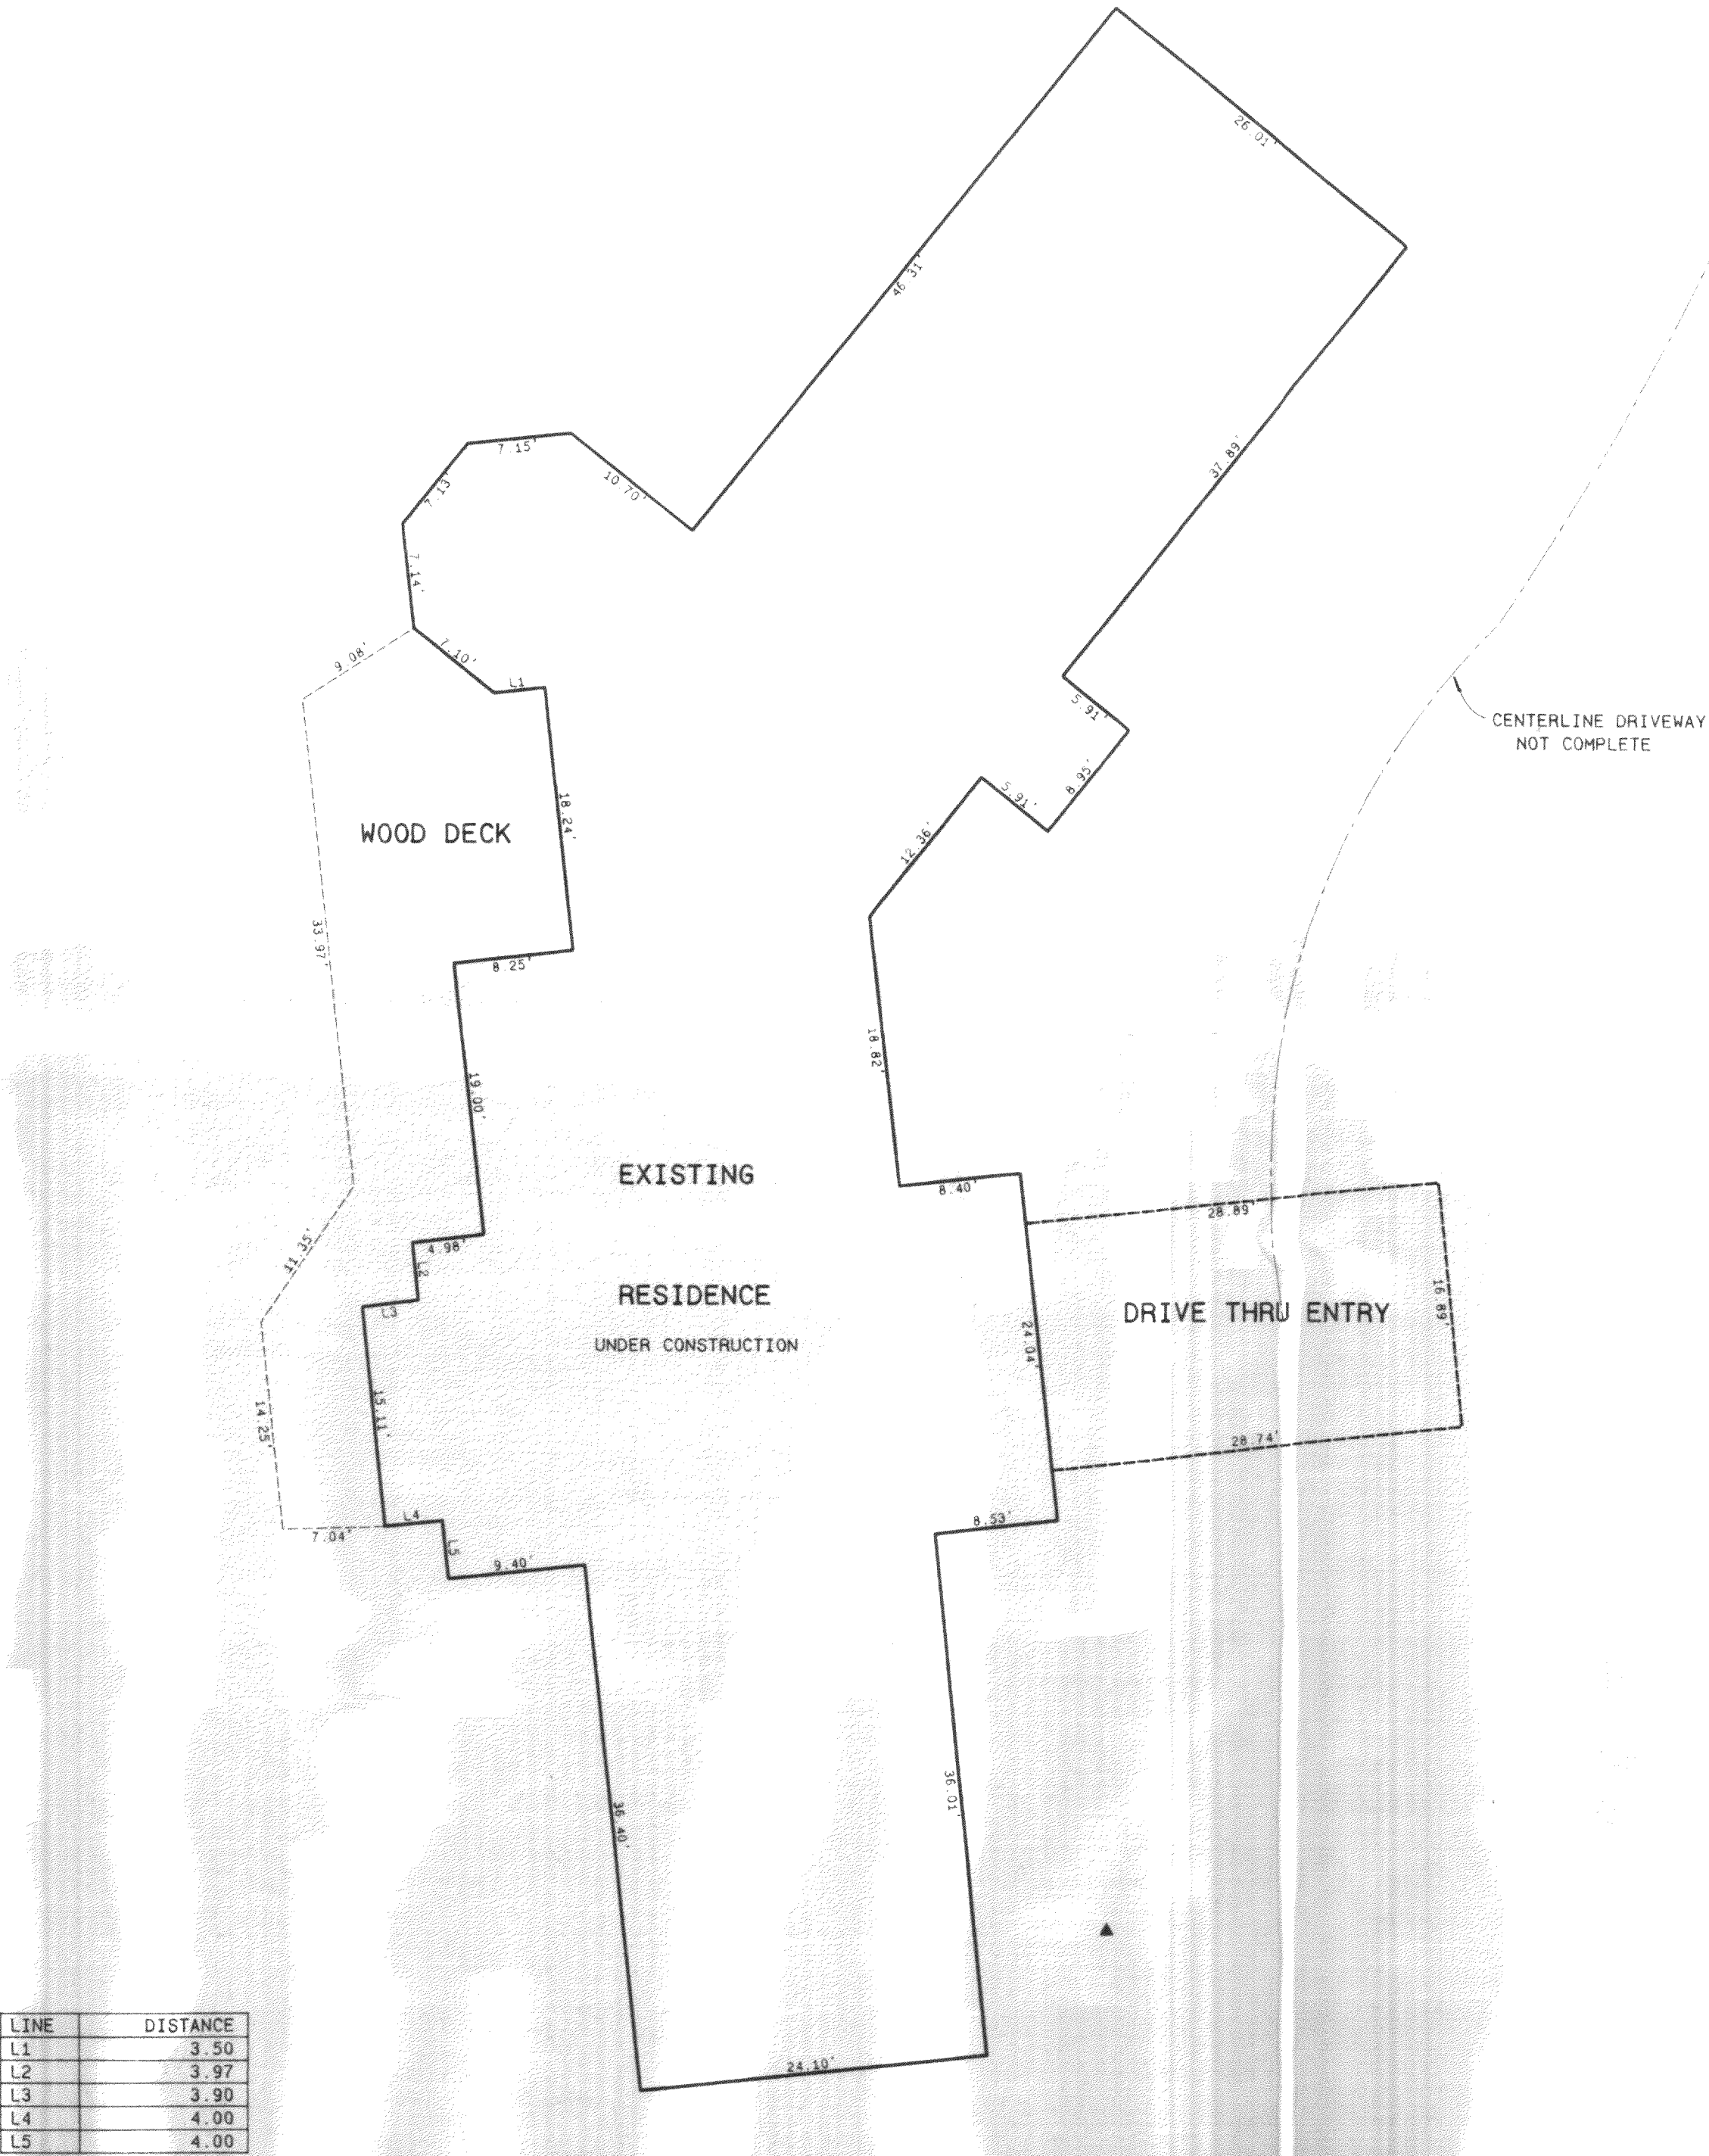


LINE	DISTANCE
L1	3.50
L2	3.97
L3	3.90
L4	4.00
L5	4.00

- Legend
- FOUND IRON PIPE
 - FOUND IRON ROD
 - FOUND BRASS CAPPED MONUMENT
 - FOUND CONCRETE MONUMENT
 - CHISEL CUT IN CONCRETE
 - SET IRON ROD, 24" LONG, WEIGHING 1.5 LBS./LINEAL FT., 3/4" DIA.
 - SET IRON ROD, 30" LONG, WEIGHING 4.5 LBS./LINEAL FT., 1-11/16" DIA.
 - RECORDED AS DIMENSION
 - EXISTING FENCE

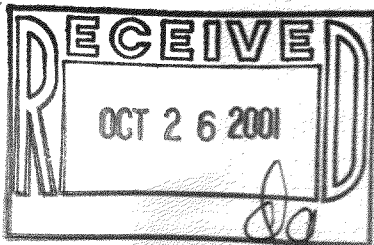

SCALE: 1"= 60 FEET

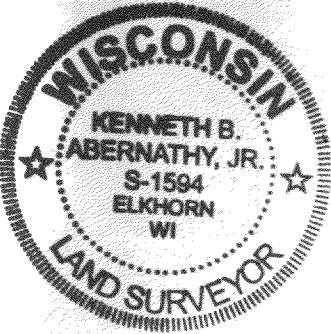

I hereby certify that the above described property has been surveyed by me or under my direction and that the above map is a true representation thereof and shows the size and location of the property, its exterior boundaries, the location of all visible structures and dimensions of all principal buildings thereon, boundary lines, apparent easements, roadways and visible encroachments, if any.

This survey is made for the use of the present owners of the property, and also those who purchase, mortgage, or guarantee the title thereto within one year from date hereof.

Kenneth B. Abernathy, Jr.
KENNETH B. ABERNATHY, JR.
WISCONSIN REGISTERED LAND SURVEYOR,
S-1594
Date: SEPT. 21, 2001 Job No. 99.910