


# PLAT OF SURVEY

OF  
Lot 2 Sunset Hills Shores T1N, R17E  
Walworth County, Wisconsin

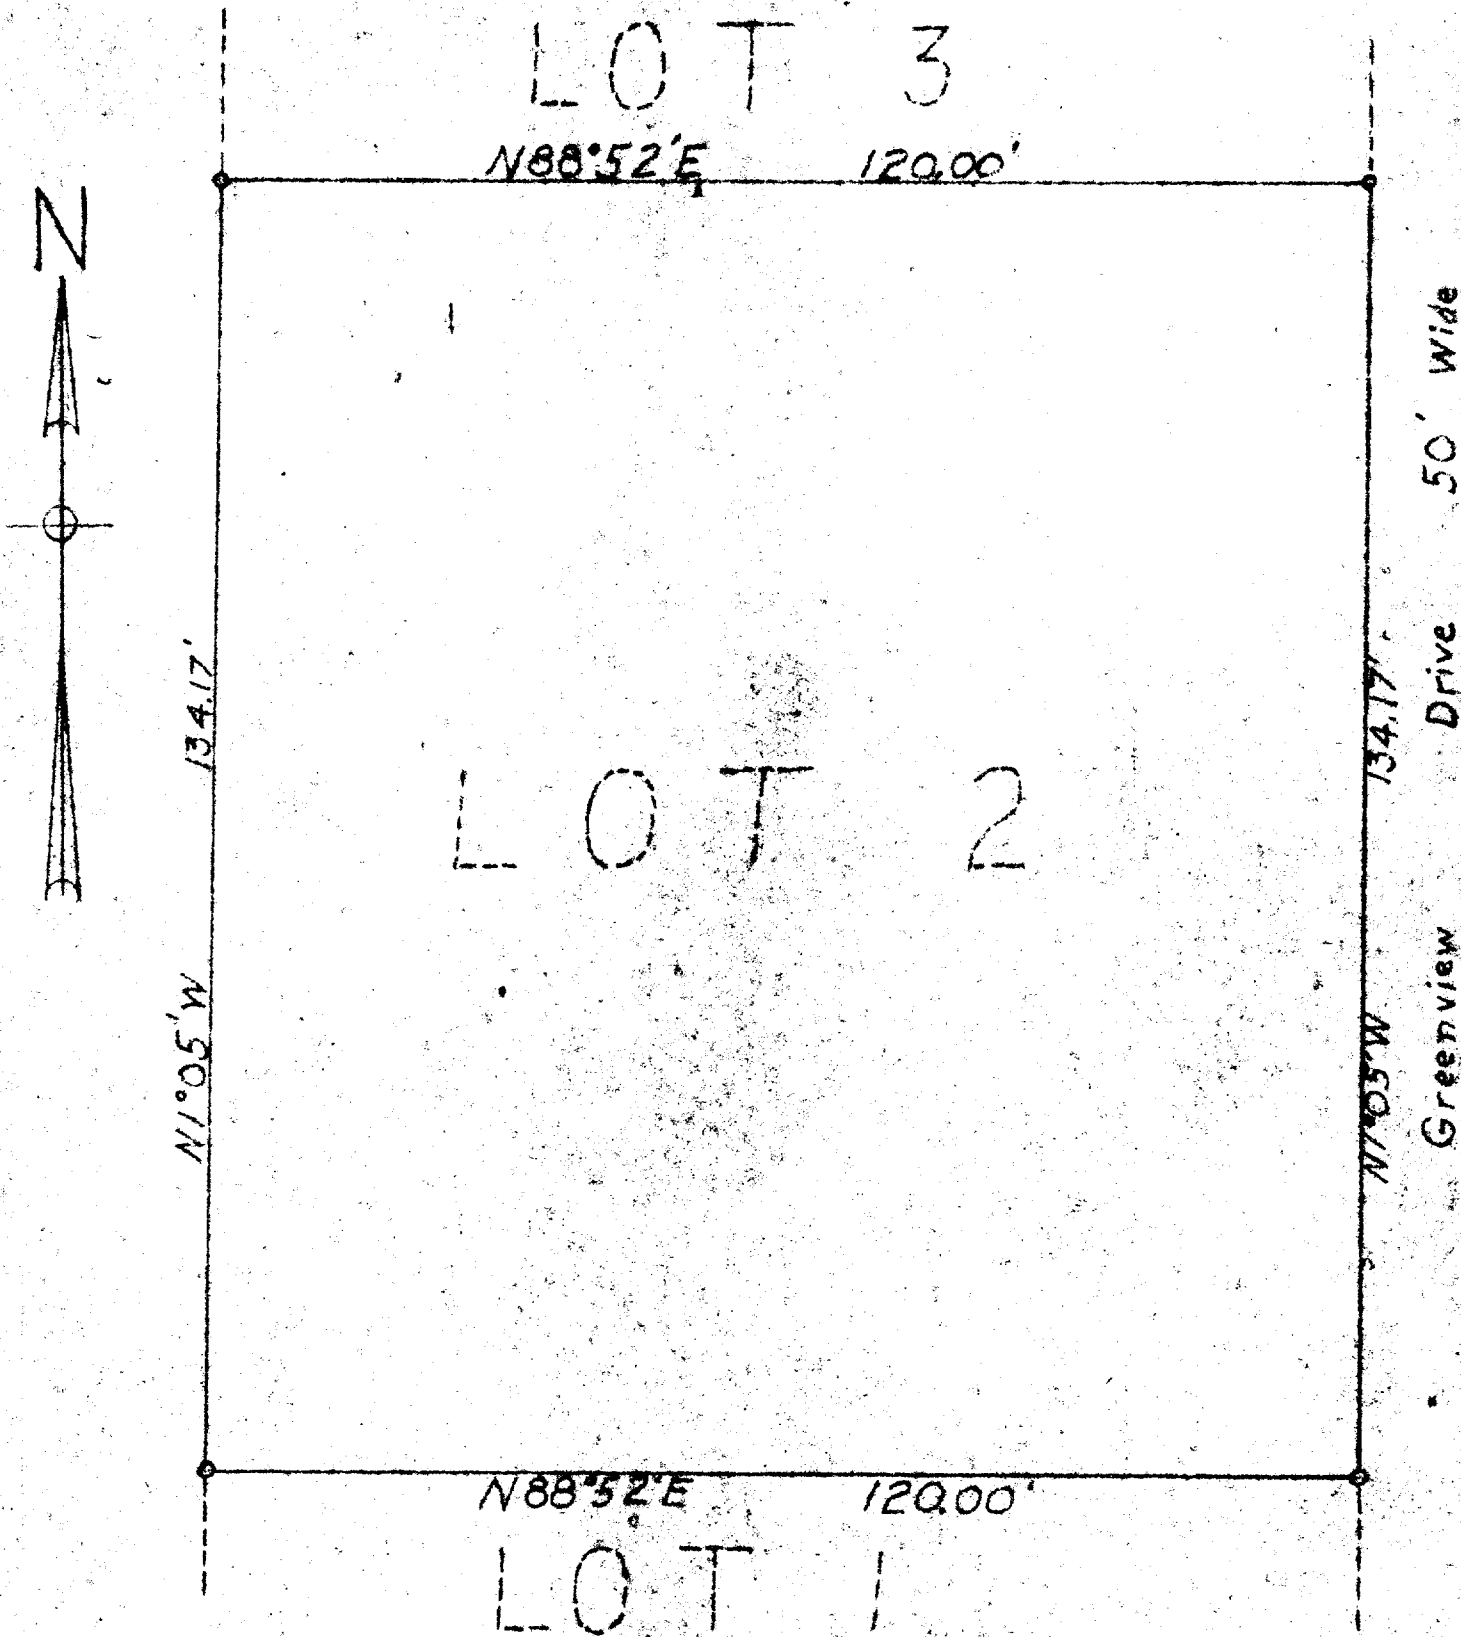

SURVEY AND PLAT BY

**JENSEN & JOHNSON**  
CIVIL ENGINEERS AND SURVEYORS

Elkhorn, Wisconsin

## LEGEND

- — Iron Pipe
  - — Concrete Monument
- Scale 1" = 20'

WE CERTIFY: That we have surveyed the above described property and that the plat shown herein is an accurate survey and a true representation thereof and correctly shows the exterior boundary lines and all divisions of said property.

Date JULY 1962

*Lloyd L. Jensen*  
LLOYD L. JENSEN, Partner

Wisconsin Registered Land Surveyor, No. S-211

ISHS-2