
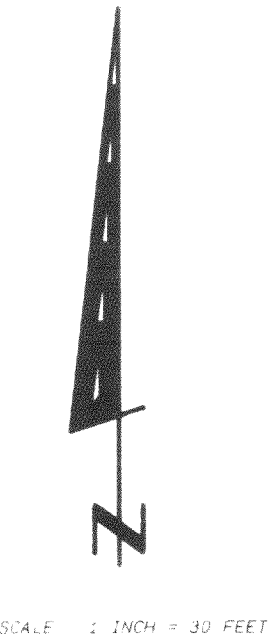


PLAT OF SURVEY

LEGAL DESCRIPTION AS FOUND VOL. 656, P. 2146, DOC# 388154


THE NORTH PART OF LOT 1, CERTIFIED SURVEY NO. 43, AS RECORDED IN VOLUME 1 OF CERTIFIED SURVEYS AT PAGE 43 IN THE OFFICE OF THE REGISTER OF DEEDS FOR WALWORTH COUNTY, WISCONSIN, DESCRIBED AS FOLLOWS: TO-WIT: BEGINNING AT THE MOST NORTHERLY CORNER OF SAID LOT 1; THENCE N 86°42'20" E 82.45 FEET; THENCE S 58°59'20" E 172.38 FEET; THENCE S 22°26' E 30.43 FEET; THENCE S 50°33' W 115.32 FEET; THENCE N 39°27' W 240.18 FEET TO THE PLACE OF BEGINNING, SAID PARCEL BEING PART OF LOTS 6 AND 7, BLOCK 1, ROWENA PARK SUBDIVISION, TOWN OF LINN, WALWORTH COUNTY, WISCONSIN.

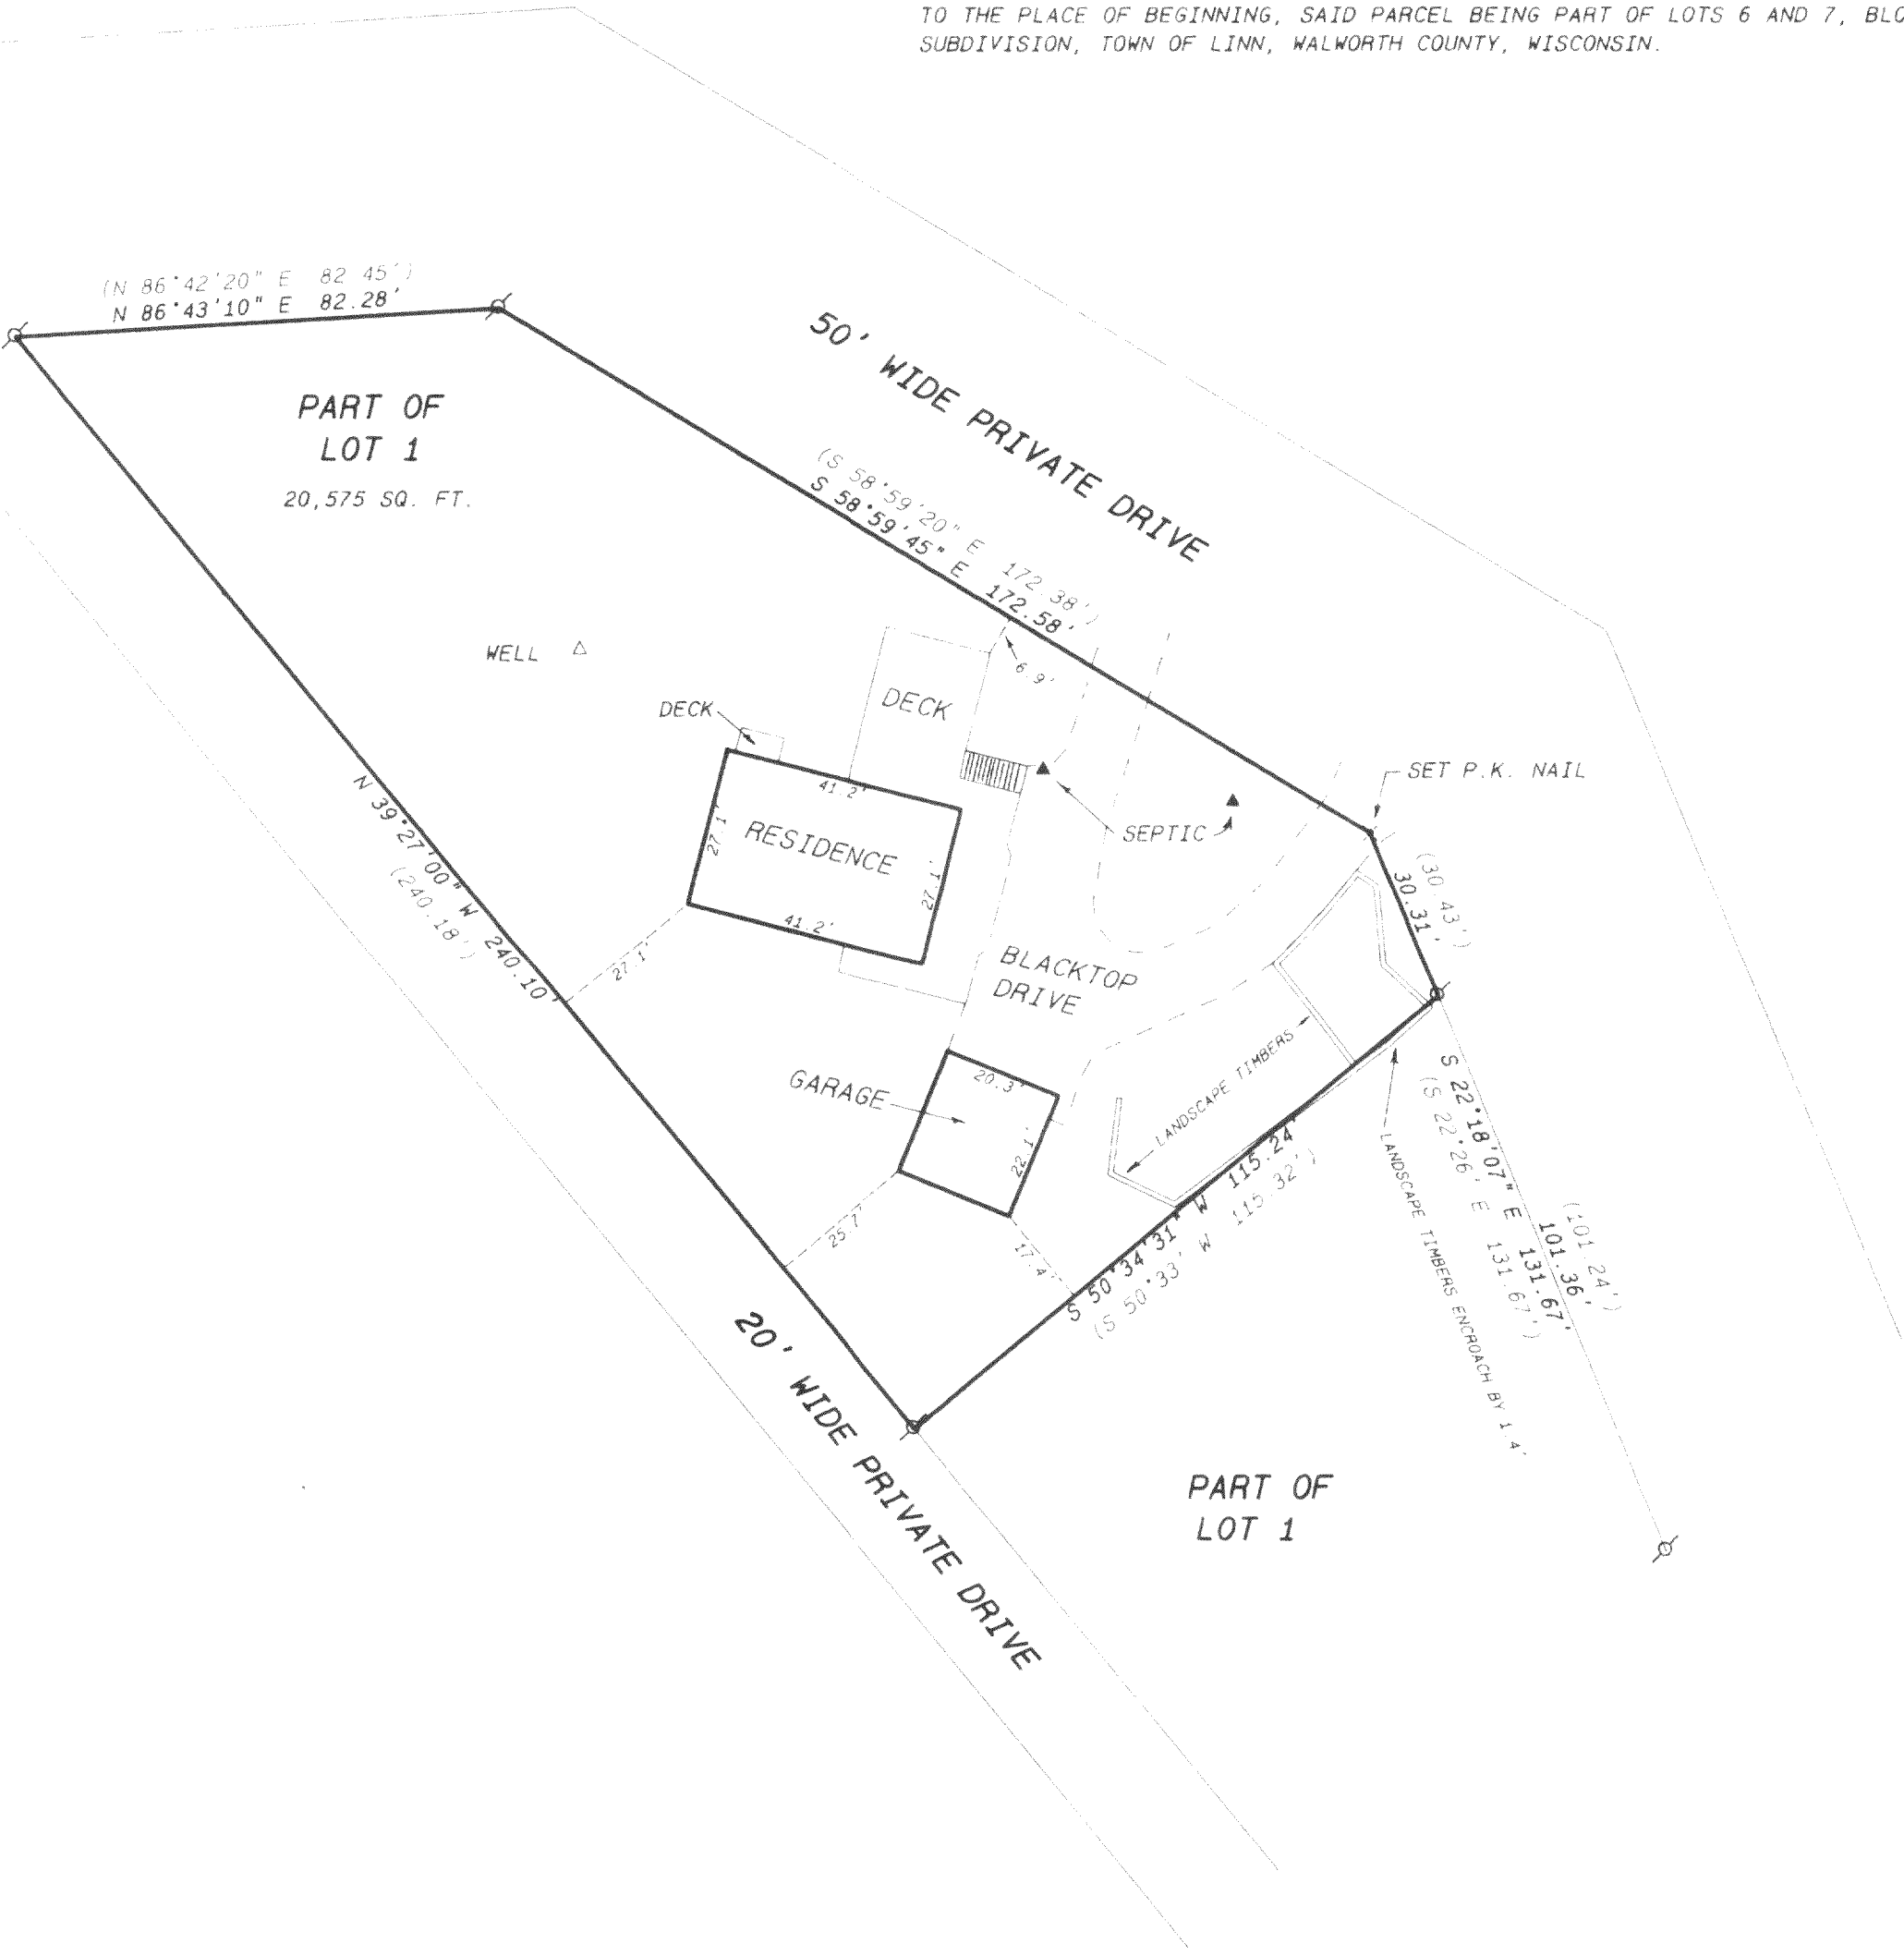

ORDERED BY: KARI SUE CLARK
OFFICE MANAGER
HOME DESIGN MANUFACTURING
POST OFFICE BOX 527
FONTANA, WISCONSIN 53125

OWNERS: PATRICK & LORAIN MARTIN

- Legend
- FOUND IRON PIPE
 - FOUND IRON ROD
 - FOUND BRASS CAPPED MONUMENT
 - FOUND CONCRETE MONUMENT
 - CHISEL CUT IN CONCRETE
 - SET IRON ROD, 24" LONG, WEIGHING 1.5 LBS. LINEAL FT. 3/4" DIA.
 - SET IRON ROD, 30" LONG, WEIGHING 4.5 LBS. LINEAL FT. 1 1/16" DIA.
 - RECORDED AS DIMENSION
 - EXISTING FENCE

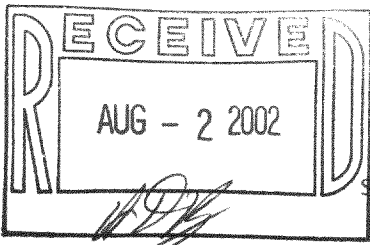

SCALE: 1" = 30 FEET



"I hereby certify that the above described property has been surveyed by me or under my direction and that the above map is a true representation thereof and shows the size and location of the property, its exterior boundaries, the location of all visible structures and dimensions of all principal buildings thereon, boundary lines, apparent easements, roadways and visible encroachments, if any."

"This survey is made for the use of the present owners of the property and those who purchase, mortgage, or guarantee the title thereto within one year from date hereof."

Kenneth B. Abernathy, Jr.

KENNETH B. ABERNATHY, JR.
WISCONSIN REGISTERED LAND SURVEYOR,
S-1594

Date: OCT. 12, 1998 Job No. 98-922