

PREPARED FOR:
JERRY POLEK
N1849 LORAMOO LN.
LAKE GENEVA, 53147


PLAT OF SURVEY

J.K. SURVEYING INC.
N3705 WILLOWBEND LANE
LAKE GENEVA, WI, 53147
262-248-3697

- OF -

LOT 2 CERTIFIED SURVEY MAP NO. 1211 LOCATED IN THE
SOUTHEAST 1/4 OF SECTION 11, T.1.N., R.17.E, WALWORTH
COUNTY, WISCONSIN.

LOT 1

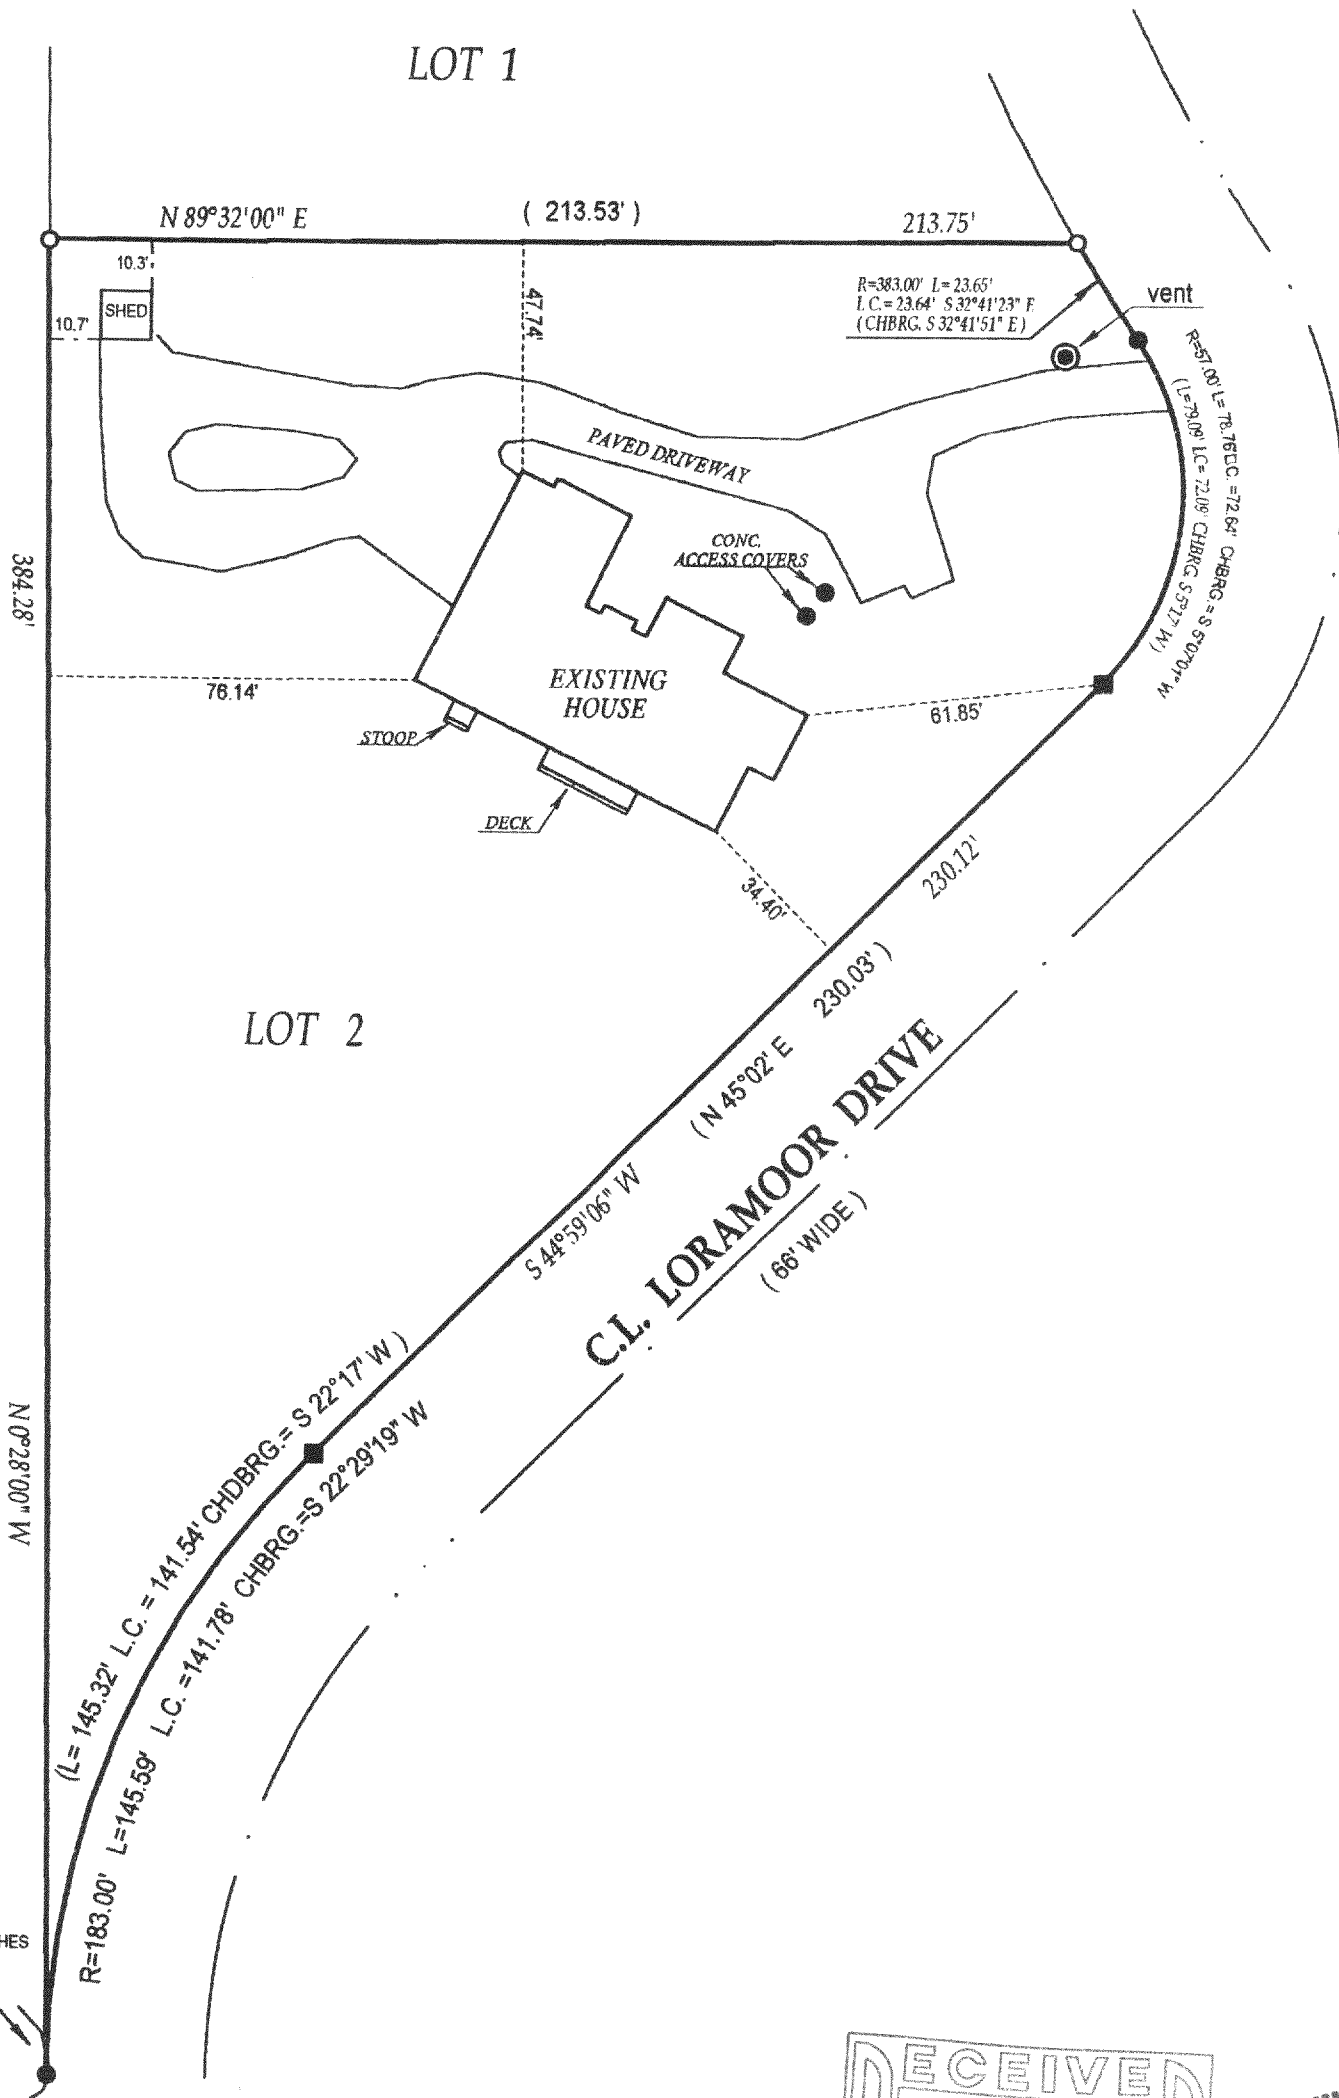

STONE PATIO ENCROACHES
0.8'

- () = recorded as
- = found iron bar
- = found iron pipe
- = set iron pipe
- = set iron bar

SCALE 1" = 40'

JOB # 02-264

TAX ID # 1A121100002



DATE OF LAST REVISION 6/17/2002

COMPARE LEGAL DESCRIPTION ABOVE AND DRAWING WITH DEED. FOR BUILDING RESTRICTIONS AND
EASEMENTS NOT SHOWN, REFER TO DEED, ABSTRACT SOURCES AND LOCAL MUNICIPAL CODES. NOTIFY
THE SURVEYOR IMMEDIATELY OF ANY DISCREPANCY.

"I hereby certify that I have surveyed the above described property and that
the above map is a true representation thereof and shows the size and
location of all visible structures, apparent easements and encroachments
if any."

This survey is made for the present owners of the property, and those who
purchase, mortgage, or guarantee the title thereto, within one year from
the date hereof.

DATED THIS 10 TH, DAY OF JUNE 20 02

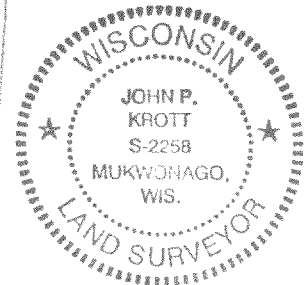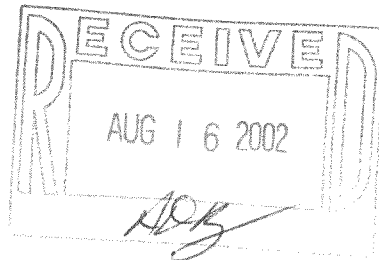

John P. Krott
JOHN KROTT S - 2258
Wisconsin Registered Land Surveyor
(original if signed in red)

117-2150