


ABELL SURVEYING & MAPPING

1140 SEQUOIA STREET • DELAVAN, WISCONSIN 53115
262-728-6737

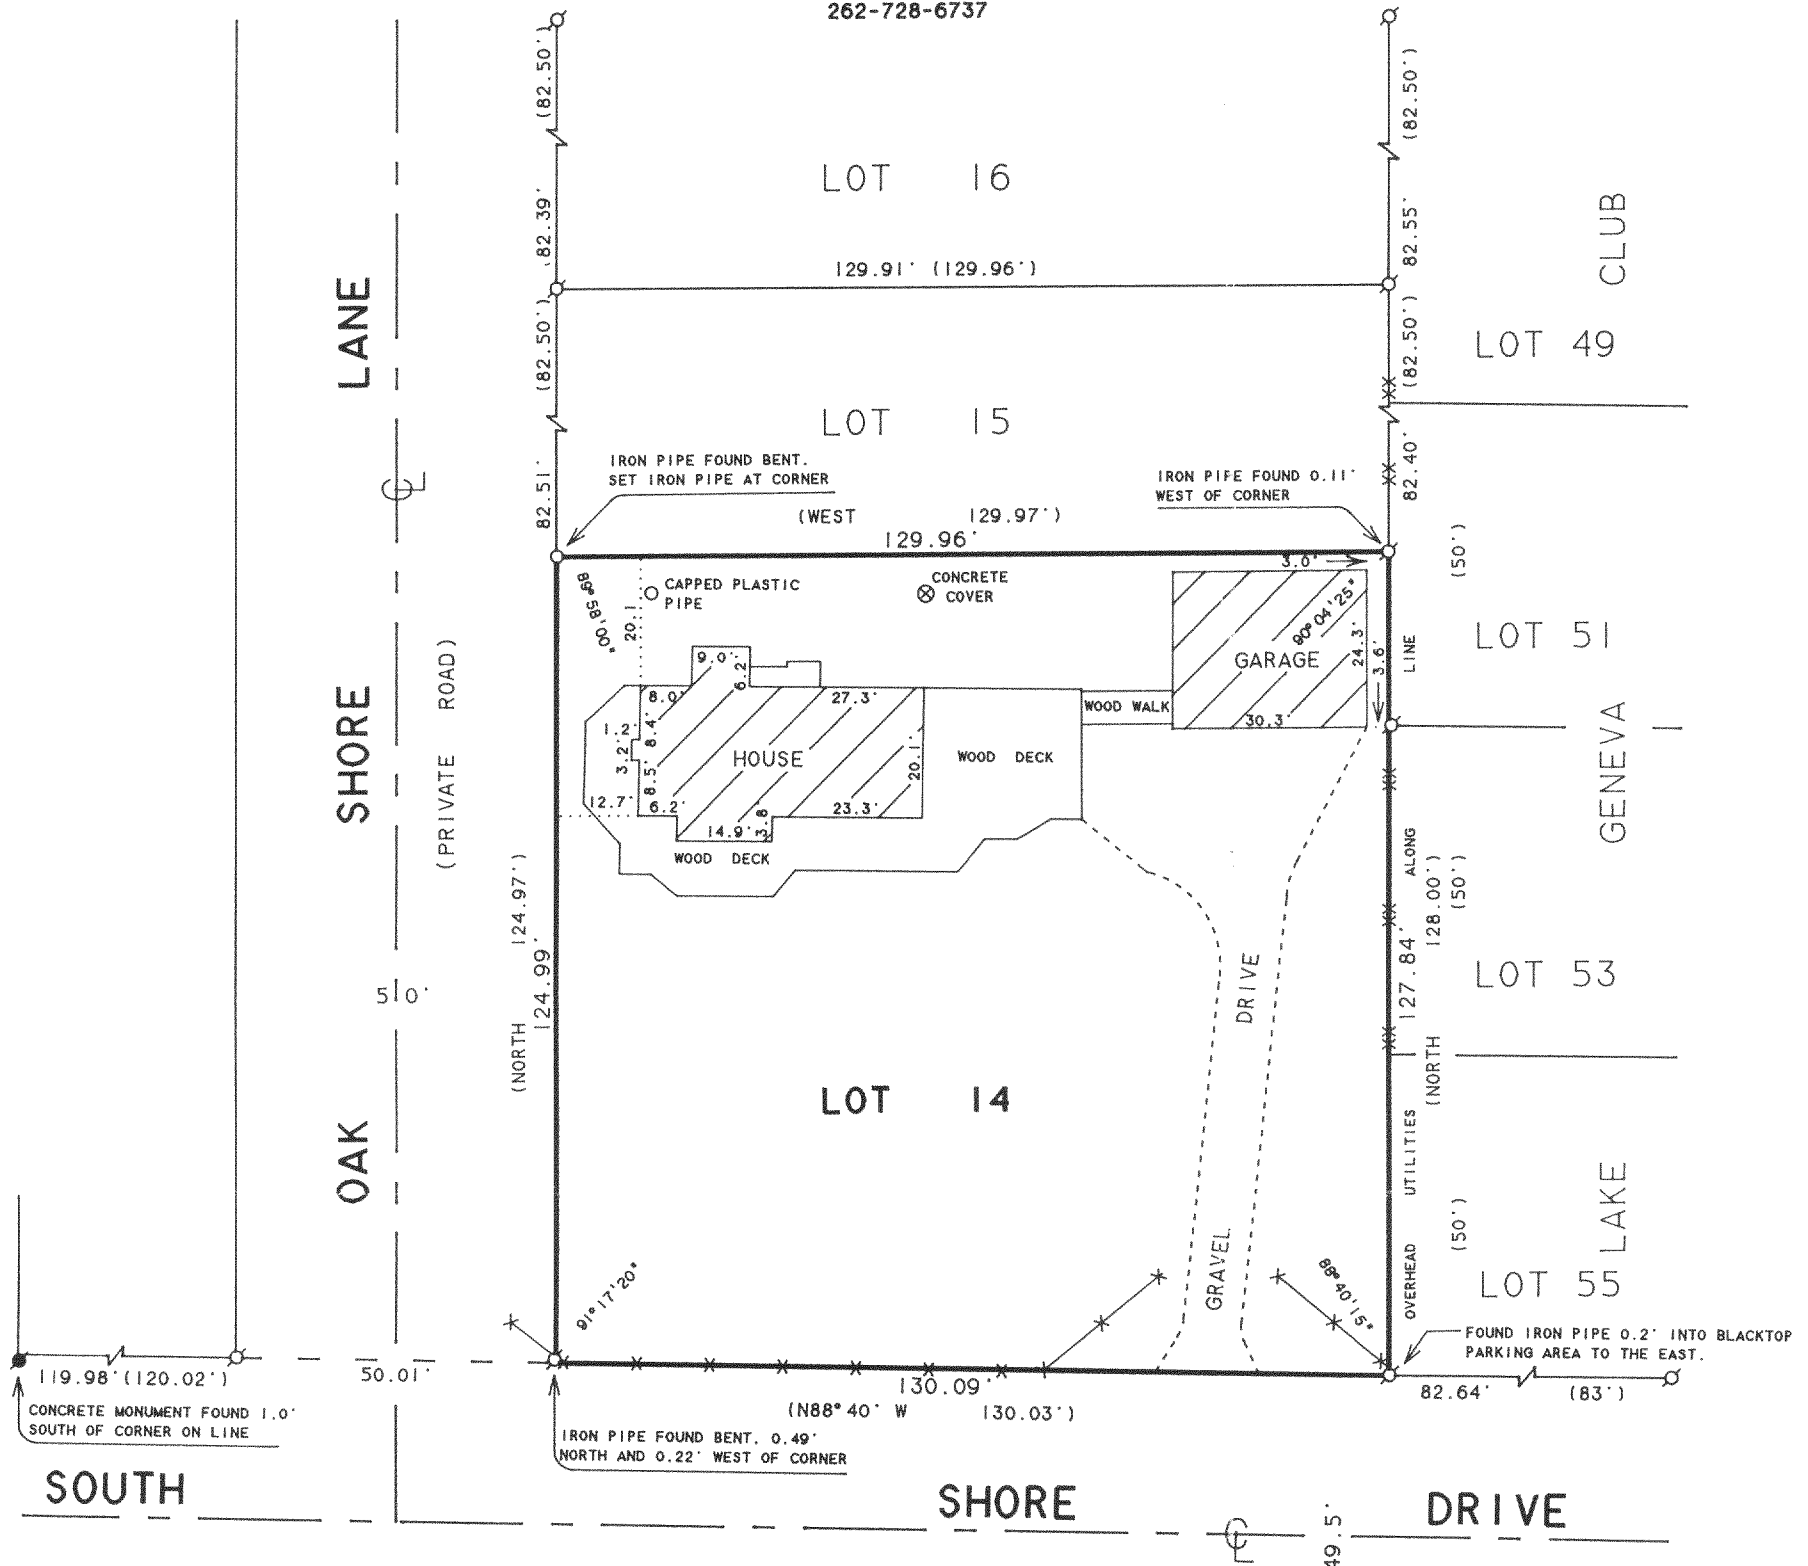

N



SCALE 1"=30'

LEGEND


- - IRON PIPE FOUND
- - CONCRETE MONUMENT FOUND
- - IRON PIPE SET, found 6/6/02
- XX-XX - BOARD FENCE
- X-X- - WOOD FENCE
- () - RECORDED AS

ORDERED BY: JAMES MCGREEVY
RT 1, BOX 390D
FONTANA, WI. 53125

REVISED AND RECERTIFIED JUNE 6, 2002
ORDERED BY: RE/MAX GENEVA REALTY, LTD.
101 BROAD STREET
LAKE GENEVA, WI 53147

PLAT OF SURVEY OF

LOT 14, OAK SHORES LOCATED IN TIN.
R17E, WALWORTH COUNTY, WISCONSIN.

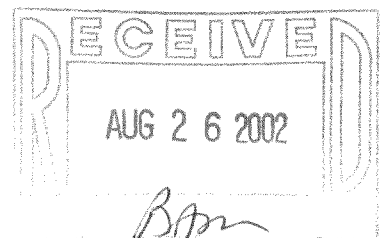

I HEREBY CERTIFY THAT I HAVE SURVEYED THE ABOVE DESCRIBED PROPERTY AND THAT THE ABOVE MAP IS A TRUE REPRESENTATION THEREOF AND SHOWS THE SIZE AND LOCATION OF THE PROPERTY, ITS EXTERIOR BOUNDARIES, THE LOCATION OF ALL VISIBLE STRUCTURES AND DIMENSIONS OF ALL PRINCIPAL BUILDINGS THEREON, BOUNDARY FENCES, APPARENT EASEMENTS, ROADWAYS AND VISIBLE ENCROACHMENTS, IF ANY, TO THE BEST OF MY KNOWLEDGE AND BELIEF.

THIS SURVEY IS MADE FOR THE USE OF THE PRESENT OWNERS OF THE PROPERTY, AND ALSO THOSE WHO PURCHASE, MORTGAGE, OR GUARANTEE THE TITLE THERETO WITHIN ONE (1) YEAR FROM DATE HEREON.

David F. Abell

DAVID F. ABELL
WISCONSIN REGISTERED LAND SURVEYOR, S-1596

February 18, 1992

DATE JOB NUMBER - 92021A
NOTE: THIS IS NOT A CERTIFIED COPY UNLESS SEALED.

LO 14

117-2157