


IGV-17

Plat of Survey

of
Lot 2 of Block 5 of Genevista,
a subdivision located in the Southwest 1/4 of
the Southwest 1/4 of Section 10, Town 1 North,
Range 17 East, Town of Linn, Walworth County,
Wisconsin


Surveyed for: **Remax Geneva Realty**
101 Broad Street • Suite 102
Lake Geneva, Wisconsin 53147

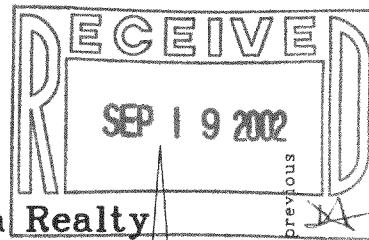

Bearings reference to previous
surveys of record.

First Street

Linwood Avenue (50' Wide)

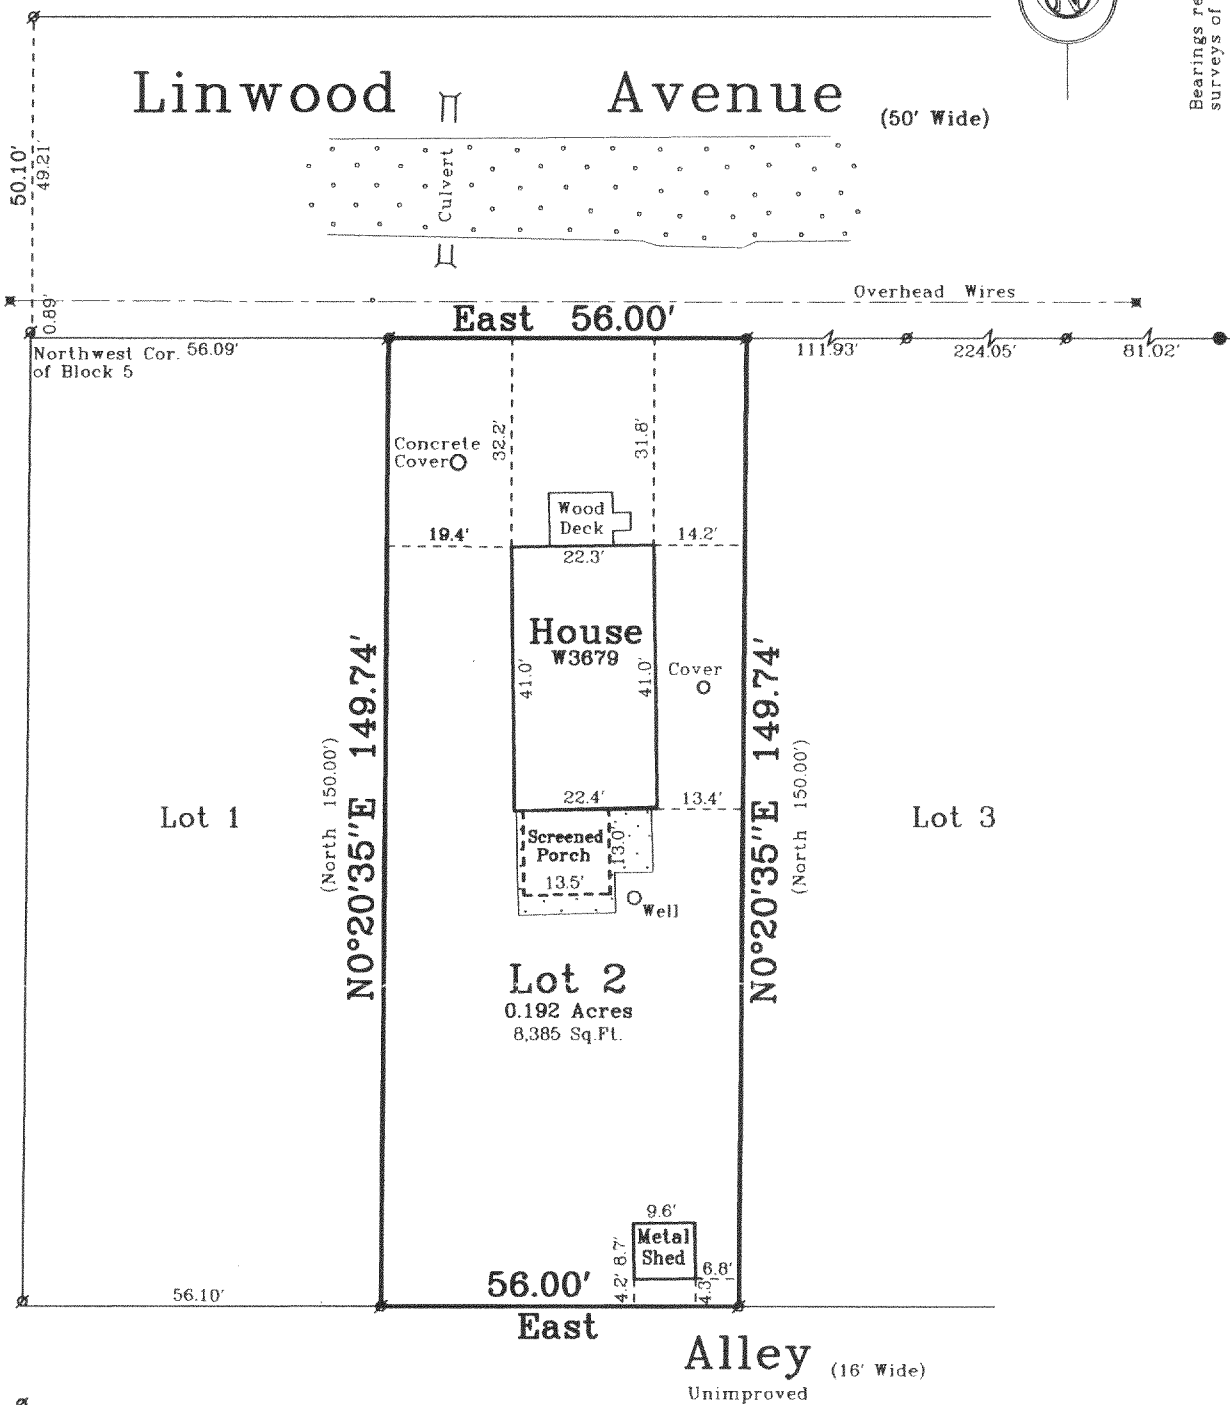


Notes: 1) This survey is subject to Wisconsin lien laws. 2) This survey plat is not
This Plat of Survey is the notice of intent certified unless signed
to file lien. Lien waiver required. and sealed in red ink.

Copyright © 2001 by Jensen & Olson Land Surveying, LLC.

All rights reserved. No part of this survey plat may be reproduced
or transmitted in any form by any means - graphic, electronic, or
mechanical, including photocopying, tracing, or information storage
and retrieval systems - without permission in writing from Douglas
G. Olson, Jensen & Olson Land Surveying, LLC.

I, Douglas G. Olson, Wisconsin Registered Land Surveyor,
do hereby certify that this survey was performed by me or under my
direction in full compliance with the owner's/agent's instructions
and Chapter A-E 7 of the Wisconsin Administrative Code "Minimum
Standards for Property Surveys" and that this map is an accurate
representation thereof to the best of my knowledge and belief.

Douglas G. Olson
Wisconsin Registered Land Surveyor - 2093

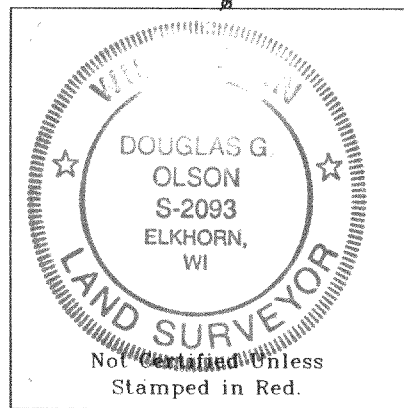

Jensen & Olson Land Surveying, LLC

45 South Wisconsin Street • P.O. Box 322
Elkhorn, Wisconsin 53121
Telephone: (262) 723-3434
Facsimile: (262) 723-8044
Scale in feet: 1"=30'

Legend

- Found Iron Pipe
- Found Iron Rod
- of Recorded Information
- Asphalt Surface
- Utility Pole
- Concrete Patio



Survey date: Aug. 21, 2001.
Revisions:

Sheet 1 of 1 Sheets.

Job Reference No.
2001.112

117-2161