
ANDERSTAPPEN SURVEYING, INC. 217 W. Judd Street Woodstock, Illinois 60098 (815) 337-8310

PLAT OF SURVEY

Lots 11 and 13 in Shorehaven Subdivision, being a Subdivision of part of Section 18, Township 1 North, Range 17 East, in Linn Township, Walworth County, Wisconsin.



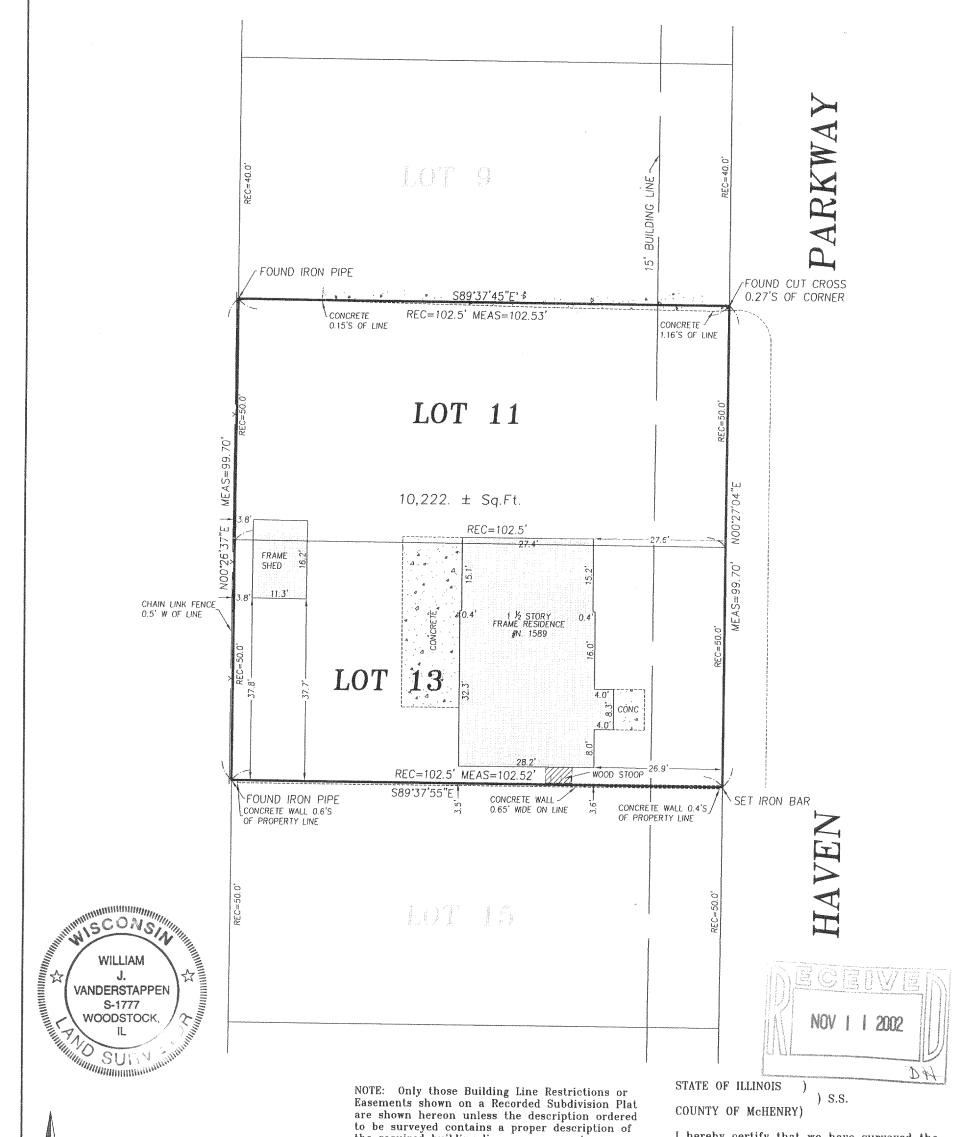

CLIENT: DAVID NUTT

DRAWN BY: APG CHK'ED BY: WJV SCALE: 1"=20' __ SEC. <u>18 T. 1 R. 17 E</u>.

P.I.N.: LINN TOWNSHIP, WI

JOB NO.: 001060 I.D. LSS BK. 26 PG. 73 ALL DISTANCES SHOWN IN FEET AND DECIMAL PARTS THEREOF CORRECTED TO $68^{\circ}\ \mathrm{F.}$

are shown hereon unless the description ordered to be surveyed contains a proper description of the required building lines or easements.

- * No distance should be assumed by scaling.
- * No underground improvements have been located unless shown and noted.
- No representation as to ownership, use, or possession should be hereon implied.
- This Survey and Plat of Survey are void without original embossed or colored seal and signature

Compare your description and site markings with this plat and AT ONCE report any discrepancies which you may find.

I hereby certify that we have surveyed the premises above described, and that the plat hereon is a true representation of said survey.

Dated at Woodstock,

McHenry County, Illinois 12/15 ,A.D., 2000.

VANDERSTAPPEN SURVEYING, INC.

do William & Straffich Com Wisconsin Professional Land Surveyor No. 1777-008

ISA - 12