

ABERNATHY and ASSOCIATES

Kenneth B. Abernathy Jr.

Wisconsin Registered Land Surveyor S-1594



W4056 BRAY RD.
ELKHORN, WI. 53121
PHONE: (262) 723-4260 (OFFICE)
(262) 723-7209 (FAX)
Email: abernathy@elknet.net

PLAT OF SURVEY

LOT 2 OF CERTIFIED SURVEY MAP NO. 3036 AS RECORDED IN VOL. 16 OF CERTIFIED SURVEY MAPS AS PAGES 151 AND 152 AS DOCUMENT NO. 396590, BEING LOCATED IN THE SOUTHWEST 1/4 OF THE SOUTHWEST 1/4 OF SECTION 9, TOWN 1 NORTH, RANGE 17 EAST, TOWN OF LINN, WALWORTH COUNTY, WISCONSIN.


OWNER:
JOHN GRUD
2456 SARANAC LANE
GLENVIEW, IL 60025

BUILDER:
JOHN TIERNEY
1022 SAUGANASH DR.
FONTANA, WI 53125

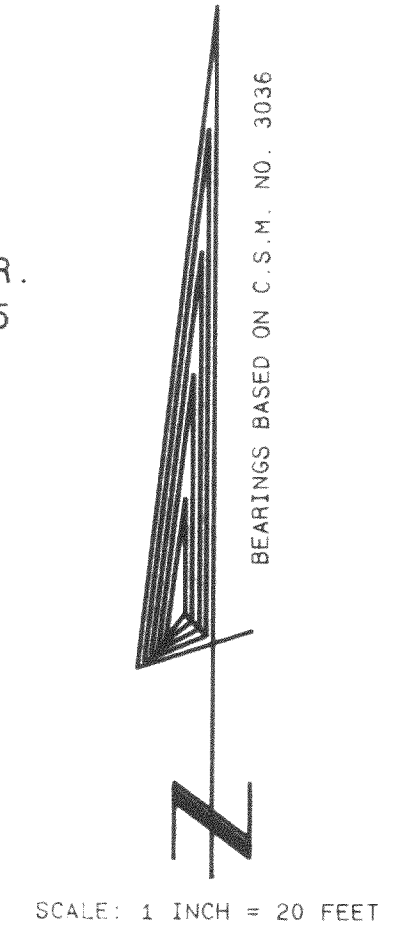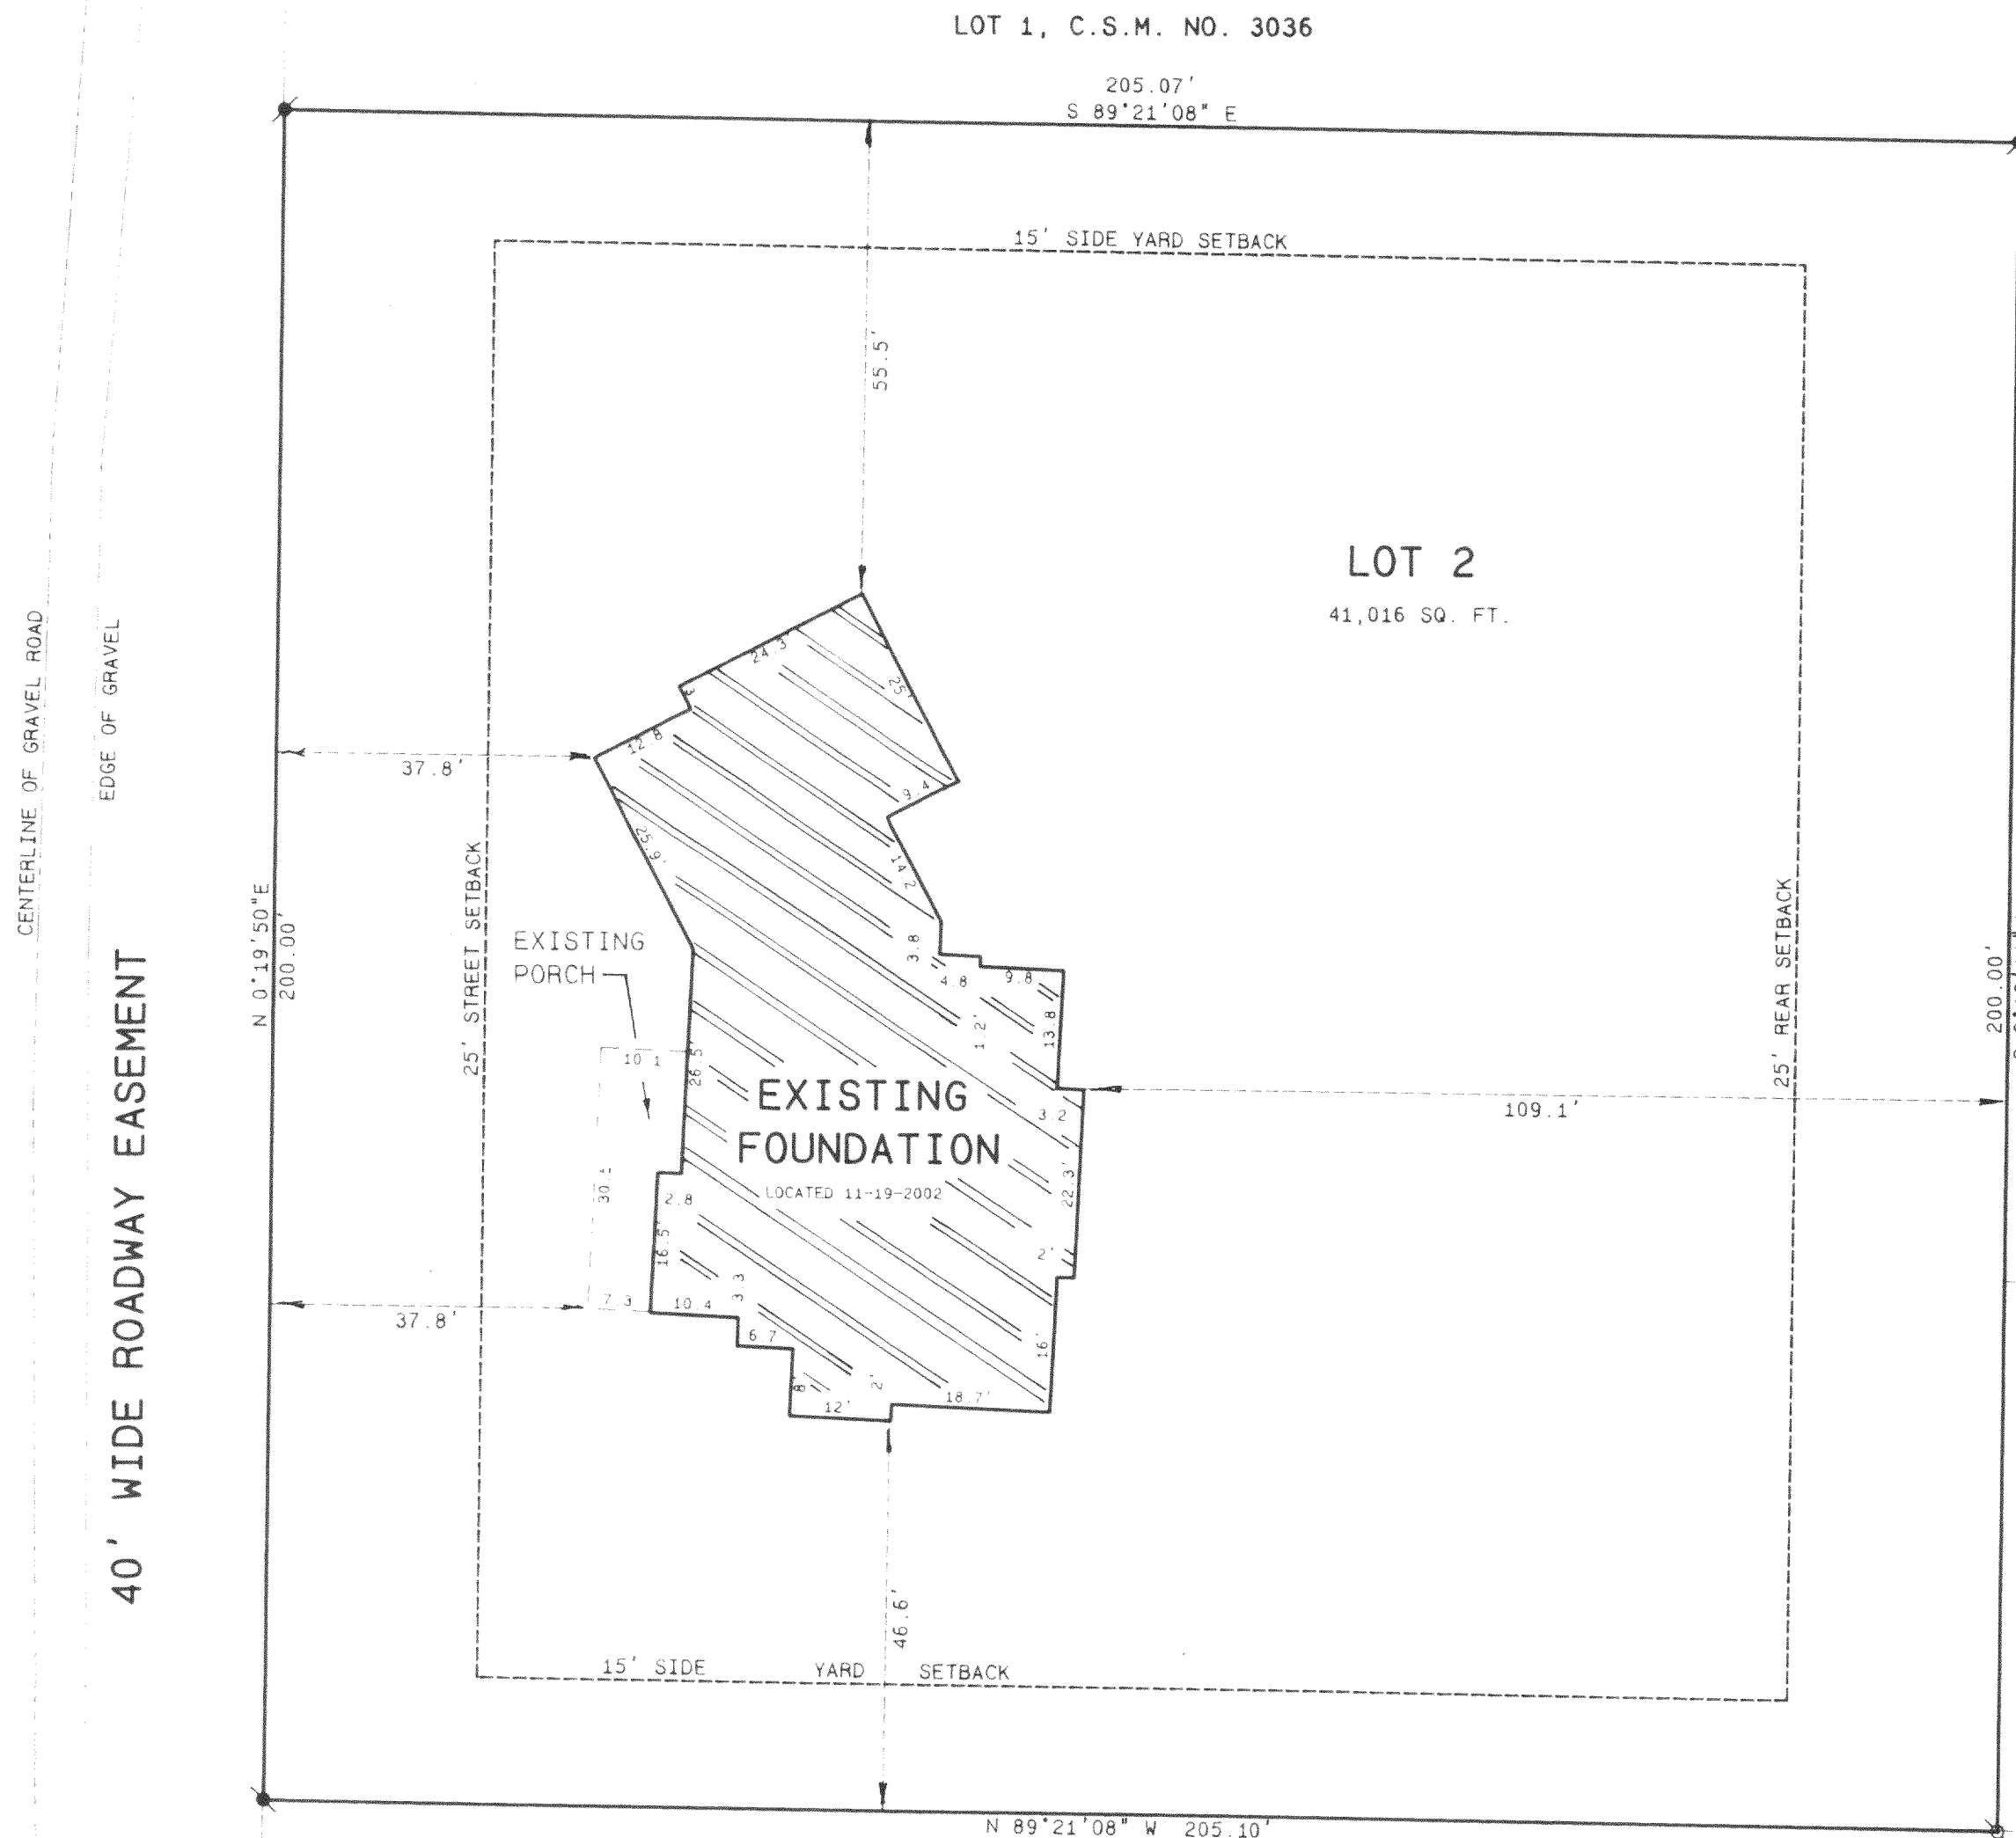


Legend

- FOUND IRON PIPE
- FOUND IRON ROD
- FOUND BRASS CAPPED MONUMENT
- FOUND CONCRETE MONUMENT
- CHISEL CUT IN CONCRETE
- SET IRON ROD, 24" LONG, WEIGHING 1.5 LBS. LINEAL FT. 3/4" DIA
- SET IRON ROD, 30" LONG, WEIGHING 4.5 LBS. LINEAL FT. 1 1/16" DIA
- RECORDED AS DIMENSION
- EXISTING FENCE

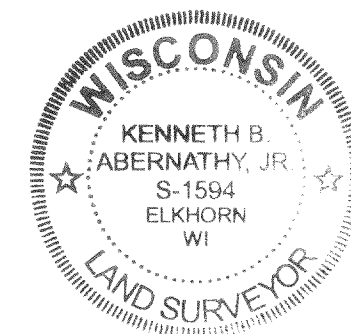

SCALE: 1" = 20 FEET

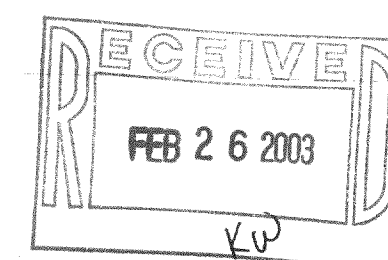

REVISED NOVEMBER 21, 2002 TO SHOW FOUNDATION "AS BUILT"

I hereby certify that the above described plat has been surveyed by me or under my direction, and that the plat is a true representation thereof and shows the size and location of the property, its external boundaries, the location of all monuments, and dimensions of all principal buildings, structures, boundary lines, apparent easements, roadways, and visible encroachments, if any.

This survey is made for the use of the present owners of the property, and also those who purchase mortgage or guarantee that the property within one year from date hereof.

Kenneth B. Abernathy, Jr.

KENNETH B. ABERNATHY, JR.
WISCONSIN REGISTERED LAND SURVEYOR,
S-1594

Date: 9-20-02 Job No. 98.812