
DUNHAM SURVEYING, S.C. SURVEYING & SUBDIVIDING DELAVAN, WISCONSIN 53115

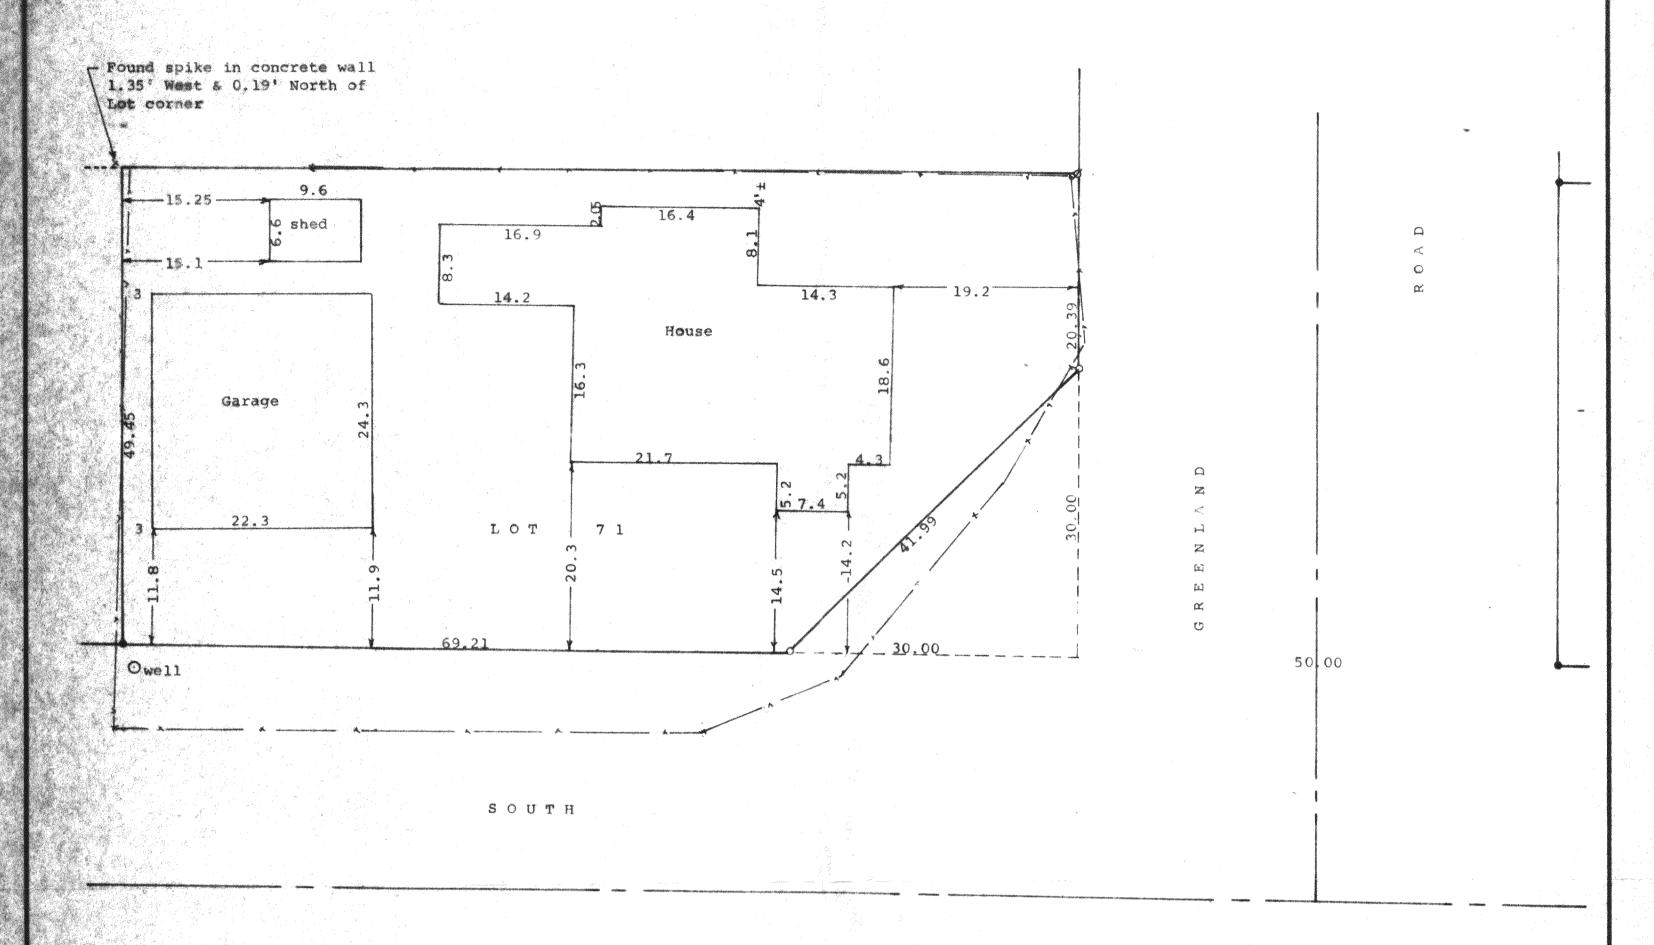

ROAD

Scale - 1" = 10' p = 3/4" Iron Pipe Pound ⇒ = 3/4" Iron Rod Found O = 3" Iron Pipe Set Survey ordered by:

STATE OF WISCONSIN)
COUNTY OF WALWORTH)


I, George T. Dunham, Surveyor, certify that I have surveyed the

property described as follows:

Lot 71 (except that part taken for road, which part is described as follows: From a point 30 feet West of the southeast corner of said lot, northeast to a point 30 feet north of the southeast corner; thence South 30 feet to said southeast corner; thence West to the place of beginning, in Lake Geneva Highlands, a subdivision by Taylor and Powers of the East 1/3 except the east 100 feet thereof) of the North & of the Southeast fractional & of Section 8, Tsp 1NR17E of the 4th P.M., all in Walworth County and State of Wisconsin,

and that the plat shown hereon is a correct representation thereof and shows the size and location of the property, its exterior boundaries, the location of all visible structures and dimensions of all principal buildings thereon, boundary fences, apparent easements, roadways and visible encroachments, if any, and that I have surveyed the property hereon described, according to the official records, to the best of my knowledge and belief. September 17, 1998

George T. Dunham, Surveyor

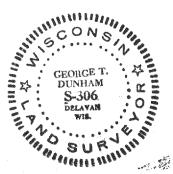



Ralph Hummel

Antioch, IL 60002

25470 West Grasslake Road