


DUNHAM SURVEYING, S.C.
SURVEYING & SUBDIVIDING
DELAVER, WISCONSIN 53115

N

Scale - 1" = 30'
 * = 1/2" Iron Pipe Found
 o = 3/4" Iron Pipe Found
 x = Bent 1/2" X 24" Iron Pipe Found and reset
 (0.00) = recorded distance
 Bearings referenced to the west line of Fair Oaks Road with the assumed bearing of North-South
 Survey ordered by: Rauland Agency
 Walworth, WI 53184
 Updating and recertification ordered by:
 George Bever
 W3907 Orchard Road
 Lake Geneva, WI 53147

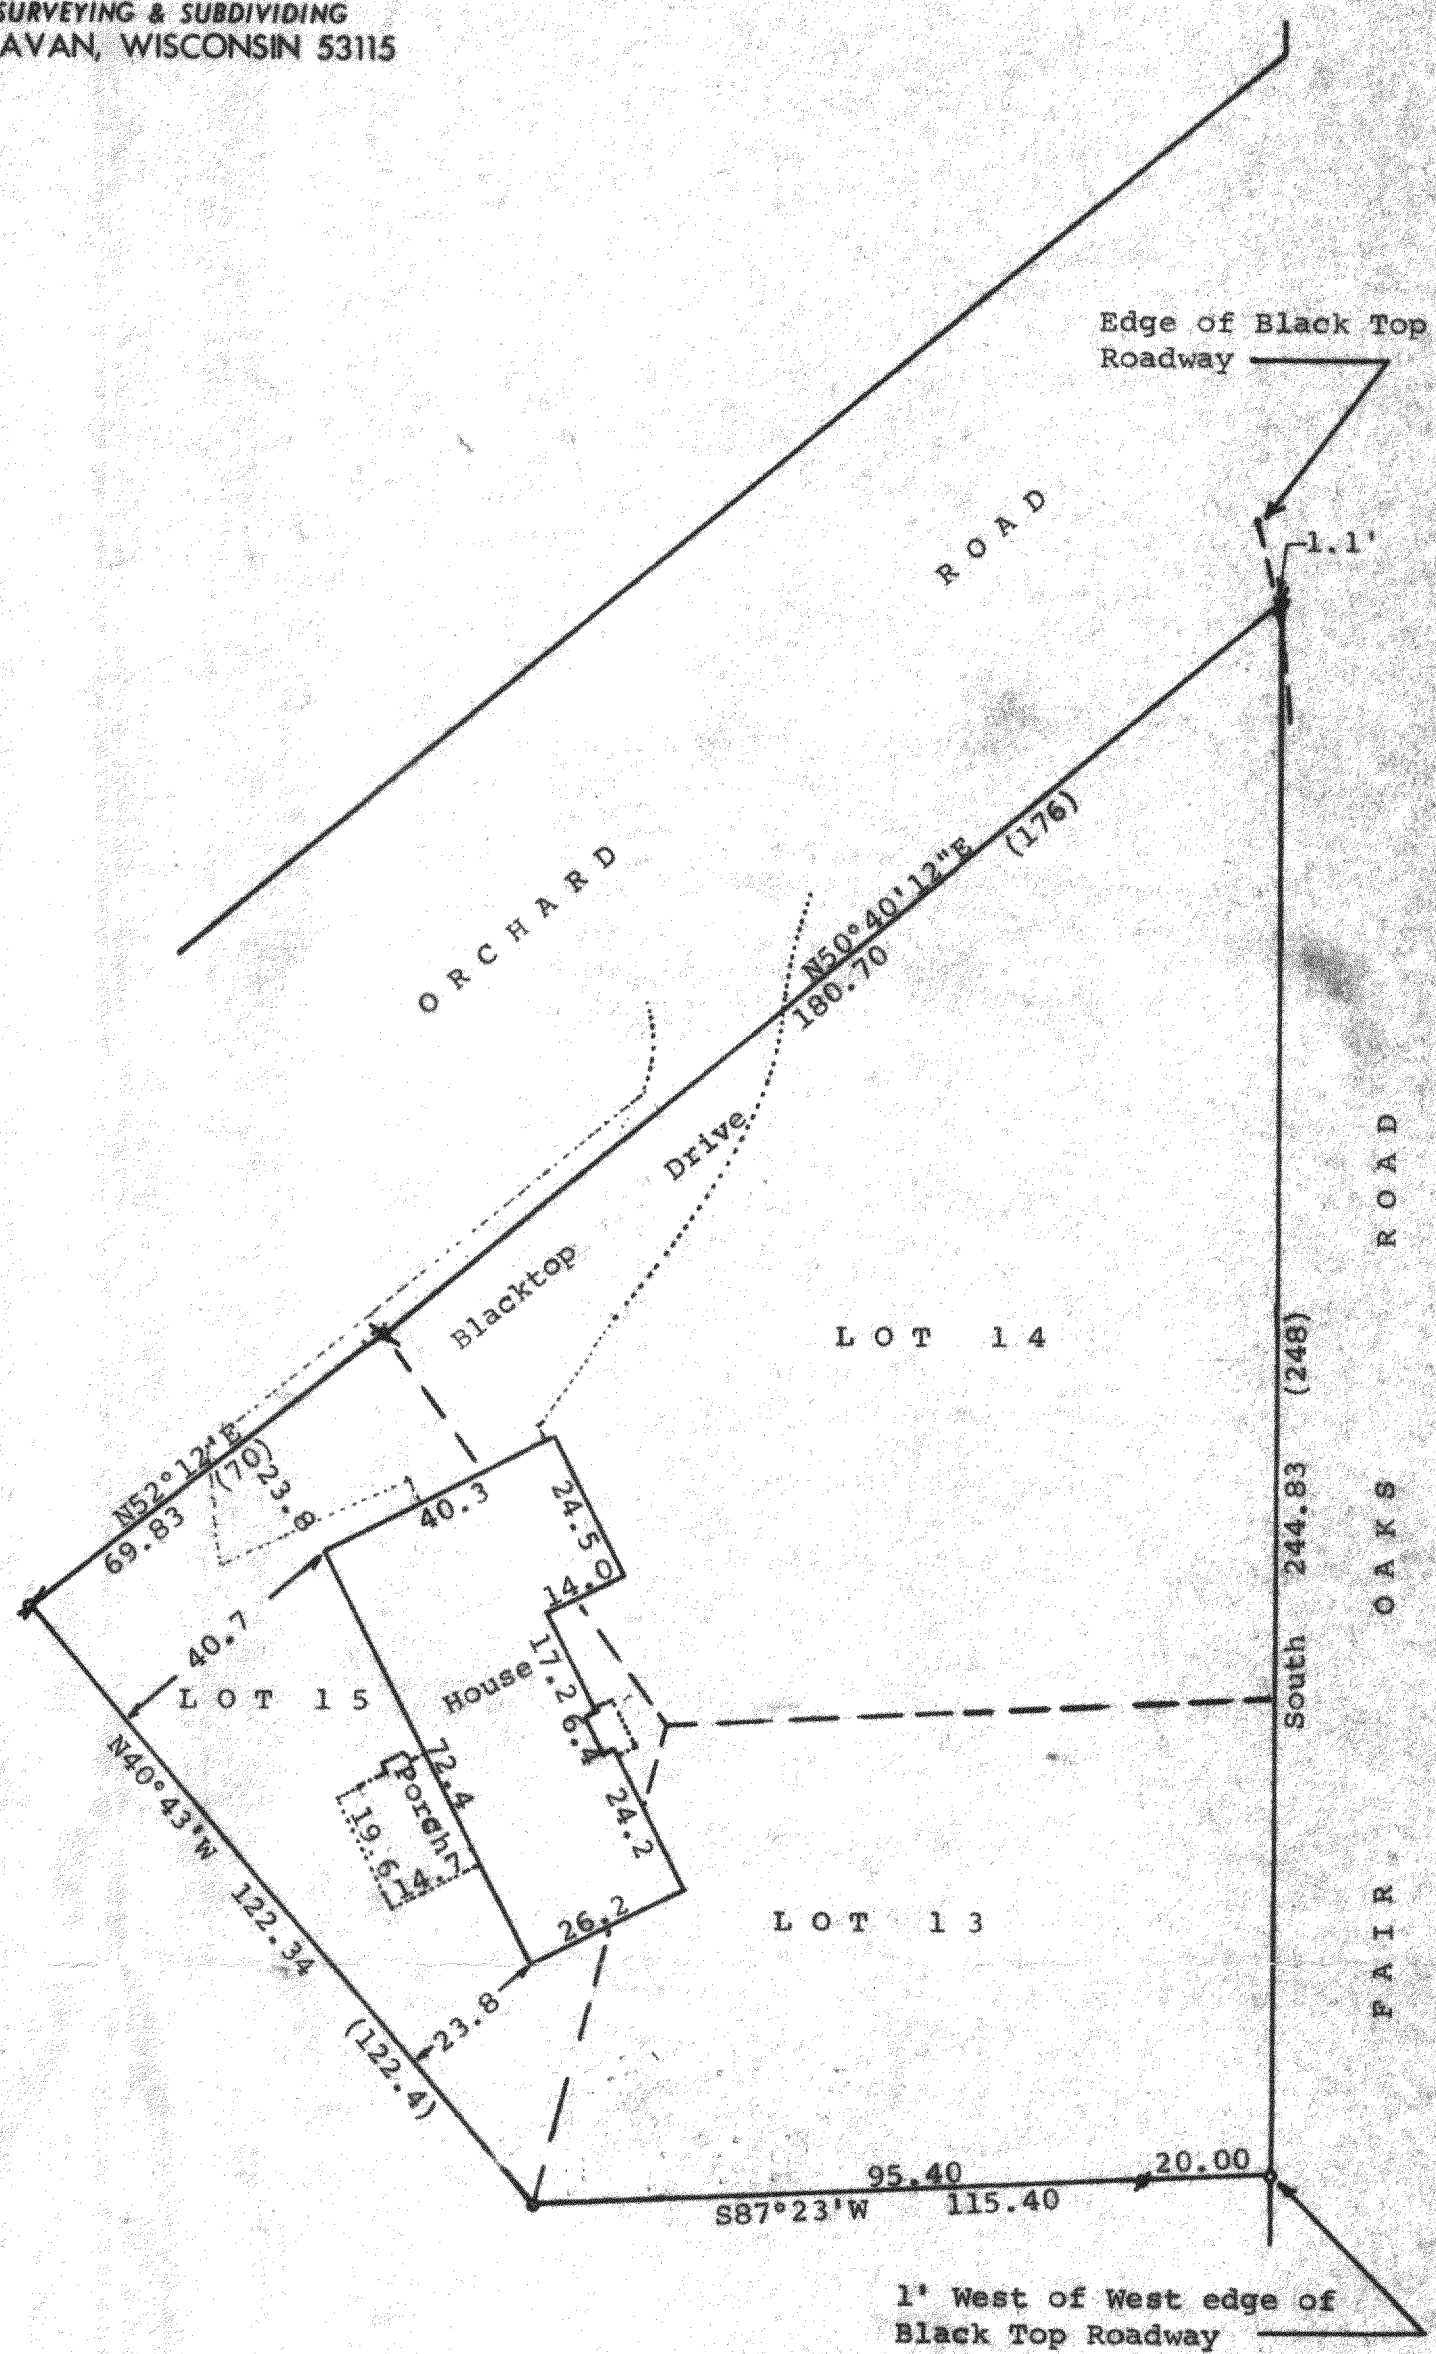

STATE OF WISCONSIN) SS
COUNTY OF WALWORTH)

I, George T. Dunham, Surveyor, certify that I have surveyed the property described as follows:
 Lots 13, 14, and 15, Block 10 of Wooddale Addition, a subdivision located in Fractional Section 9 and in Section 16, T 1 N, R 17 E, Walworth County, Wisconsin, and that the map shown above is a true representation thereof and shows the size and location of the property, its exterior boundaries, the location of all boundary fences, apparent easements, roadways and visible encroachments, if any, and that I have surveyed the property hereon described according to the official records, to the best of my knowledge and belief.

November 13, 1985

Updated and recertified to 5/14/01

George T. Dunham
George T. Dunham, Surveyor

