


DUNHAM SURVEYING, S.C.
SURVEYING & SUBDIVIDING
DELAVER, WISCONSIN 53115

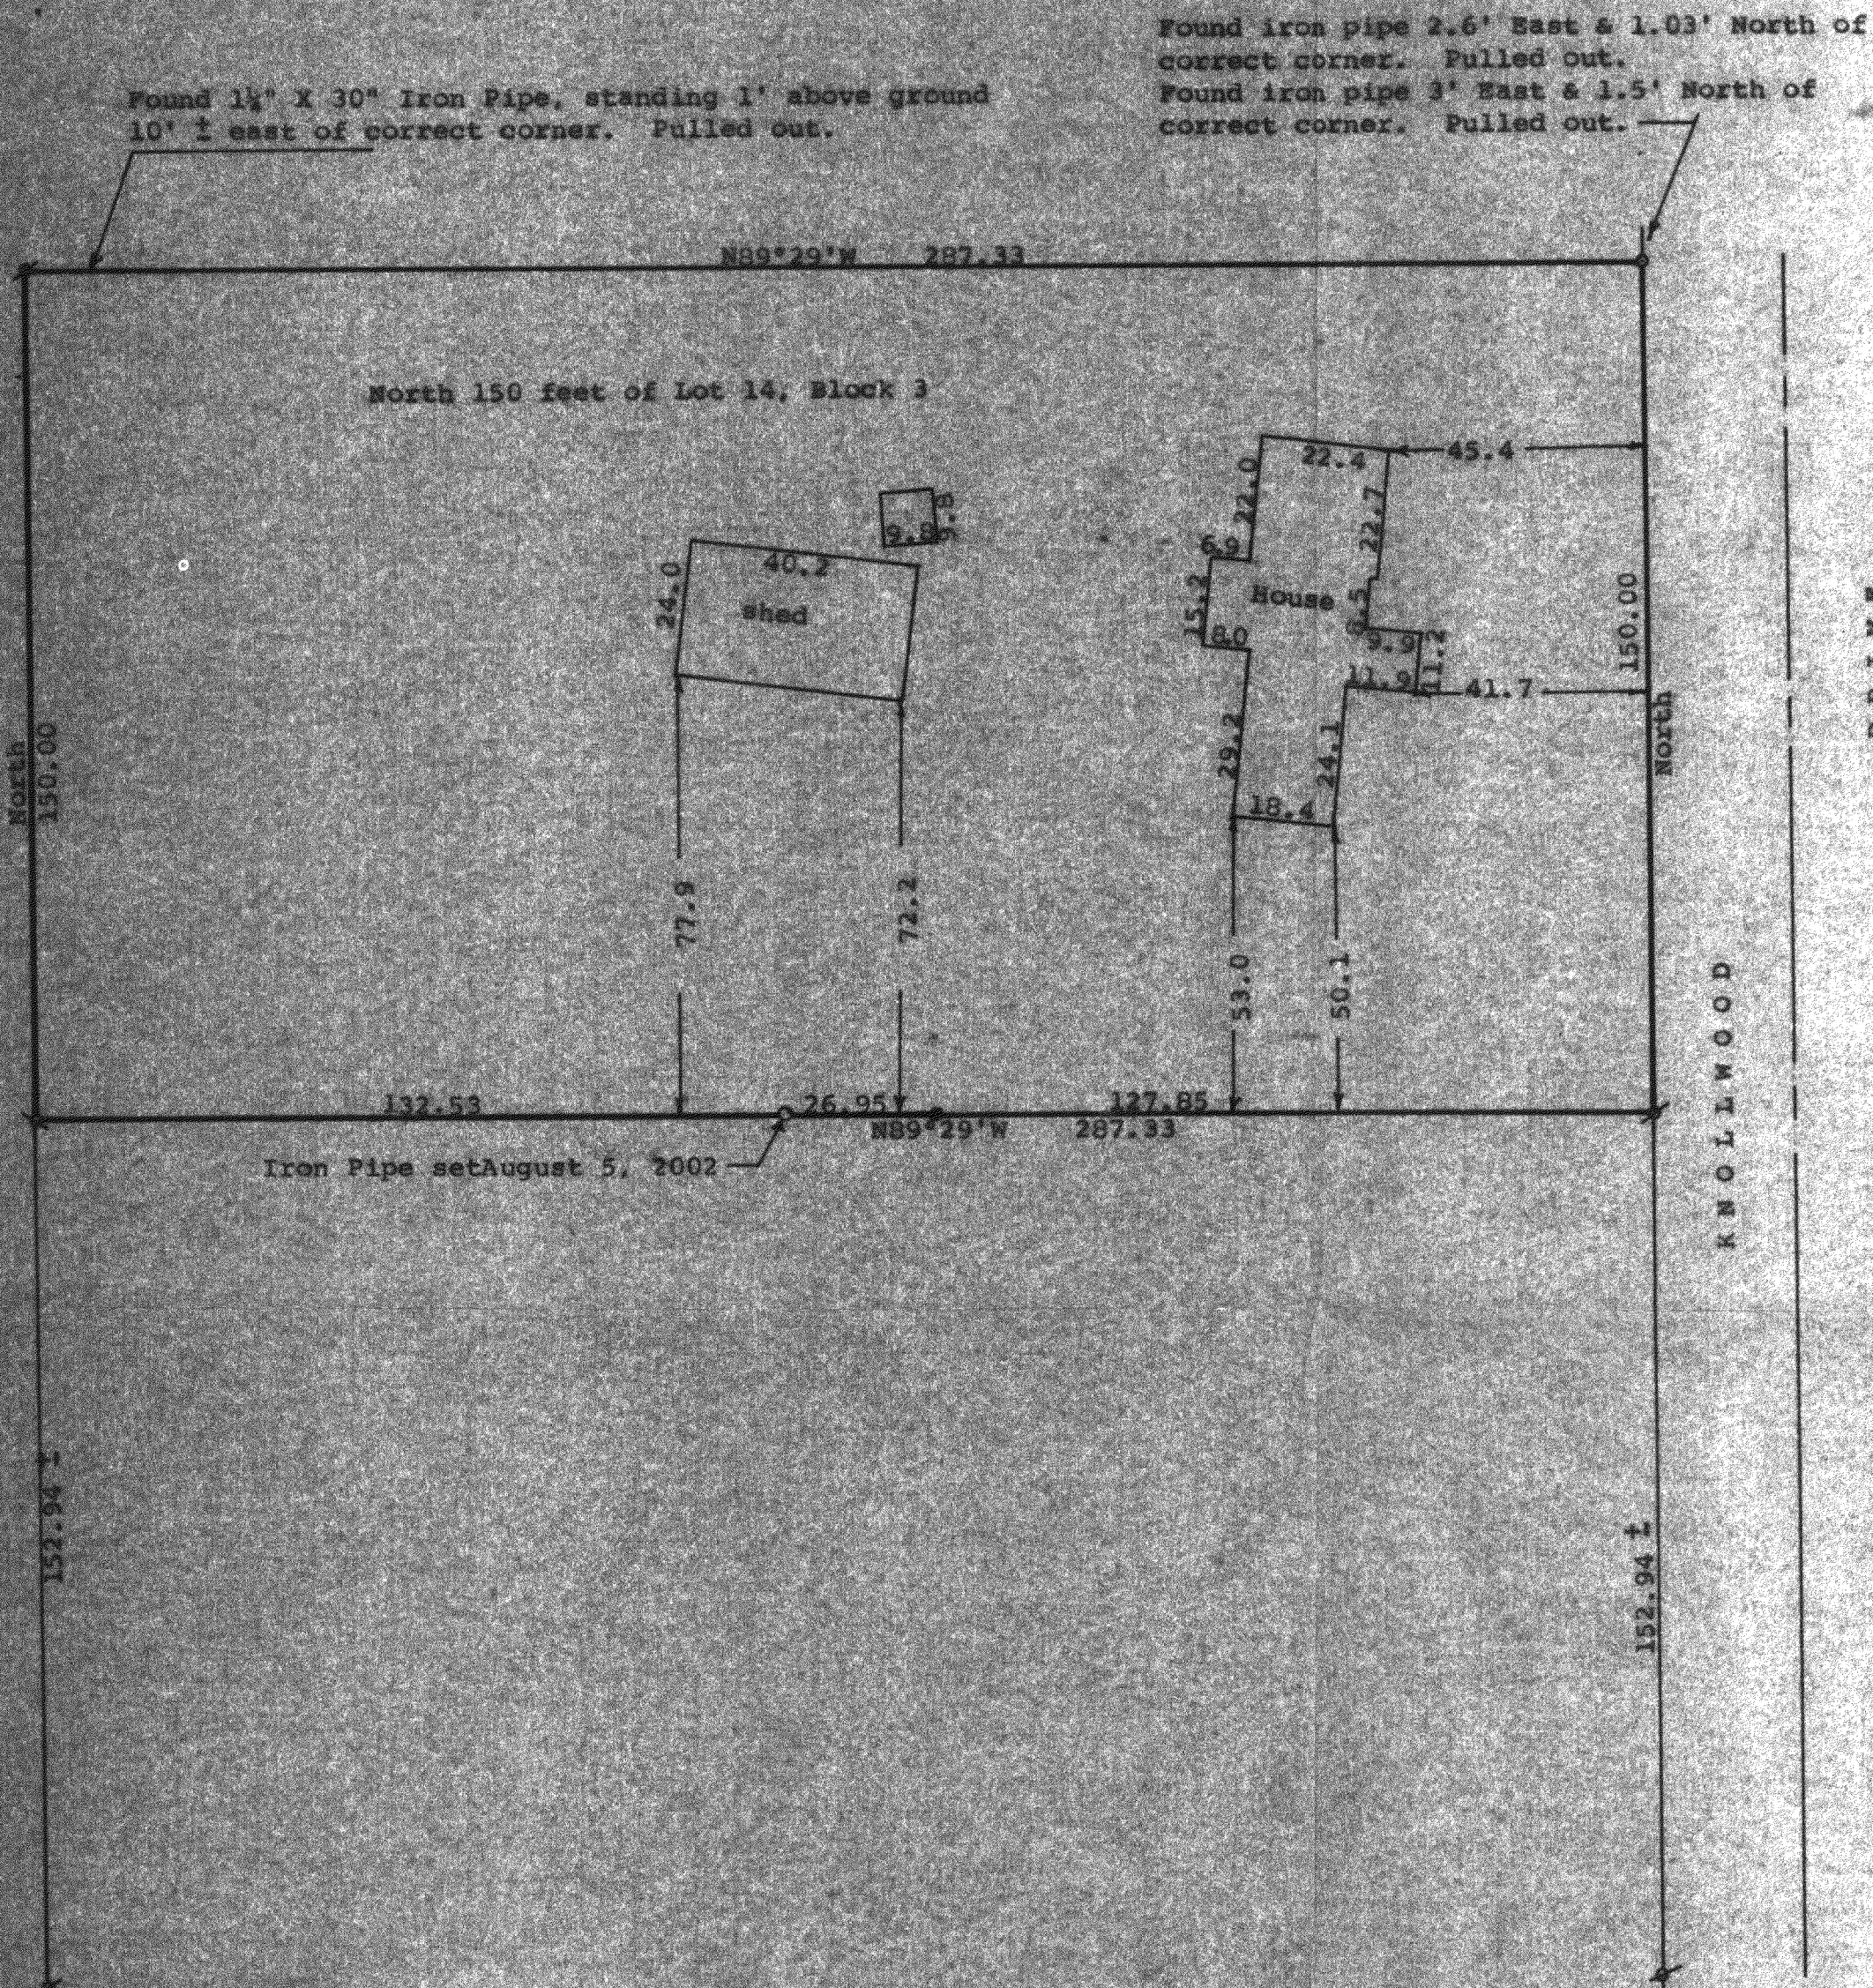

Scale - 1" = 30'

• = 3/4" Iron Pipe Found

▲ = 1 1/4" Iron Pipe Found up 10" and over a 3/4" Iron Pipe. Reset flush with ground

o = 3/4" X 24" Iron Pipe Set

● = 1 1/4" Iron Pipe over a 3/4" Iron pipe. Standing 0.8' above ground

Bearings referenced to the west line of Knollwood Drive with the assumed bearing of North

Survey ordered by: The Rauland Agency
Malworth, WI 53184

Survey of south line of the property ordered by: Kathy Findlay
2441 Knollwood Drive
Lake Geneva, WI 53147

Aug. 5, 2002

STATE OF WISCONSIN) ss
COUNTY OF WALWORTH)

I, George T. Dunham, Surveyor, certify that I have surveyed the property described as follows:

The North 150.00 feet of Lot 14 in Block 3, Rowena Park Subdivision located in Section 3, T 1 N, R 17 E, Walworth County, Wisconsin and that the plat shown hereon is a correct representation thereof and shows the size and location of the property, its exterior boundaries, the location of all visible structures and dimensions of all principal buildings thereon, boundary fences, apparent easements, roadways and visible encroachments, if any, and that I have surveyed the property hereon described according to the official records, to the best of my knowledge and belief.

June 12, 1990

August 5, 2002 - All iron pipes on south line relocated & frequent wood stakes were set.

George T. Dunham, Surveyor

