


# Plat of Survey



of

Lot 2 of Block 2 of the Plat of Zenda,  
located in the Southeast 1/4 of Section 28, Town 1 North,  
Range 17 East, Town of Linn, Walworth County, Wisconsin.

Surveyed for: **Schiltz Law Office, S.C.**  
P.O. Box 158  
Lake Geneva, Wisconsin. 53147

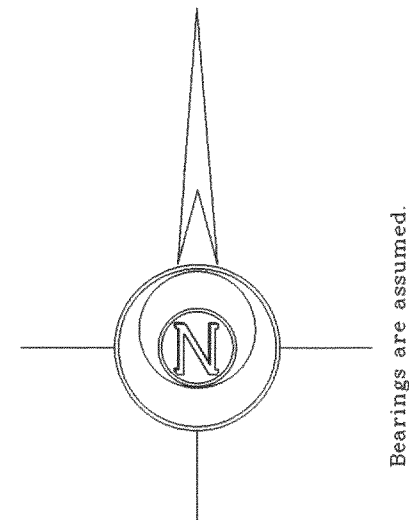


Franklin Walsh Street

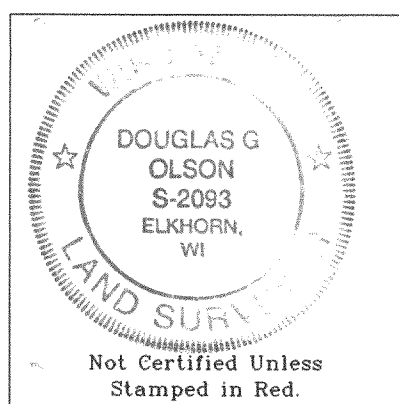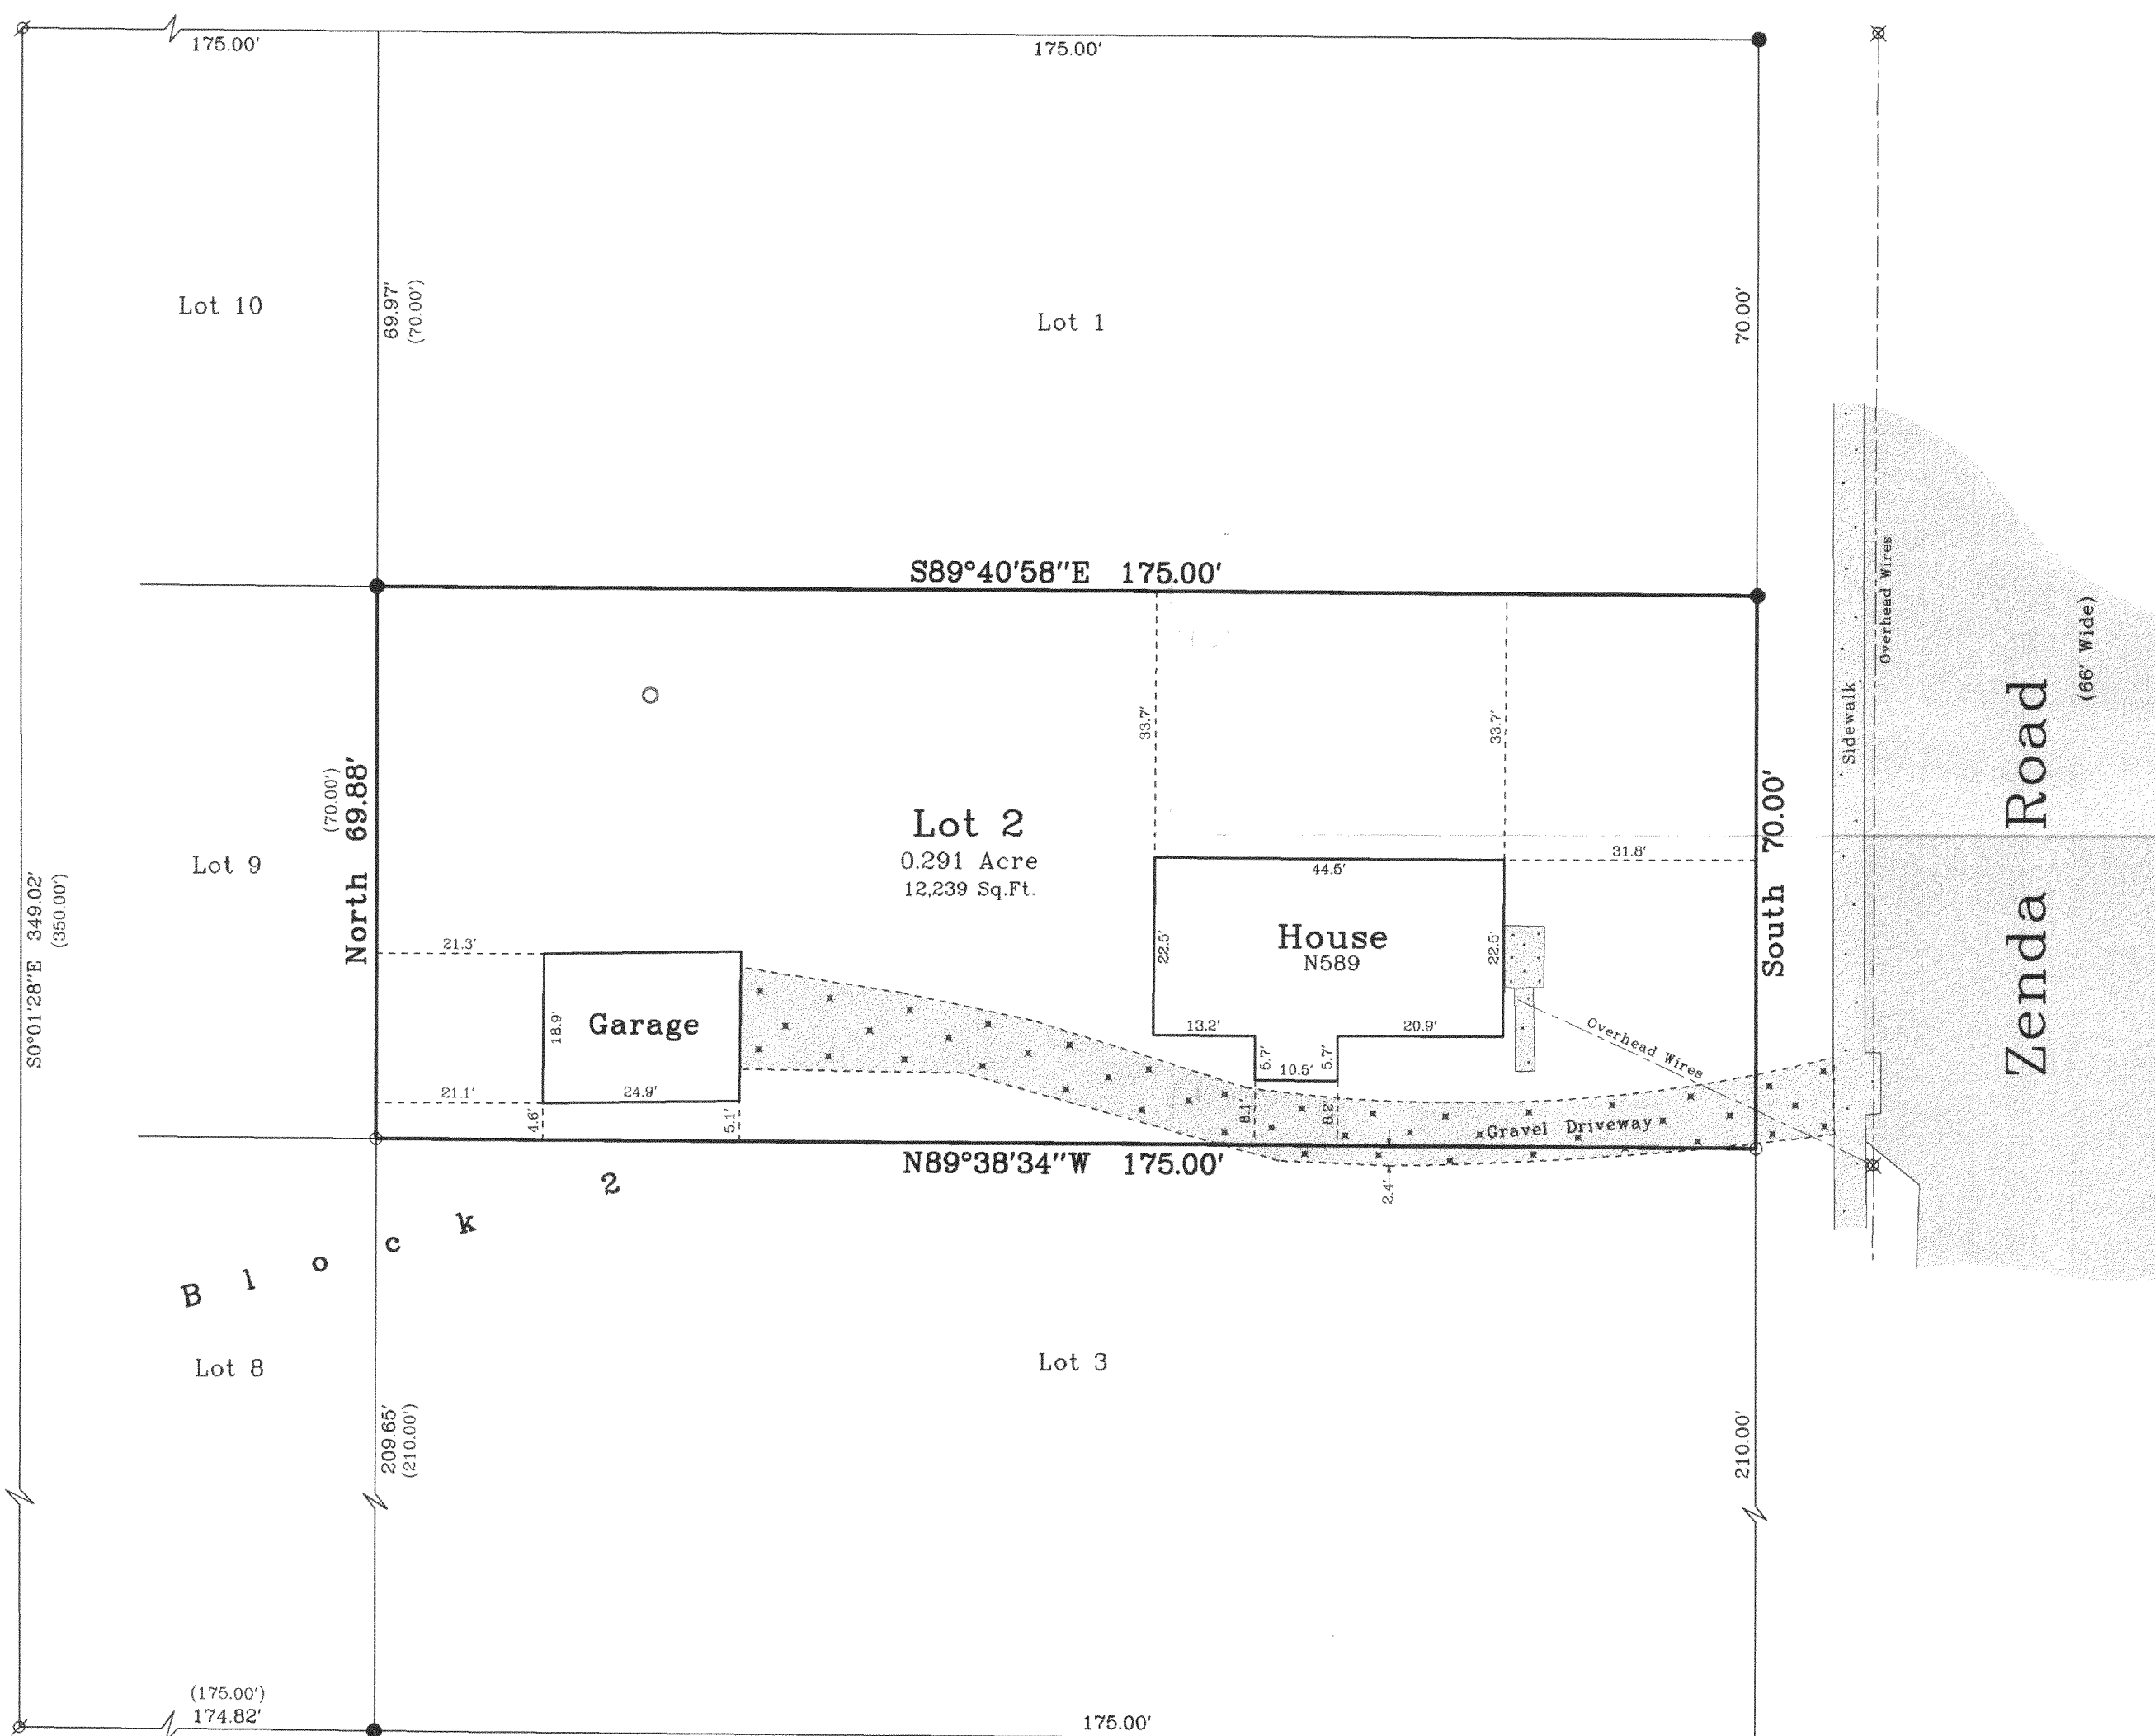

Copyright © 2004 by Jensen & Olson Land Surveying, LLC.

All rights reserved. No part of this survey plat may be reproduced or transmitted in any form by any means - graphic, electronic, or mechanical, including photocopying, tracing, or information storage and retrieval systems - without permission in writing from Douglas G. Olson, Jensen & Olson Land Surveying, LLC.

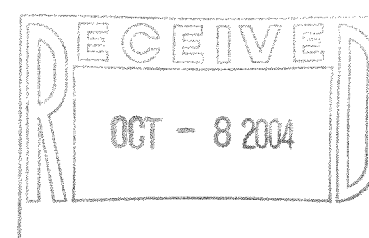

Notes: 1) This survey plat is not certified unless signed and sealed in red ink.


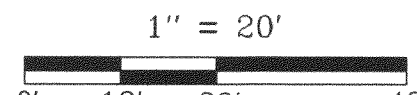
2) This survey is subject to Wisconsin lien laws. This Plat of Survey is the notice of intent to file lien. Lien waiver required.







I hereby certify that I have surveyed the above described property and the map hereon is correct to the best of my professional knowledge and belief and shows the size and location of the property, its exterior boundaries, the location and dimensions of all visible structures thereon, boundary fences, apparent easements and roadways and visible encroachments, if any.

This survey is made for the exclusive use of the present owners of property, and also those who purchase, mortgage or guarantee title thereto, within one year from the date hereof.

Douglas G. Olson  
Wisconsin Registered Land Surveyor - 2093

IZ 00007A

2004.021	Sheet 1 of 1 Sheets	 <b>Jensen &amp; Olson Land Surveying, LLC</b> 45 South Wisconsin Street P.O. Box 322 Elkhorn, Wisconsin. 53121 Telephone (262) 723-3434 Facsimile (262) 723-8044	Scale in Feet 1" = 20' 	Survey Date: May 26, 2004. Revisions:
	Job Reference Number <b>2004.021</b>			

Legend	
	Found Iron Pipe
	Found Iron Rod
	Set Iron Rod 3/4" dia.
	Recorded Information
	Utility Pole
	Concrete Cover
	Asphalt Surface
	Concrete Surface
	Gravel

117-2480