
Wisconsin Registered Land Surveyor S-2582

N9330 Knuteson Drive Whitewater, WI 53190 Phone:(262)495-3284 FAX: (262) 495-8421 LAND-MARKSURVEYING.COM

## PLAT OF SURVEY

LOTS 19 AND 20 OF BLOCK " I " CISCO BEACH SUBDIVISION LOCATED IN TOWN 1 NORTH, RANGE 17 EAST, TOWN OF LINN, WALWORTH COUNTY, WISCONSIN.

fnd, iron pipe bent north

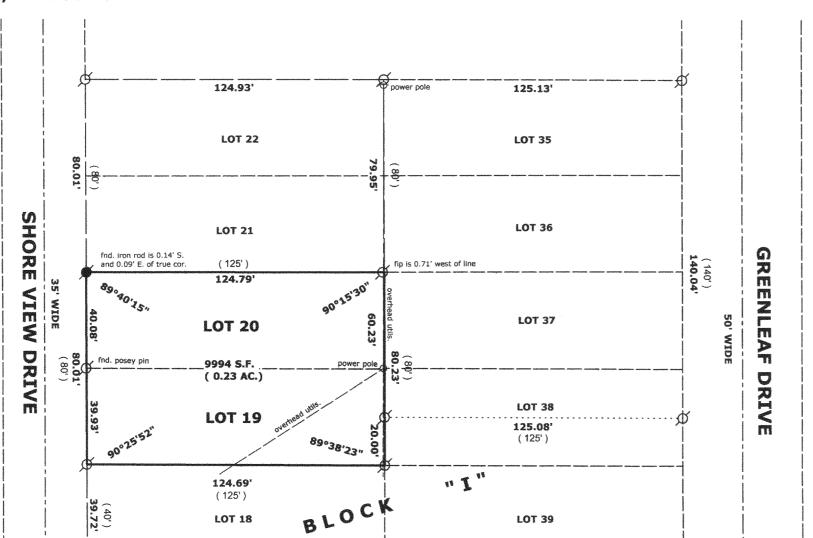

ORDERED BY: SCHILTZ LAW OFFICE
803 W. MAIN ST.
P.O. BOX 158
LAKE GENEVA, WI. 53147

OWNERS: GERALD A. and MADELINE WAHLGREN

GCONS

MARK L


MIRITZ

S-2582

WHITEWATER

SUR

10106 W. W. PARKVIEW DR. PALOS PARK, IL. 60464

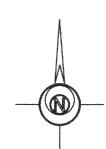

2 6 2005

## LEGEND

FOUND IRON ROD

FOUND COUNTY MONUMENT

FOUND CONCRETE MONUMENT

+ CHISEL CUT IN CONCRETE

SET IRON ROD, 24" LONG, WEIGHING

1.5 LBS./LINEAL FT., 3/4" DIA.

( x x ) RECORDED AS DIMENSION

SCALE:  $1'' = \frac{40}{10}$  FEET

"I hereby certify that the above described property has been surveyed by me or under my direction and that the above map is a true representation thereof and shows the size and location of the property, its exterior boundaries, the location of all visible structures and dimensions of all principal buildings thereon, boundary fences, apparent easements, roadways and visible encroachments, if any."

"This survey is made for the use of the present owners of the property, and also those who purchase, mortgage, or guarantee the title thereto within one year from date hereof."

MARK L. MIRITZ WISCONSIN REGISTERED LAND SURVEYOR S-2582

DATE: June 4, 2005 JOB NO. \_05.602

00200