PREPARED FOR:


PLAT OF SURVEY

-OF-

J.K. SURVEYING INC. N3705 WILLOWBEND LANE LAKE GENEVA, WI, 53147 262-248-3697

R.J. AMANN BUILDERS

LOTS 21, 22, 23 AND 24, BLOCK 7, SUNSET HILLS SUBDIVISION, A SUBDIVISION LOCATED IN TOWN 1 NORTH, RANGE 17 EAST, TOWN OF LINN, COUNTY OF WALWORTH AND STATE OF WISCONSIN.

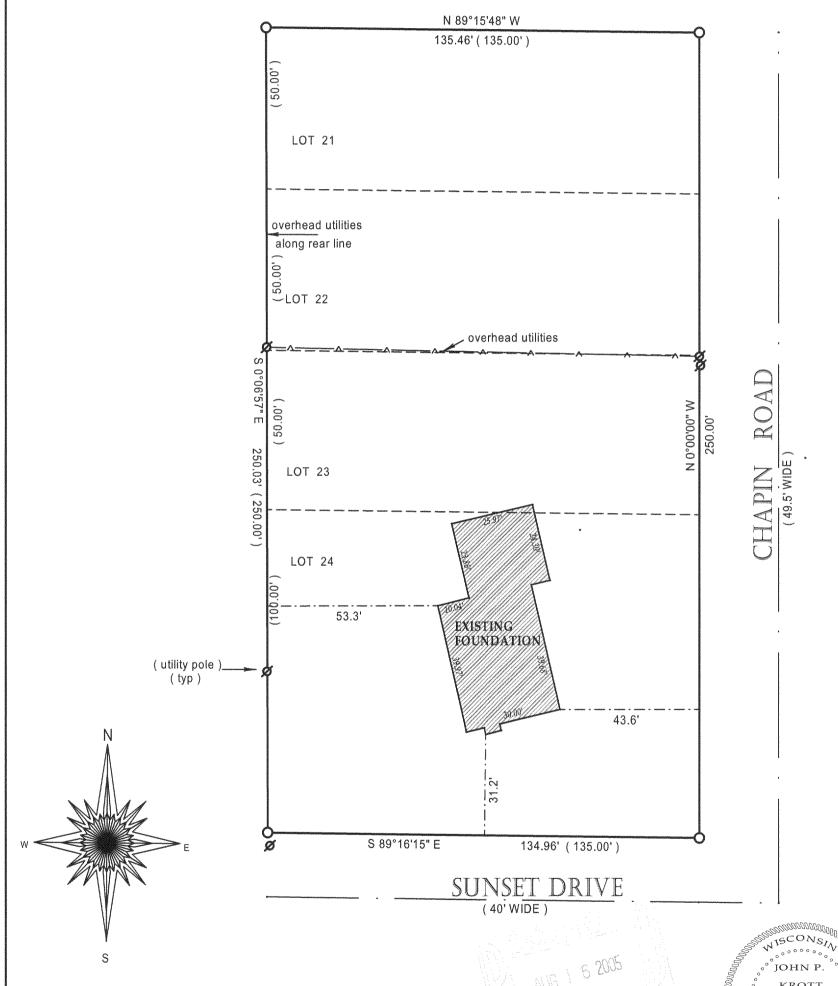

() = RECORDED AS

□ = FOUND IRON BAR

O = FOUND IRON PIPE

● = SET IRON PIPE

= SET IRON BAR

SCALE: 1" = 30'

JOB #: 04-646

TAX ID #:ISH 00102

COMPARE LEGAL DESCRIPTION ABOVE AND DRAWING WITH DEED. FOR BUILDING RESTRICTIONS AND EASEMENTS NOT SHOWN, REFER TO DEED, ABSTRACT SOURCES AND LOCAL MUNICIPAL CODES. NOTIFY THE SURVEYOR IMMEDIATELY OF ANY DISCREPANCY.

"I hereby certify that the above described property was surveyed under my supervision and that the above map, to the best of my knowledge and belief, is a true representation thereof and shows the size and location of all visible structures, apparent easements and encroachments if any." This survey is made for the present owners of the property, and those who purchase, mortgage, or guarentee the title thereto, within one year from the date hereof.



John John 4 12 1 2003

JOHN KROTT S - 2258 Wisconsin Registered Land Surveyor (original if signed in red)

DATED THE 1 TH, DAY OF DECEMBER 2004.