

PREPARED FOR : JOHN NOTZ,
N 609 COUNTRYSIDE RD.,
LAKEGENEVA WI, 53147


PLAT OF SURVEY

- OF -

LOT 16 OF LINNWOOD 1st ADDITION, LOCATED IN THE NORTHWEST 1/4 AND THE SOUTHWEST 1/4 OF THE
NORTHEAST 1/4, OF SECTION 15, TOWN 1 NORTH, RANGE 17 EAST, WALWORTH COUNTY, WISCONSIN.

ALSO OUTLOT 8 OF LINNWOOD 2nd ADDITION, LOCATED IN THE NORTHWEST 1/4 AND THE SOUTHWEST
OF THE NORTHEAST 1/4 OF SECTION 15, TOWN 1 NORTH, RANGE 17 EAST, WALWORTH COUNTY, WISCONSIN.

PATHFINDER SURVEYING INC.
N3705 WILLOW BEND LANE
LAKE GENEVA WI, 53147


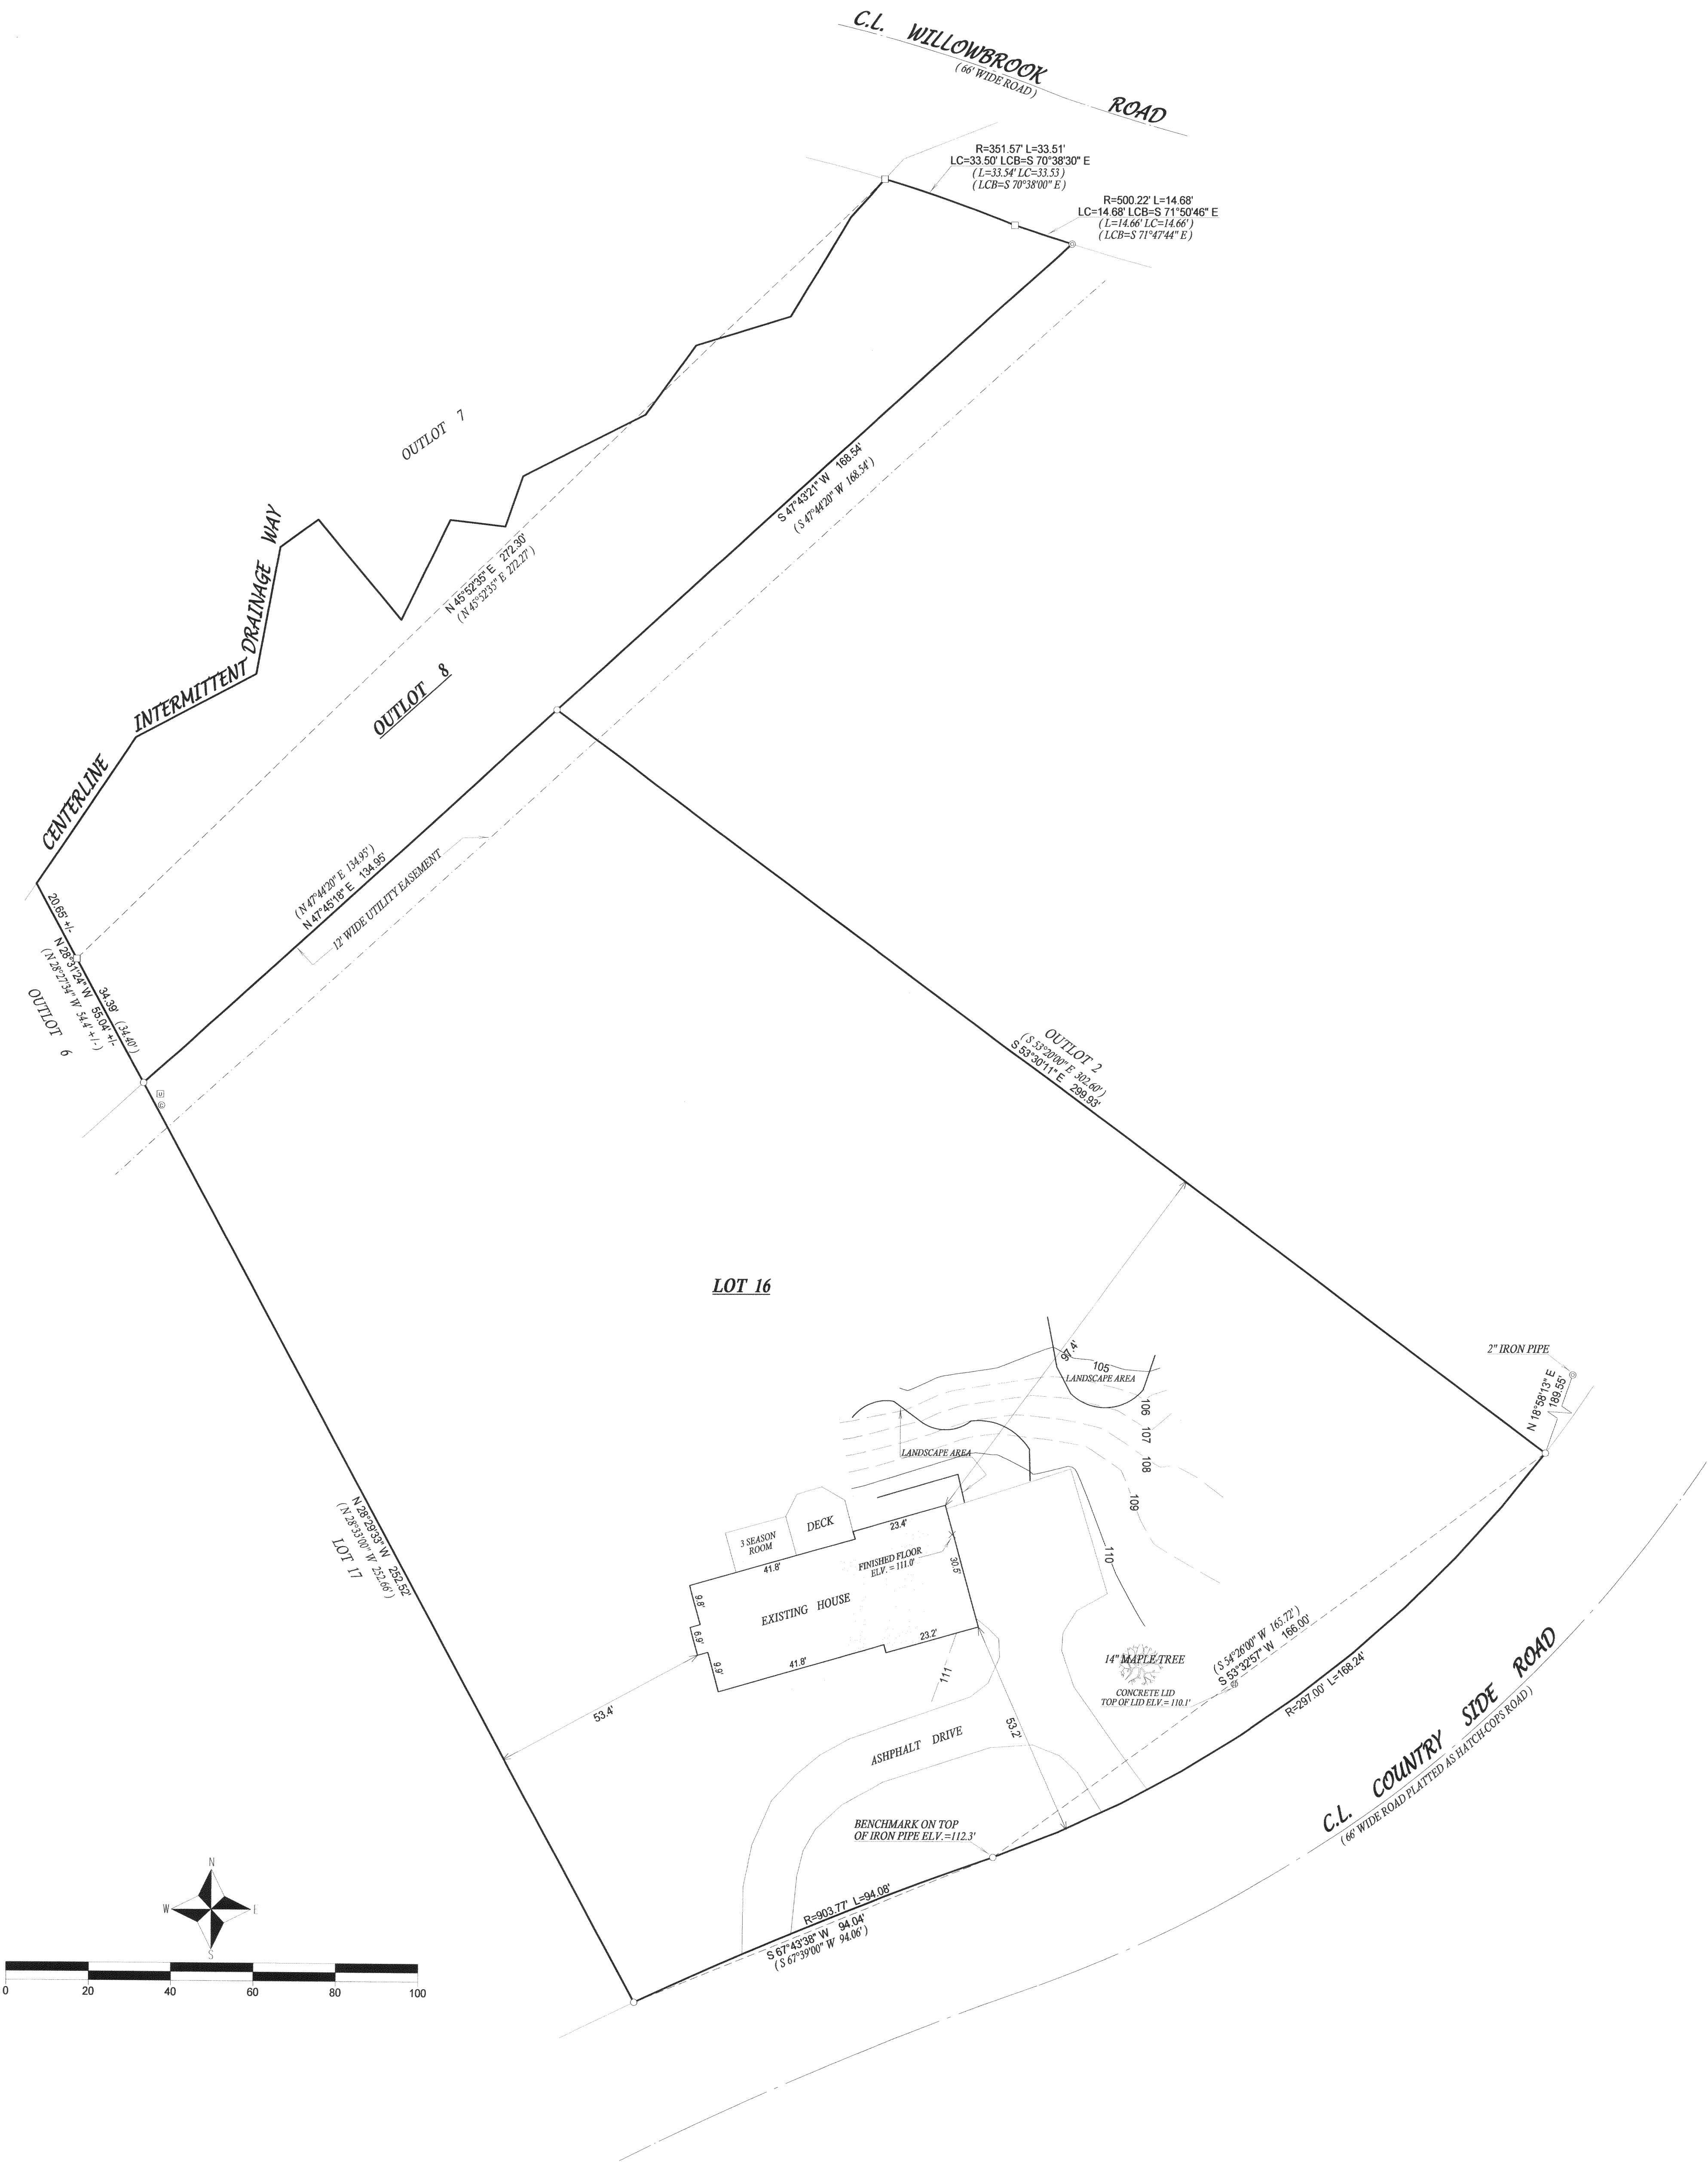


() = recorded as
□ = found iron bar
○ = found iron pipe
● = set iron pipe
■ = set iron bar

SCALE 1" = 20'
JOB # 05-503

TAX ID # ILWA00001 AND ILWB00006

NOTE: ELAVATIONS ARE ASSUMED
COMPARE LEGAL DESCRIPTION ABOVE AND DRAWING WITH DEED FOR BUILDING RESTRICTIONS AND
EASEMENTS NOT SHOWN HEREIN TO REED, ABSTRACT SOURCES AND LOCAL MUNICIPAL CODES. NOTIFY
THE SURVEYOR IMMEDIATELY OF ANY DISCREPANCY.
I hereby certify that I have surveyed the above described property and that
the above map, to the best of my knowledge and belief, is a true representation
thereof and shows the size and location of all visible structures, apparent
easements and encroachments if any.
This survey is made for the present owners of the property, and those who
purchase, mortgage, or guarantee the title thereto, within one year from
the date hereof.

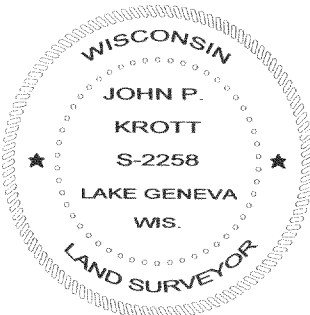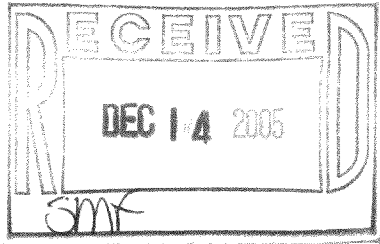

JOHN P. KROTT S-2258
Wisconsin Registered Land Surveyor
(original if signed in red)

DATED THIS THE 29th DATE OF SEPTEMBER 2005.

117-2638