


PLAT OF SURVEY

LOT 1 AND THE WESTERLY 70 FEET OF
LOT 2 AND LOTS 3 THRU 5 INCLUSIVE
OF BLOCK 7 OF SUNSET HILLS
SUBDIVISION, LOCATED IN SECTION 4,
TOWN 1 NORTH, RANGE 17 EAST, TOWN
OF LINN, WALWORTHCOUNTY, WSCONSIN.

OWNERS: MICHAEL F. PFAMMATTER
MARY JO PFAMMATTER
N2446 SHADYSIDE
LAKE GENEVA, WI. 53147

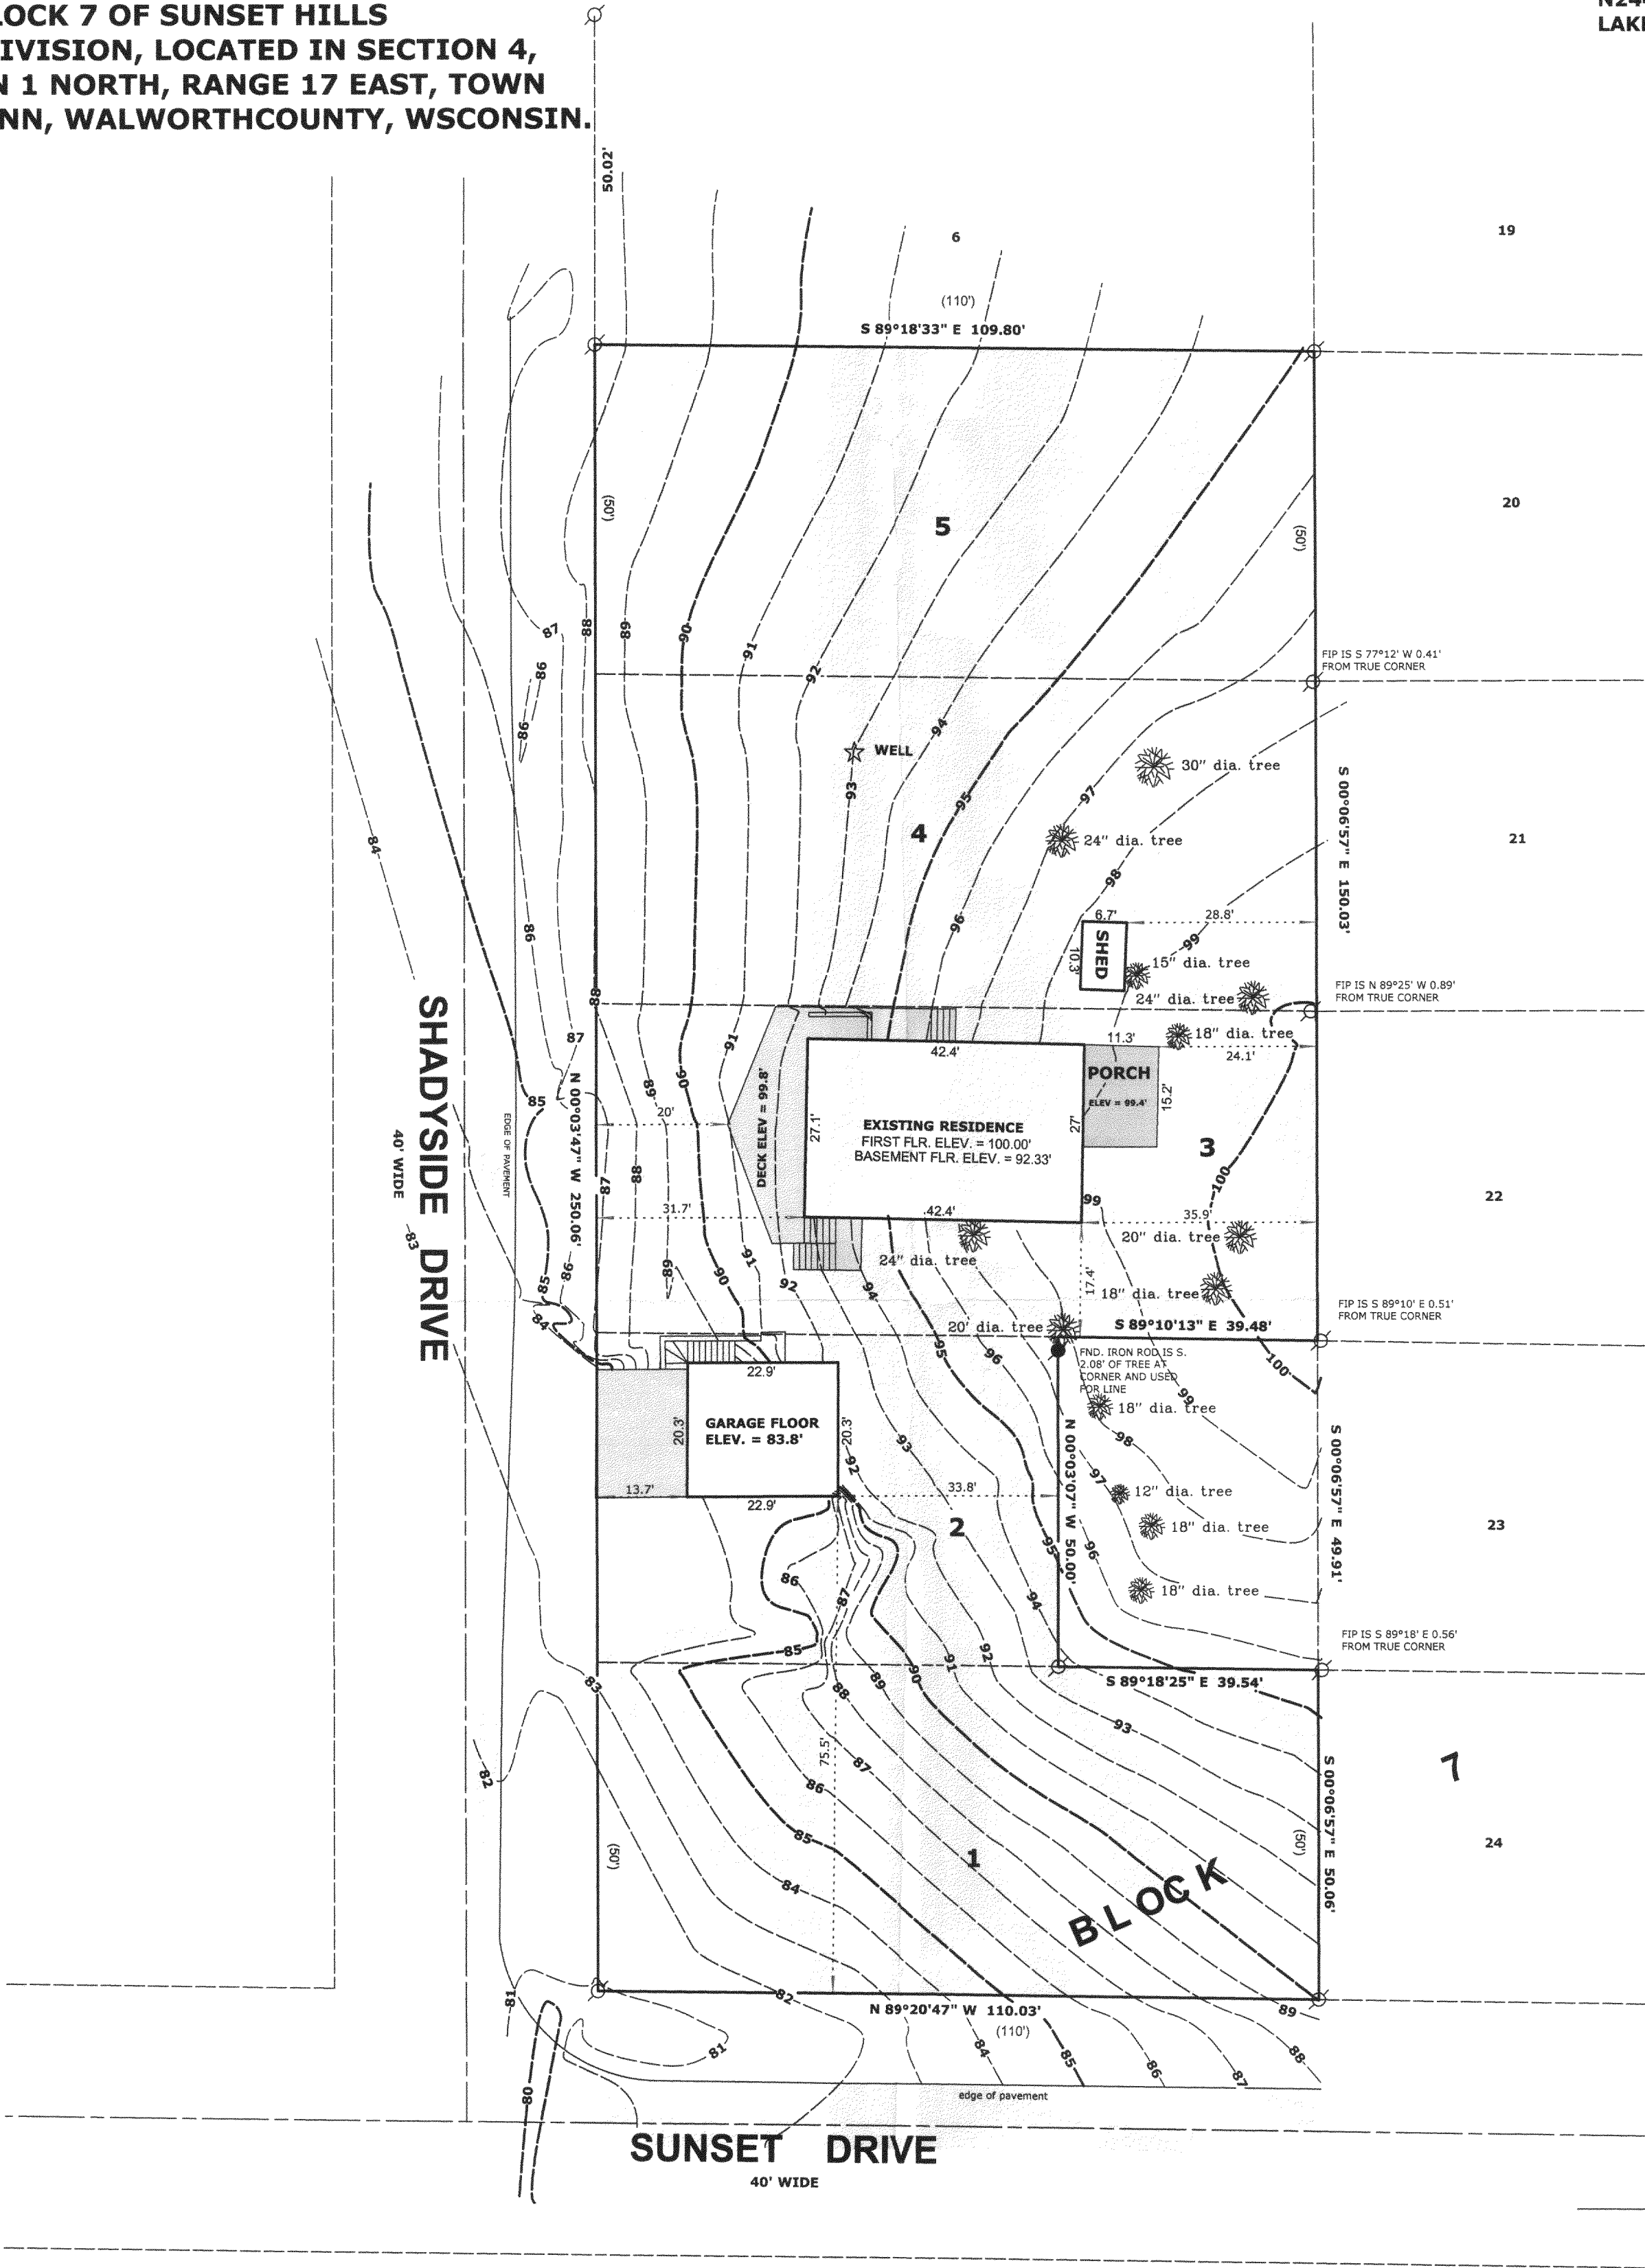

- LEGEND**
- FOUND IRON PIPE
 - FOUND IRON ROD
 - FOUND COUNTY MONUMENT
 - FOUND CONCRETE MONUMENT
 - CHISEL CUT IN CONCRETE
 - SET IRON ROD, 24" LONG, WEIGHING 1.5 LBS./LINEAL FT., 3/4" DIA.
 - RECORDED AS DIMENSION
 - EXISTING FENCE

THE EAST LINE OF LOTS 1-5
OF BLOCK 7 WAS ASSUMED TO
BEAR S 0°06'57" E TO MATCH
EXISTING SURVEYS OF RECORD

SCALE: 1" = 20 FEET

"I hereby certify that the above described property has been surveyed by me or under my direction and that the above map is a true representation thereof and shows the size and location of the property, its exterior boundaries, the location of all visible structures and dimensions of all principal buildings thereon, boundary fences, apparent easements, roadways and visible encroachments, if any."
"This survey is made for the use of the present owners of the property, and also those who purchase, mortgage, or guarantee the title thereto within one year from date hereof."

MARK L. MIRITZ
WISCONSIN REGISTERED
LAND SURVEYOR S-2582

DATE: SEPT. 19, 2005 JOB NO. 05.905

