


PREPARED FOR:
MARJORIE KRANTZ
KEEFE REAL ESTATE, INC.
751 GENEVA PARKWAY
LAKE GENEVA, WI 53147

PLAT OF SURVEY

-OF -

PATHFINDER SURVEYING, INC.
N3705 WILLOWBEND LANE
LAKE GENEVA, WI, 53147
262-248-3697

LOT 1 CERTIFIED SURVEY MAP NO. 946 LOCATED IN THE SW 1/4 OF THE NW 1/4
OF SECTION 17 T.1.N., R.17.E., TOWN OF LINN, WALWORTH COUNTY, WISCONSIN.
ALSO: A RIGHT-OF-WAY RUNNING FROM THE WEST BOUNDARY OF THE
ABOVE DESCRIBED PARCEL WEST TO THE PUBLIC HIGHWAY

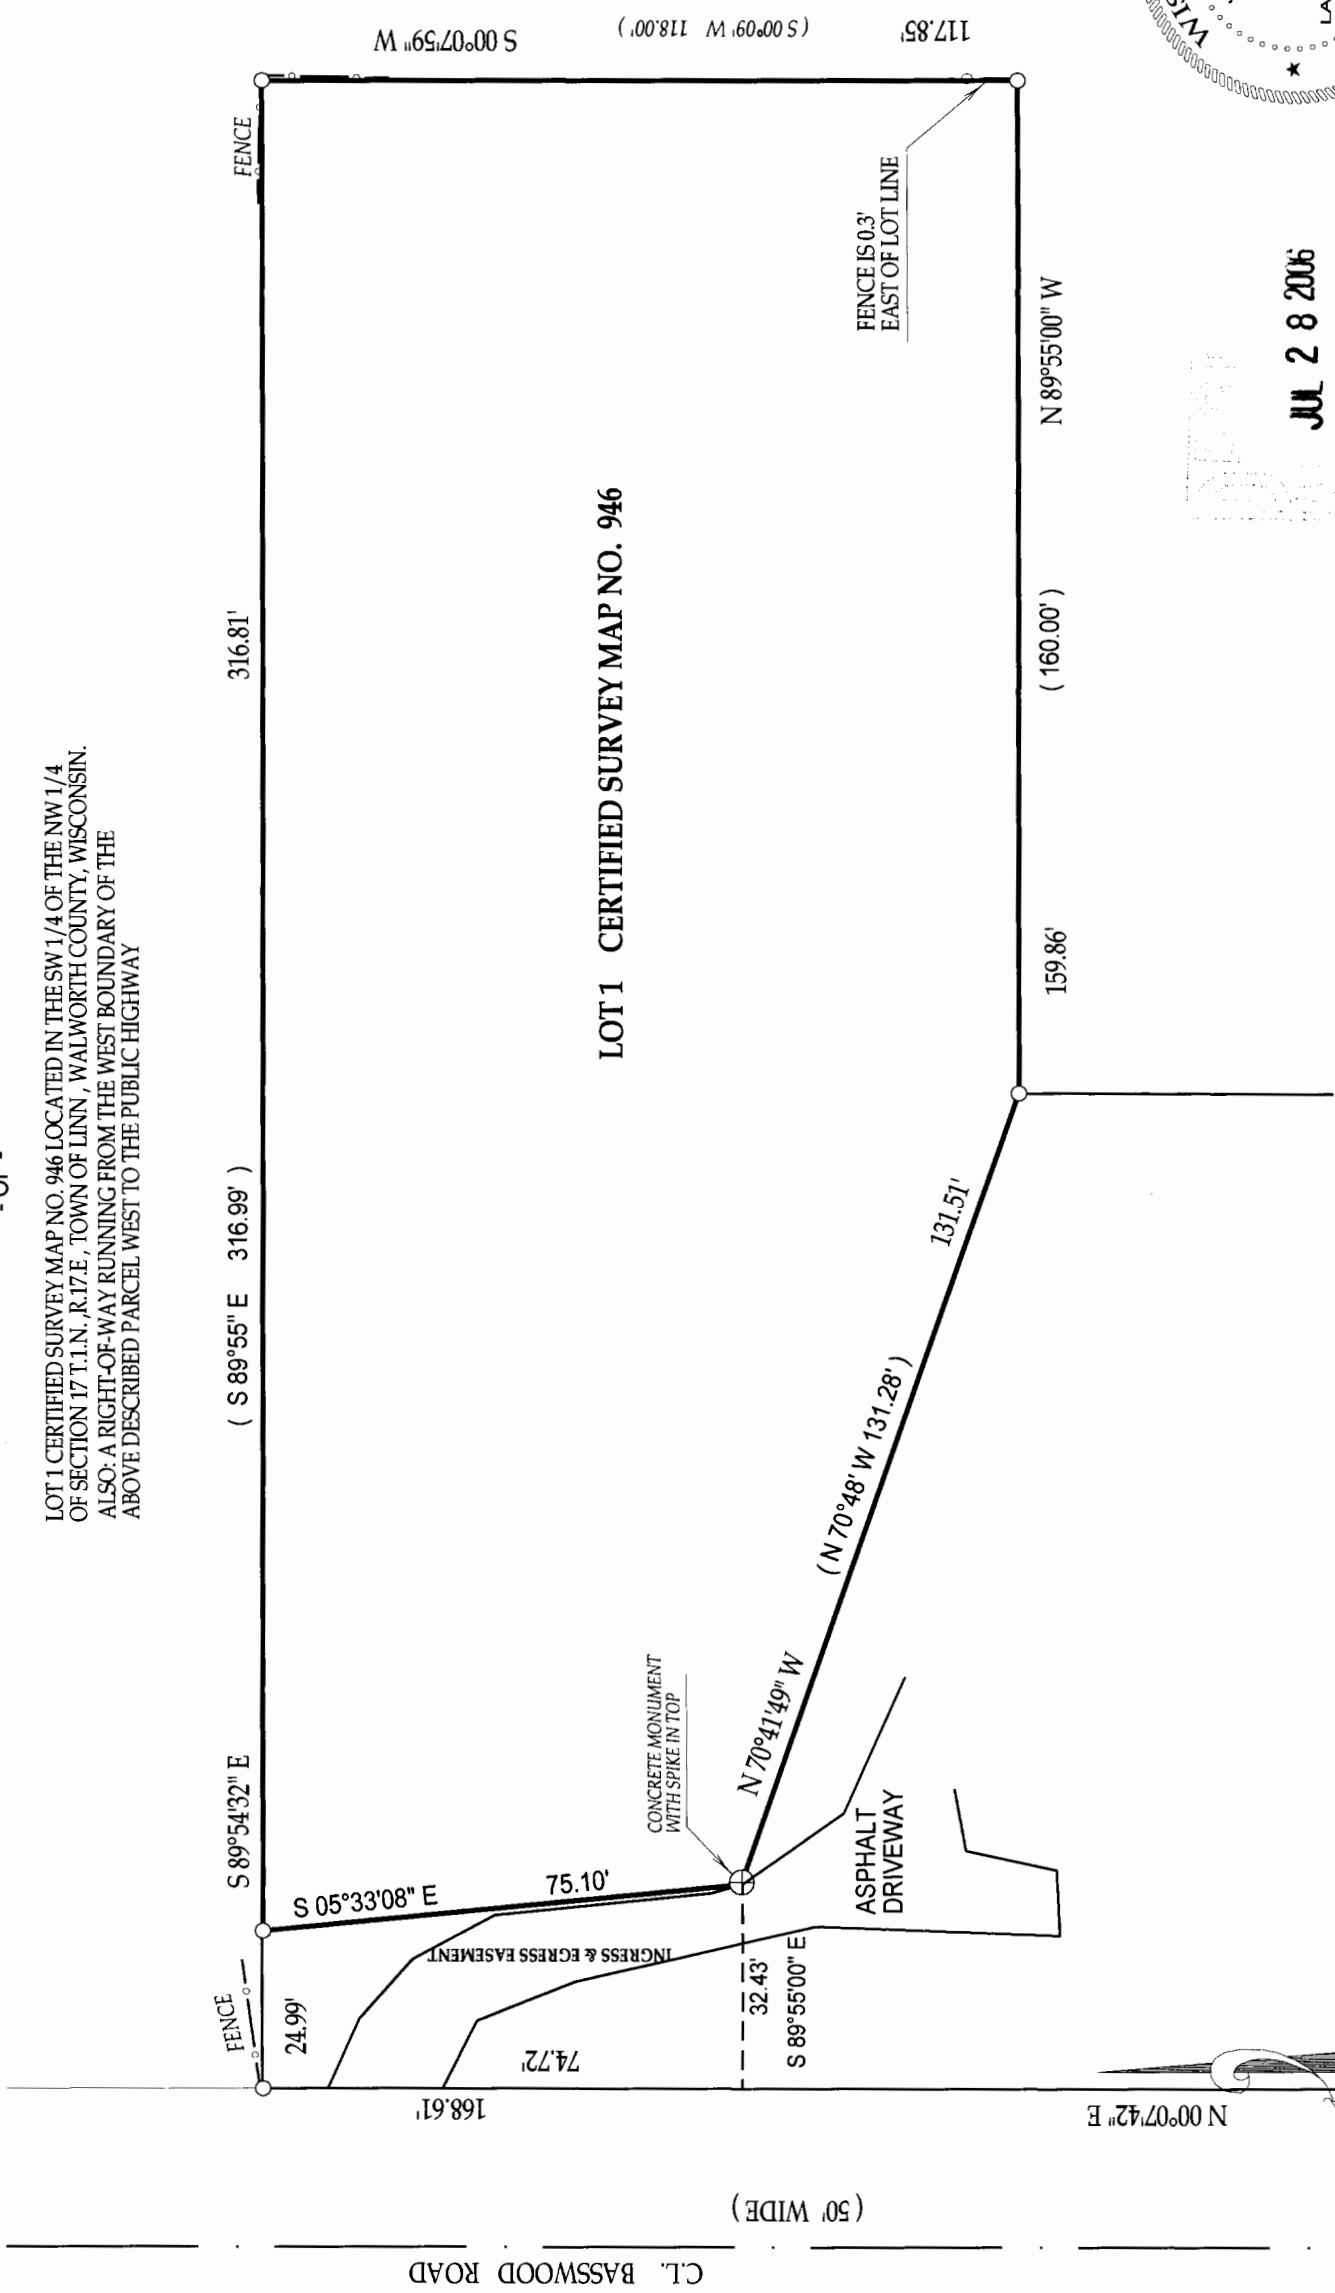

- () = recorded as
- = found iron bar
- = found iron pipe
- = set iron pipe
- = set iron bar

SCALE 1" = 30'

JOB #
03-493 UPDATE

TAX ID # IA 94600001 &
IL-17-12

COMPARE LEGAL DESCRIPTION ABOVE AND DRAWING WITH DEED. FOR BUILDING RESTRICTIONS AND
EASEMENTS NOT SHOWN, REFER TO DEED. ABSTRACT SOURCES AND LOCAL MUNICIPAL CODES. NOTIFY
THE SURVEYOR IMMEDIATELY OF ANY DISCREPANCY.

"I hereby certify that I have surveyed the above described property and that
the above map is a true representation thereof and shows the size and
location of all visible structures, apparent easements and encroachments
if any."


This survey is made for the present owners of the property, and those who
purchase, mortgage, or guarantee the title thereto, within one year from
the date hereof. REVISED 06-30-04

DATED THIS 25th, DAY OF AUGUST, 2003

DATE OF LAST REVISION: 5 / 05 / 2006

John P. Krott

JOHN KROTT S - 2258
Wisconsin Registered Land Surveyor
(original if signed in red)

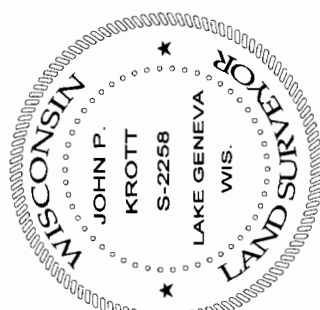

JUL 28 2006

SMR

117-2706