

ROBERS & FISCHER, INC.
CONSULTING ENGINEERS & LAND SURVEYORS

PHONE (414) 763-2652

116 E. CHESTNUT ST.



BURLINGTON, WIS. 53106

PLAT OF SURVEY

of
 Lots 10 and 11, Block D, Cisco Beach
 Subdivision, Town of Linn, Walworth
 County, Wisconsin.



-LEGEND-
 SCALE 1"=20' FT.
 IRON STAKE "x"

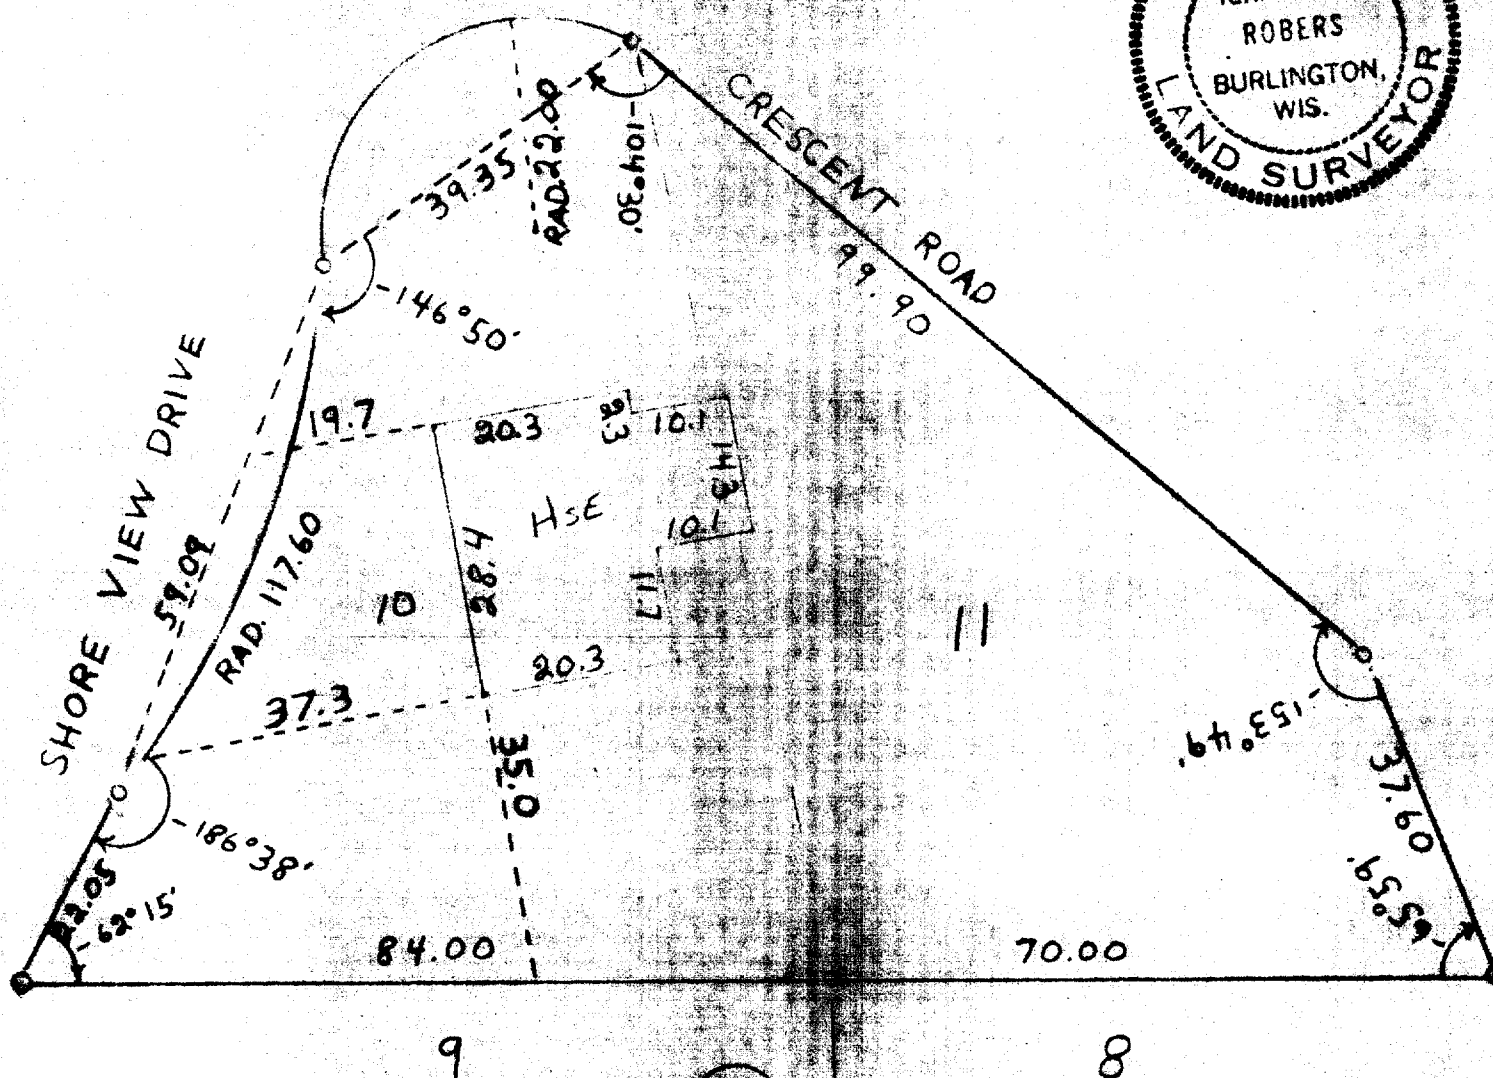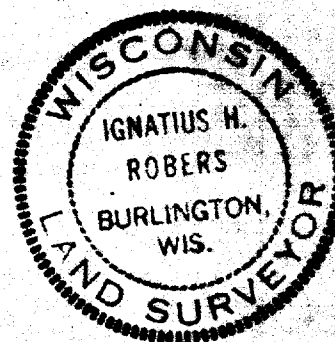

I HEREBY CERTIFY THAT WE HAVE SURVEYED THE LANDS SHOWN
 ABOVE ACCORDING TO OFFICIAL RECORDS AND THAT THE
 BEARING HEREON IS A CORRECT REPRESENTATION OF THE SAME.

Ignatius H. Rober
 WIS. LAND SURVEYOR
 500727

DATE 5-24-76

117-273

JOB NO. 71059