
PREPARED FOR RON AMANN R.J. AMANN BUILDERS 2492 CREST DR. LAKE GENEVA, WI 53147

PLAT OF SURVEY

PATHFINDER SURVEYING INC. W2888 KRUEGER RD. UNIT D LAKE GENEVA WI. 53147

- OF -

LOTS 1 AND 2, BLOCK 6, SUNSET HILLS, A SUBDIVISION LOCATED IN T.1.N., R.17.E, WALWORTH COUNTY, WISCONSIN.

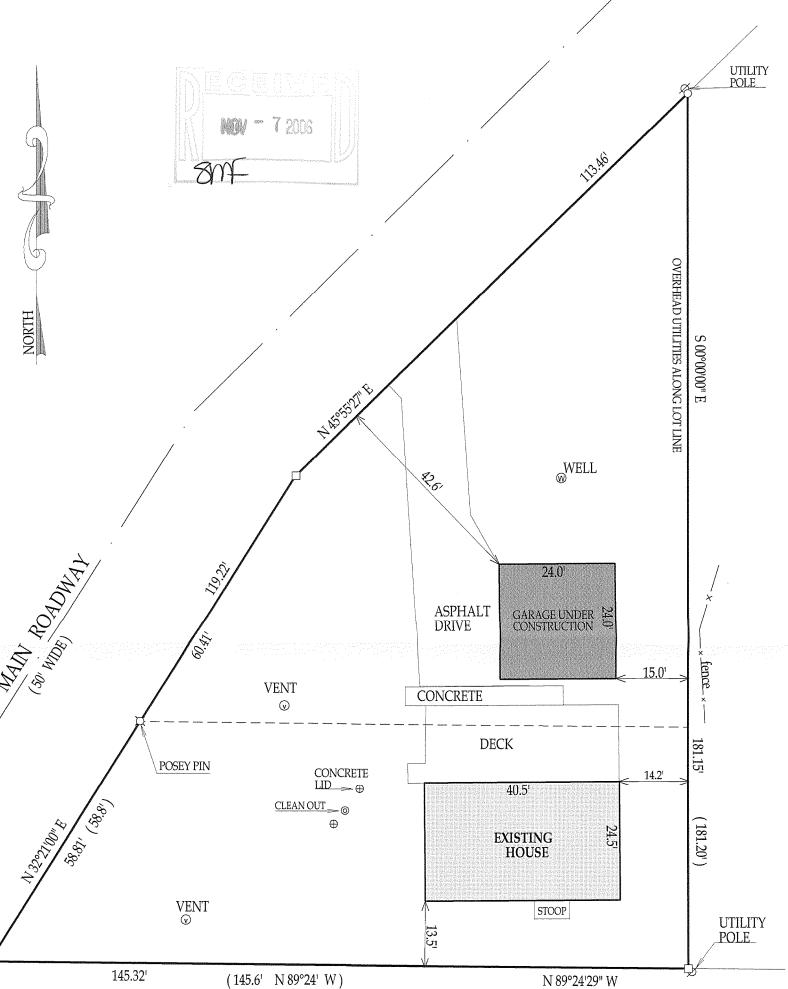

C.L. SUNSET DRIVE

(40' WIDE)

()= recorded as

 \Box = found iron bar

= found iron pipe

= set iron pipe

= set iron bar

COMPARE LEGAL DESCRIPTION ABOVE AND DRAWING WITH DEED. FOR BUILDING RESTRICTIONS AND EASEMENTS NOT SHOWN, REFER TO DEED, ABSTRACT SOURCES AND LOCAL MUNICIPAL CODES. NOTIFY THE SURVEYOR IMMEDIATELY OF ANY DISCREPANCY.

SCALE 1'' = 20'

JOB # 06-502AB

TAX ID # ISH00077

"I hereby certify that I have surveyed the above described property and that the above map is a true representation thereof and shows the size and location of all visible structures, apparent easements and encroachments

if any."

This survey is made for the present owners of the property, and those who purchase, mortgage, or guarantee the title thereto, within one year from the date hereof.

DATED THIS 18th, DAY OF OCTOBER, 2006



DATE OF LAST REVISION: 10 / 30 / 2006

John Chill

JOHN KROTT S - 2258 Wisconsin Registered Land Surveyor (original if signed in red)

117-2740