


PLAT OF SURVEY

-OF-

CASA DEL SUENO A CONDOMINIUM LOCATED IN THE SOUTHEAST 1/4 OF THE NORTHEAST 1/4
AND THE NORTHEAST 1/4 OF THE SOUTHEAST 1/4 OF SECTION 11, TOWN 1 NORTH, RANGE 17
EAST, WALWORTH COUNTY, WISCONSIN.

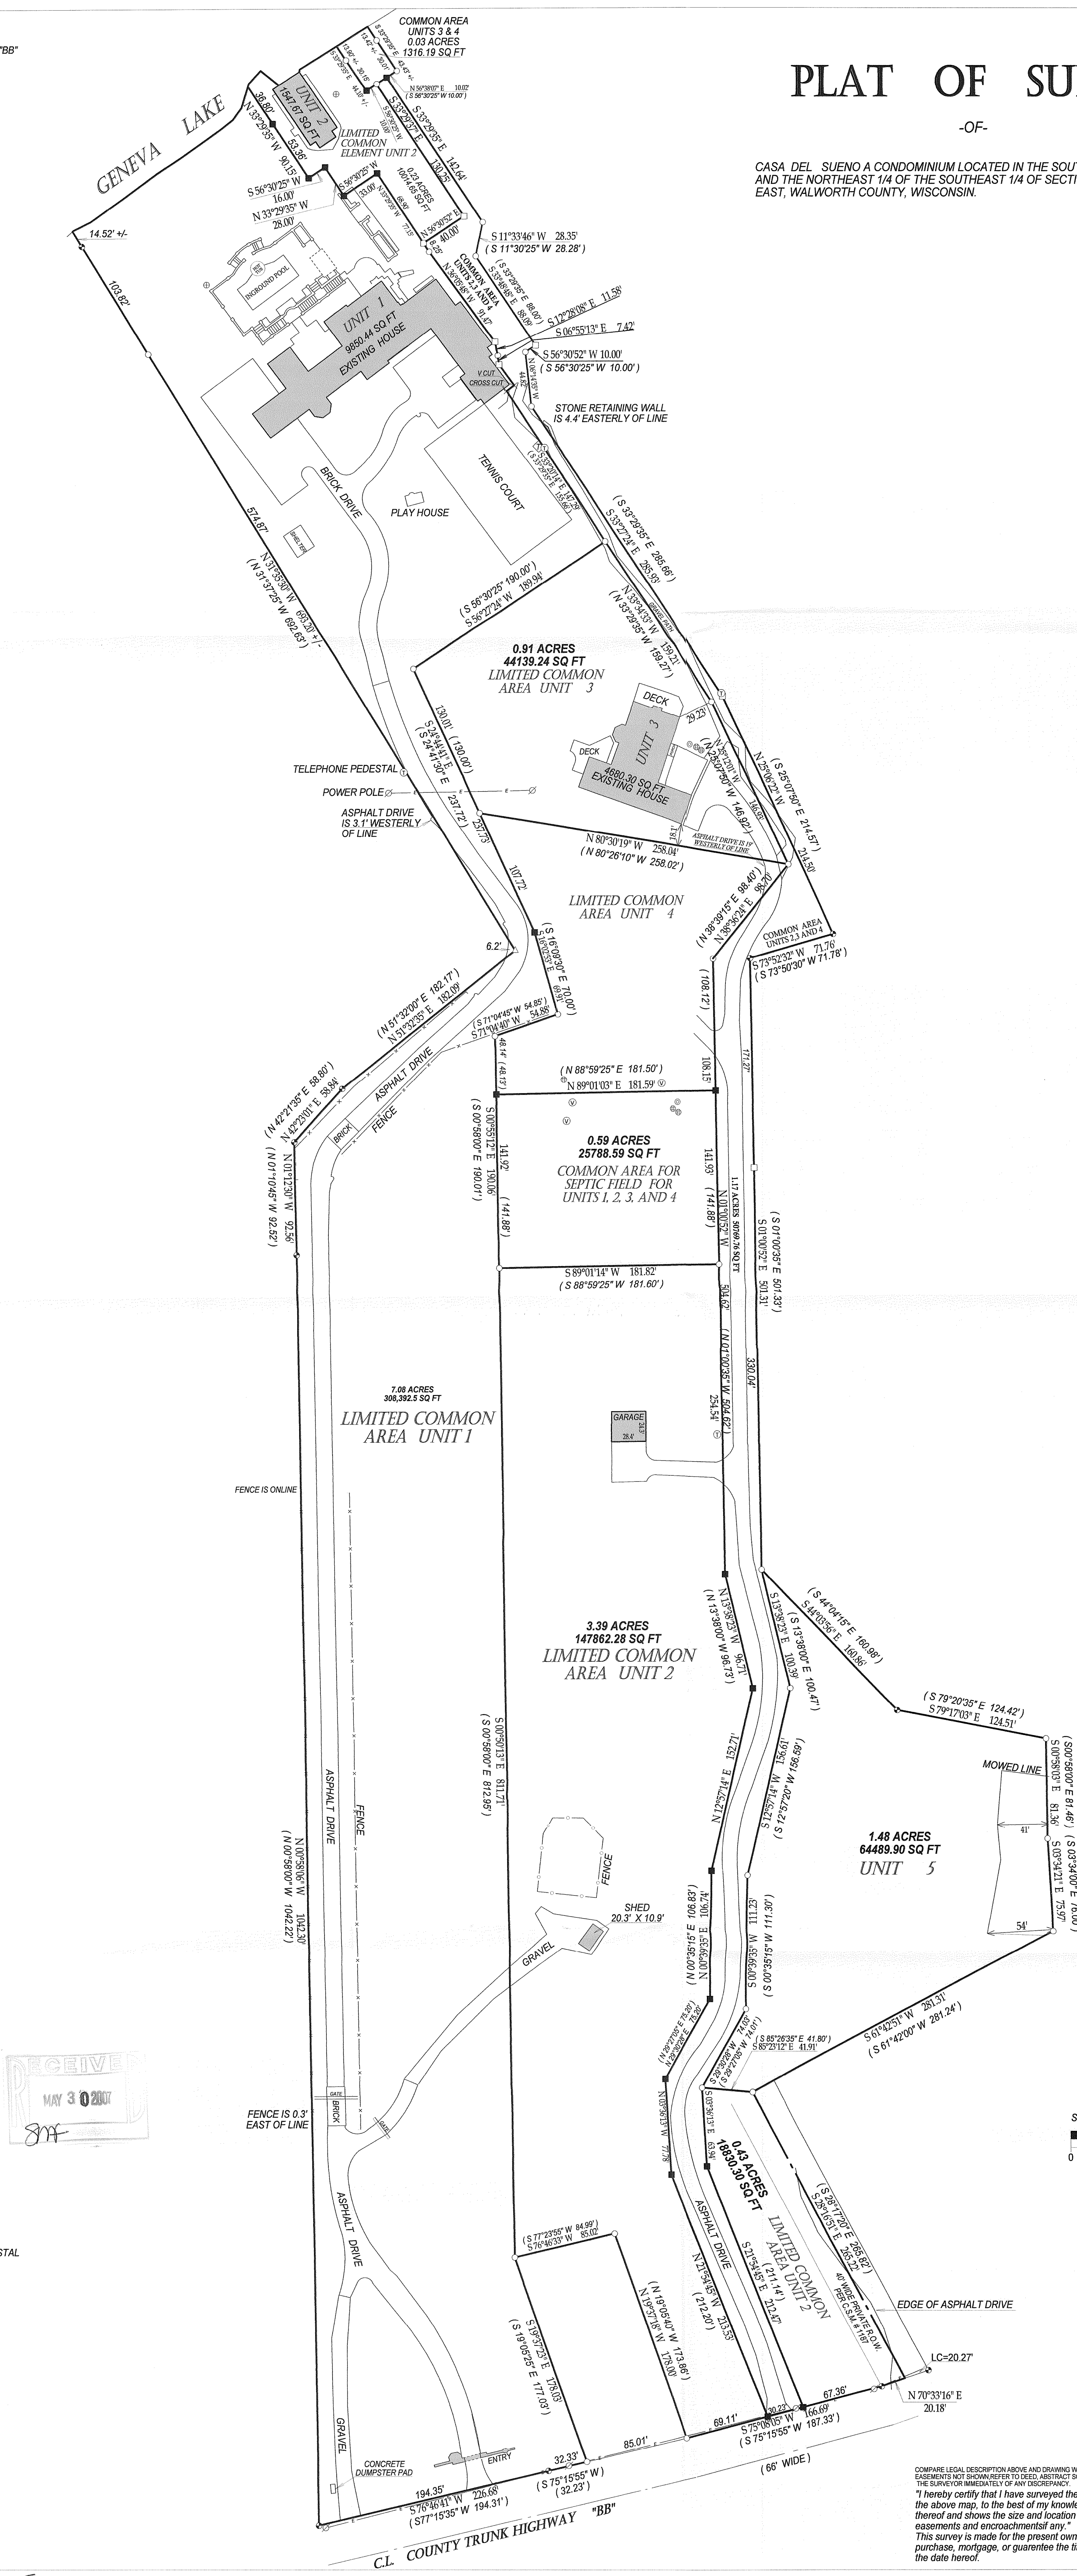



RECEIVED
MAY 3 0 2007
877

LEGEND

- △ = FOUND P.K. NAIL
- ▽ = TELEPHONE PEDESTAL
- ⊞ = ELECTRIC METER
- ⊞ = GAS METER
- ▽ = VENT
- ⊞ = METAL LID
- ⊞ = CONCRETE LID
- ⊞ = WELL
- ⊞ = POWER POLE
- ⊞ = TRANSFORMER
- = OVERHEAD WIRES
- () = recorded as
- = found iron bar
- = found iron pipe
- = set iron pipe
- = set iron bar

SCALE 1" = 60'

0 60 120 180 240 300

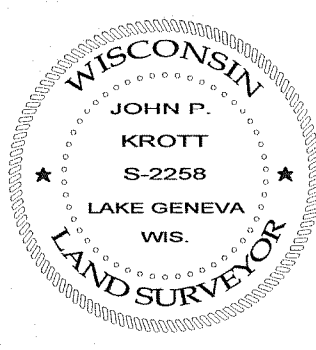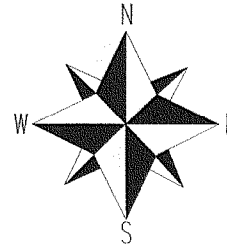

JOHN P. KROTT S-2258
Wisconsin Registered Land Surveyor
(original if signed in red)

DATED THIS THE 10TH DAY OF APRIL 2007

COMPARE LEGAL DESCRIPTION ABOVE AND DRAWINGS WITH DEED, FOR BUILDING RESTRICTIONS AND EASEMENTS NOT SHOWN REFER TO DEED, ABSTRACT SOURCES AND LOCAL MUNICIPAL CODES. NOTIFY THE SURVEYOR IMMEDIATELY OF ANY DISCREPANCY.
I hereby certify that I have surveyed the above described property and that the above map, to the best of my knowledge and belief, is a true representation thereof and shows the size and location of all visible structures, apparent easements and encroachments if any.
This survey is made for the present owners of the property, and those who purchase, mortgage, or guarantee the title thereto, within one year from the date hereof.