


I.P. FOUND AT NORTH LINE OF
BLOCK 1 E. NO. LN. GREENVIEW DR


O - INDICATES IRON PIPE

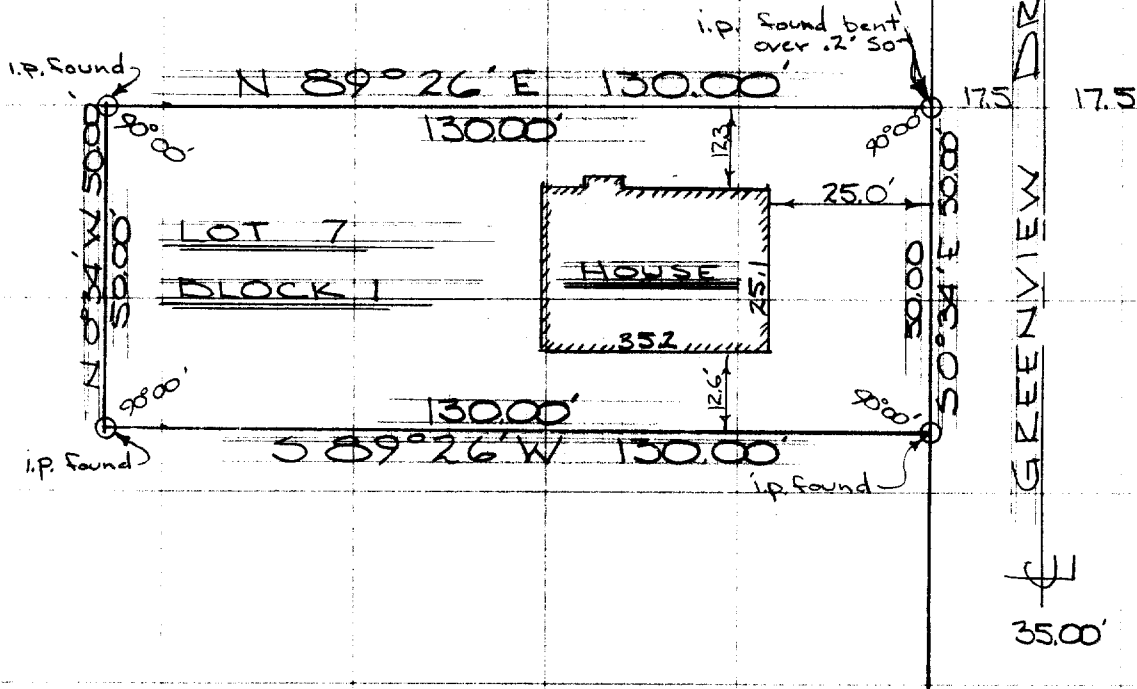

DESCRIPTION: Lot 7 of Block 1 of Sunset Hills Subdivision, located in the NW $\frac{1}{4}$ pf Section 4, T. 1 N., R. 17 E. Walworth County, Wisconsin.

CERTIFICATE: I, James F. Biagi, surveyor, do hereby certify that I have surveyed the property hereon described, and that the location of the improvements are as shown.

June 1, 1967.

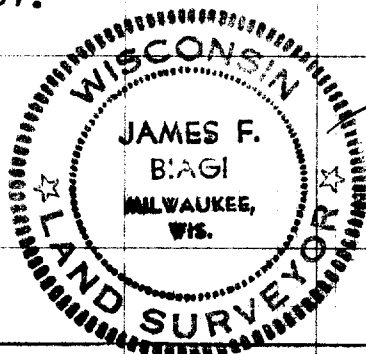

James F. Biagi, RLS 272