


1140 SEQUOIA STREET • DELAVAN, WISCONSIN 53115  
262-728-6737

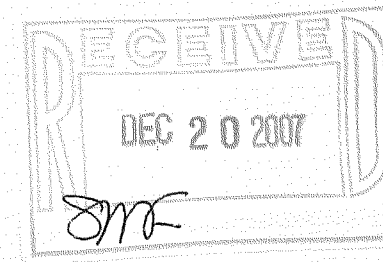

SCALE 1" = 20'

### LEGEND

- Ø - IRON PIPE FOUND  
 ⚙ - IRON ROD FOUND  
 X - CROSS CUT IN CONCRETE FOUND  
 △ - UTILITY POLE  
 ———— - OVERHEAD UTILITY LINES  
 \* ———— \* - WOOD FENCE  
 \*\* ———— \*\* - CHAINLINK FENCE  
 CS - CONCRETE STOOP  
 ( ) - RECORDED AS

## PLAT OF SURVEY OF

LOT 17, SHORE HAVEN, LOCATED IN T1N, R17E,  
TOWN OF LINN, WALWORTH COUNTY, WISCONSIN.

I HEREBY CERTIFY THAT I HAVE SURVEYED THE ABOVE DESCRIBED PROPERTY AND THAT THE ABOVE MAP IS A TRUE REPRESENTATION THEREOF AND SHOWS THE SIZE AND LOCATION OF THE PROPERTY, ITS EXTERIOR BOUNDARIES, THE LOCATION OF ALL VISIBLE STRUCTURES AND DIMENSIONS OF ALL PRINCIPAL BUILDINGS THEREON, BOUNDARY FENCES, APPARENT EASEMENTS, ROADWAYS AND VISIBLE ENCROACHMENTS, IF ANY, TO THE BEST OF MY KNOWLEDGE AND BELIEF.

THIS SURVEY IS MADE FOR THE USE OF THE PRESENT OWNERS OF THE PROPERTY, AND ALSO THOSE WHO PURCHASE, MORTGAGE, OR GUARANTEE THE TITLE THERETO WITHIN ONE (1) YEAR FROM DATE HEREON.

Daniel F. Ruff

DAVID F. ABELL  
WISCONSIN REGISTERED LAND SURVEYOR, S-1596

November 5, 2007

DATE \_\_\_\_\_ JOB NUMBER - 07075  
NOTE: THIS IS NOT A CERTIFIED COPY UNLESS SEALED.

ORDERED BY: ZELL'S WOODWORKING INC.  
1299 CENTER STREET  
DELAVER, WI 53115

OWNER: MARTIN-SHORE HAVEN FAMILY  
LTD PARTNERSHIP

ISA-110

117-2890