


HAROLD H. KOLB

REGISTERED PROFESSIONAL LAND SURVEYOR
LAKE GENEVA, WISCONSIN
16' PRIVATE ROAD

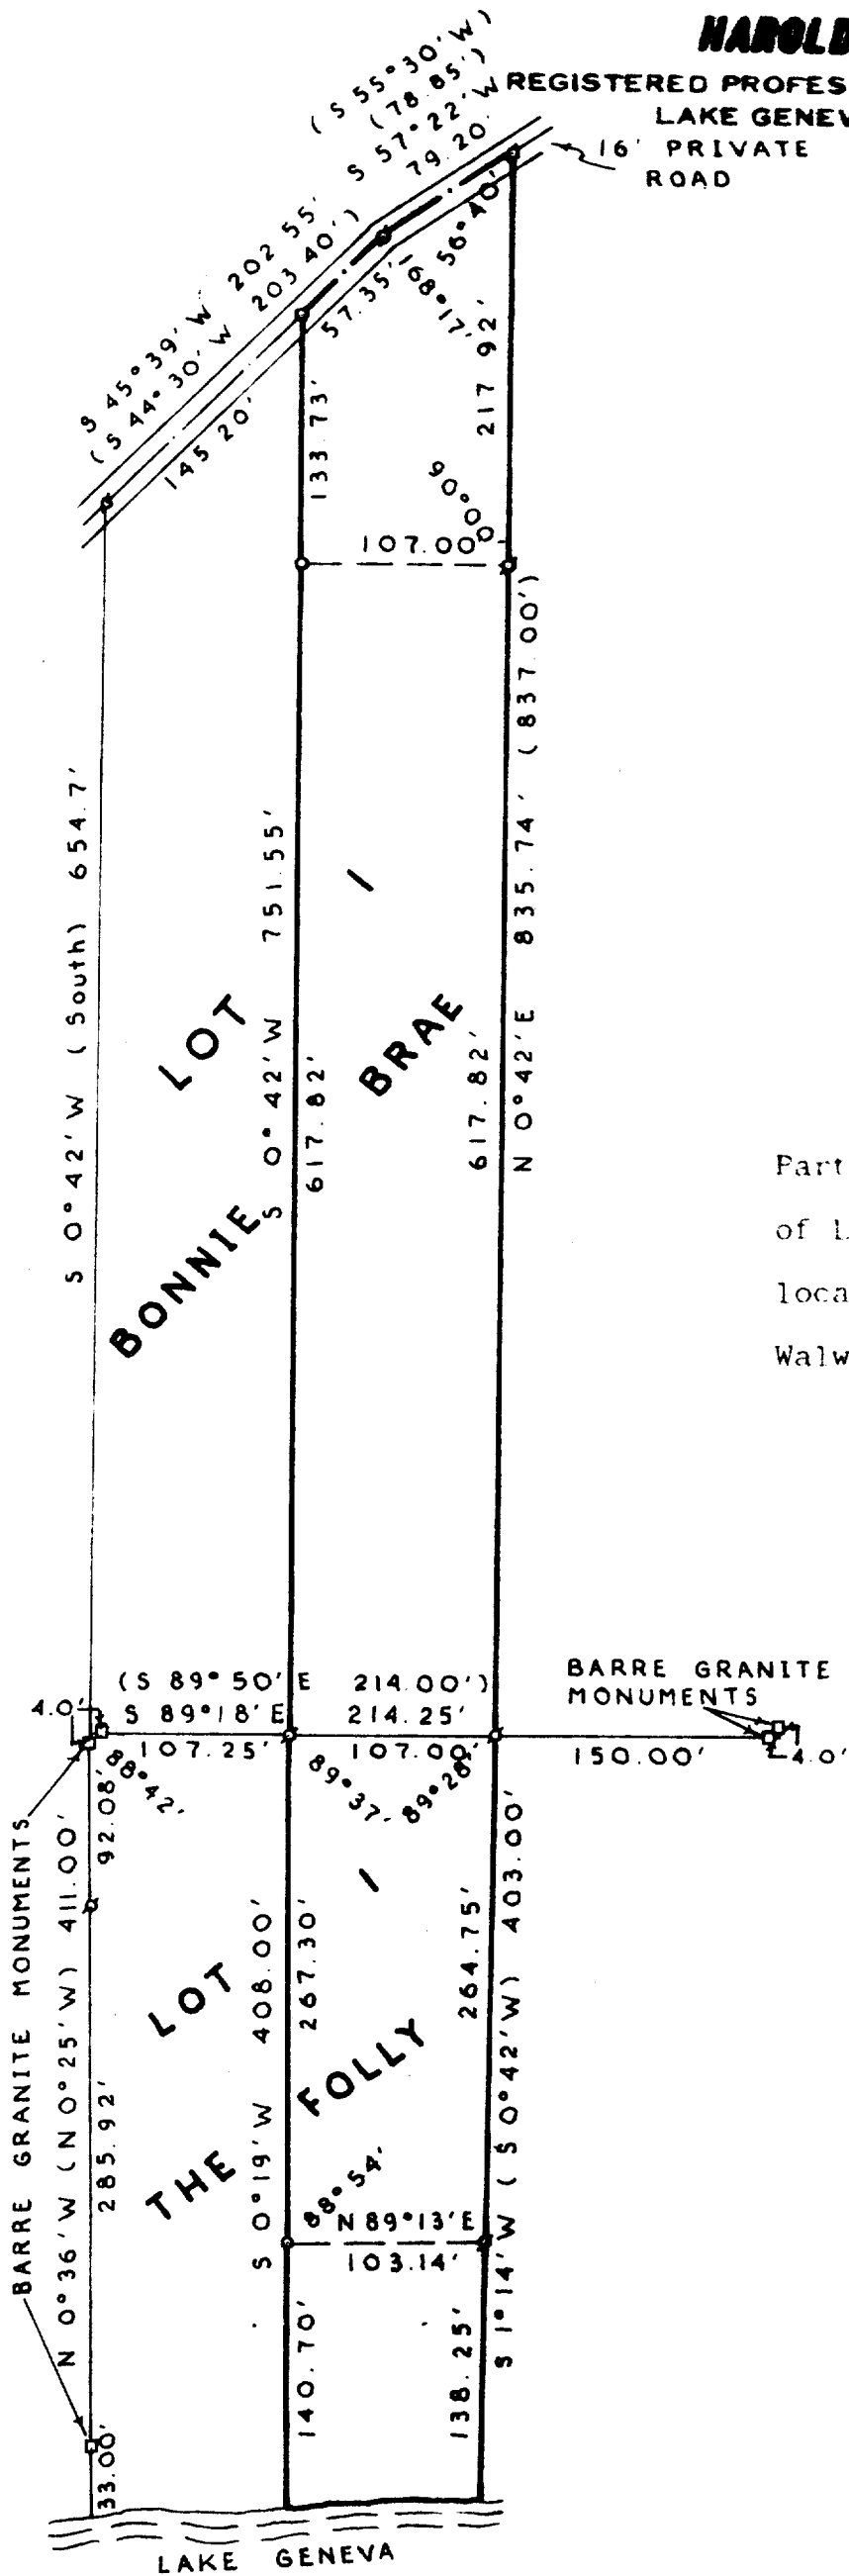

PLAT OF SURVEY OF

Part of Lot 1, Bonnie Brae, and part
of Lot 1, "The Folly," subdivisions
located in Section 3, T 1 N, R 17 E,
Walworth County, Wisconsin.



I, HAROLD H. KOLB, DO HEREBY CERTIFY THAT I HAVE
SURVEYED THE PROPERTY HEREON DESCRIBED ACCORDING
TO THE OFFICIAL RECORDS, AND THAT THE PLAT HEREON
IS A CORRECT REPRESENTATION OF THE LOT LINES.

Harold H. Kolb
HAROLD H. KOLB

WISCONSIN REGISTERED LAND SURVEYOR, S-187
DATE October 7, 1971

BB-5
F-1A

117-295