

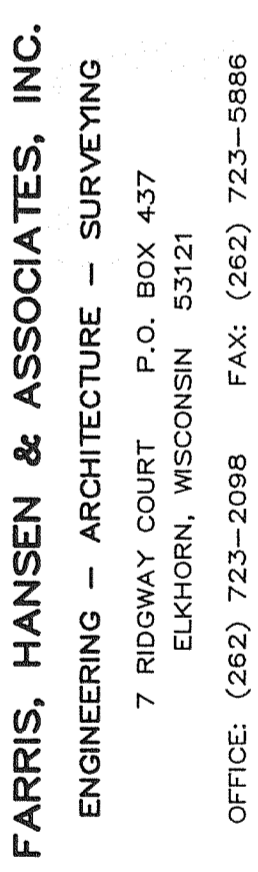


— WORK ORDERED BY —
FISCHER FINE HOMES
PO BOX 500
FONTANA, WI. 53125

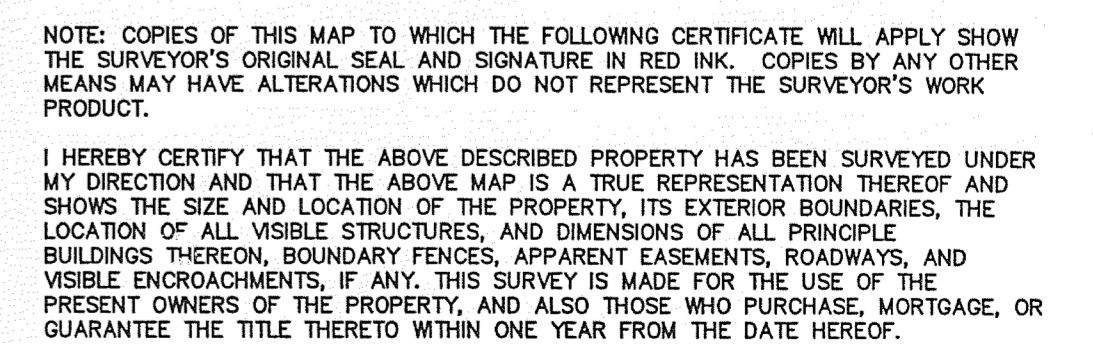


REVISIONS


3/17/2007-KB
TO SHOW SIZE AND
LOCATION OF
PROPOSED RESIDENCE

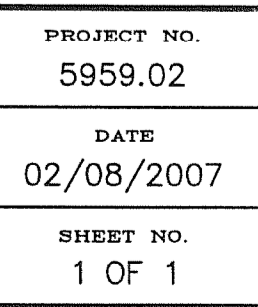


DATED: FEBRUARY 9, 2007


PETER S. GORDON

REVISED 07-22-2008
TO SHOW SIZE & LOCATION OF
AS BUILT RESIDENCE & DECKS

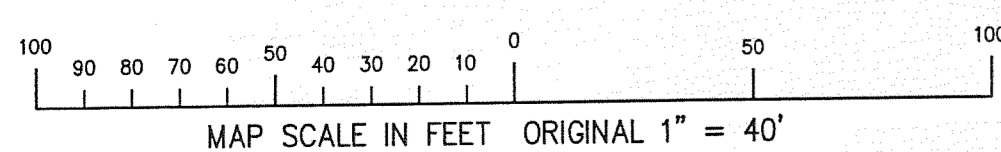

RECEIVED
JUL 29 2008
SMF

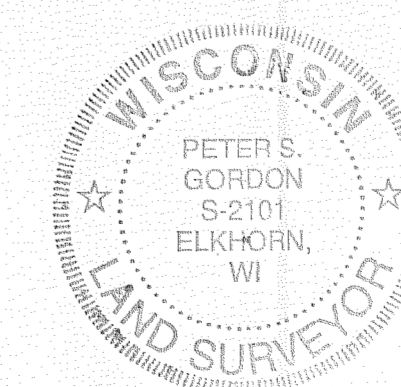

117-2955

1/22/2008 X:\Projects\5959\PERMIT_LOT2

IA3518-2