



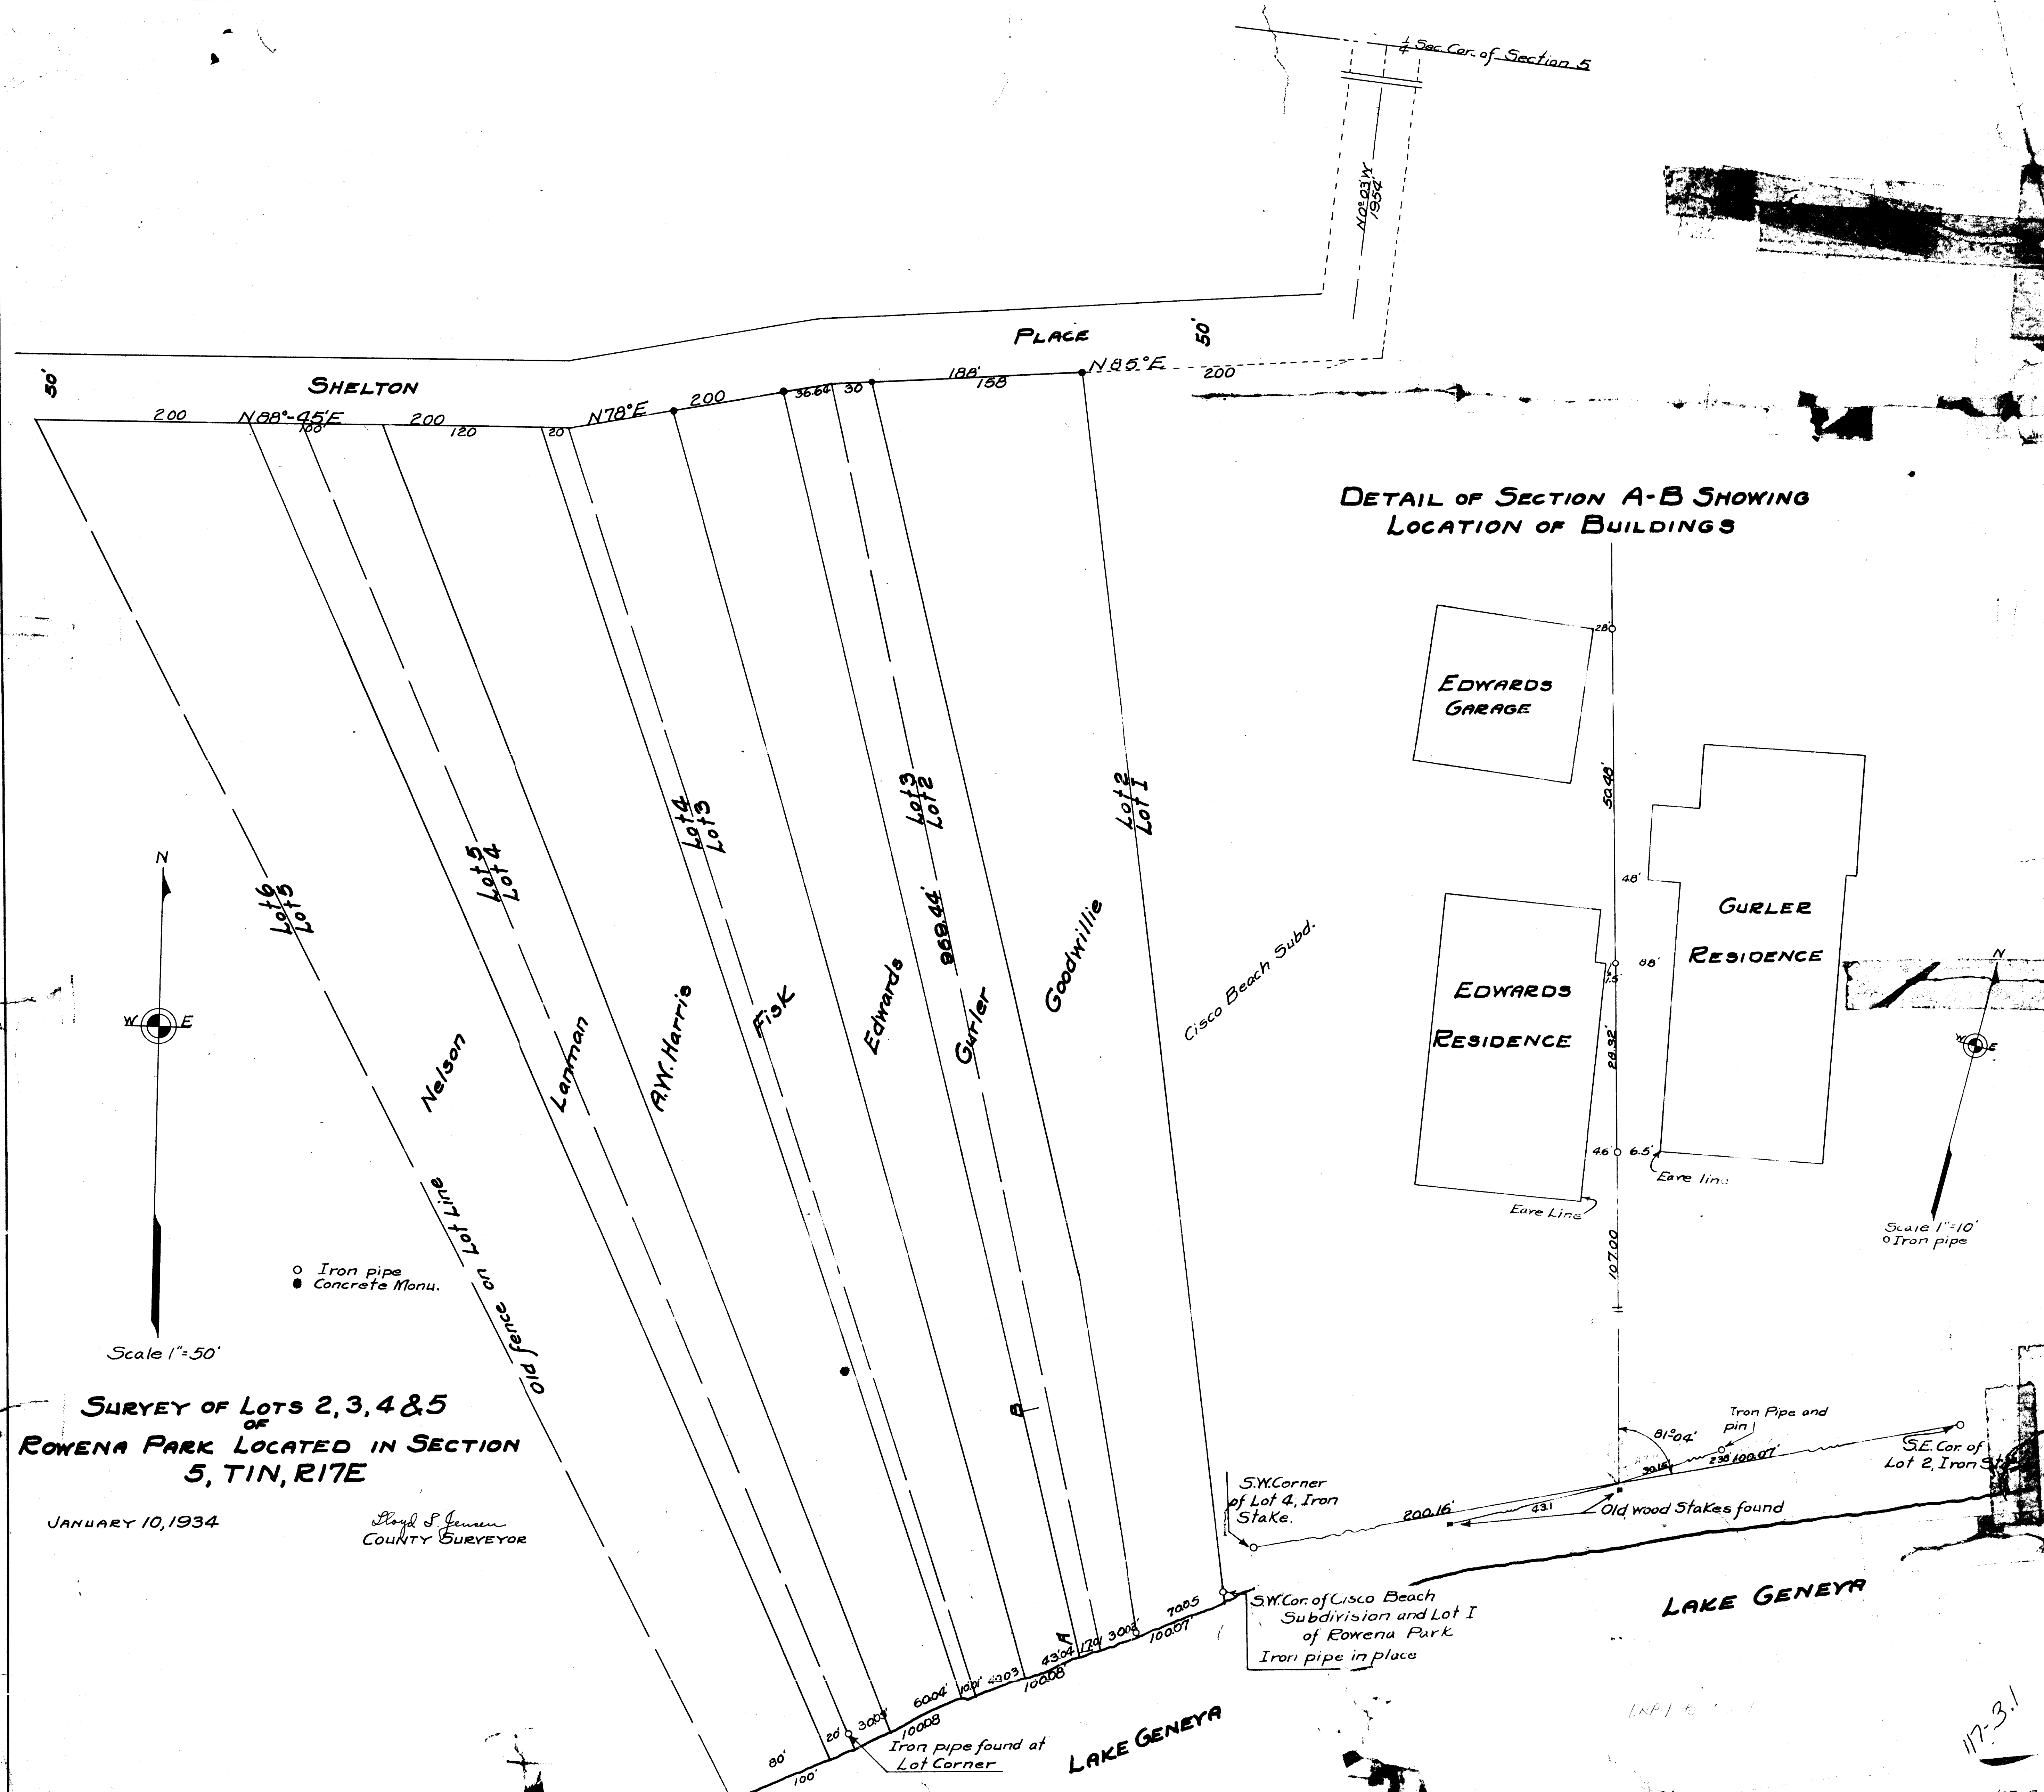

DETAIL OF SECTION A-B SHOWING
LOCATION OF BUILDINGS

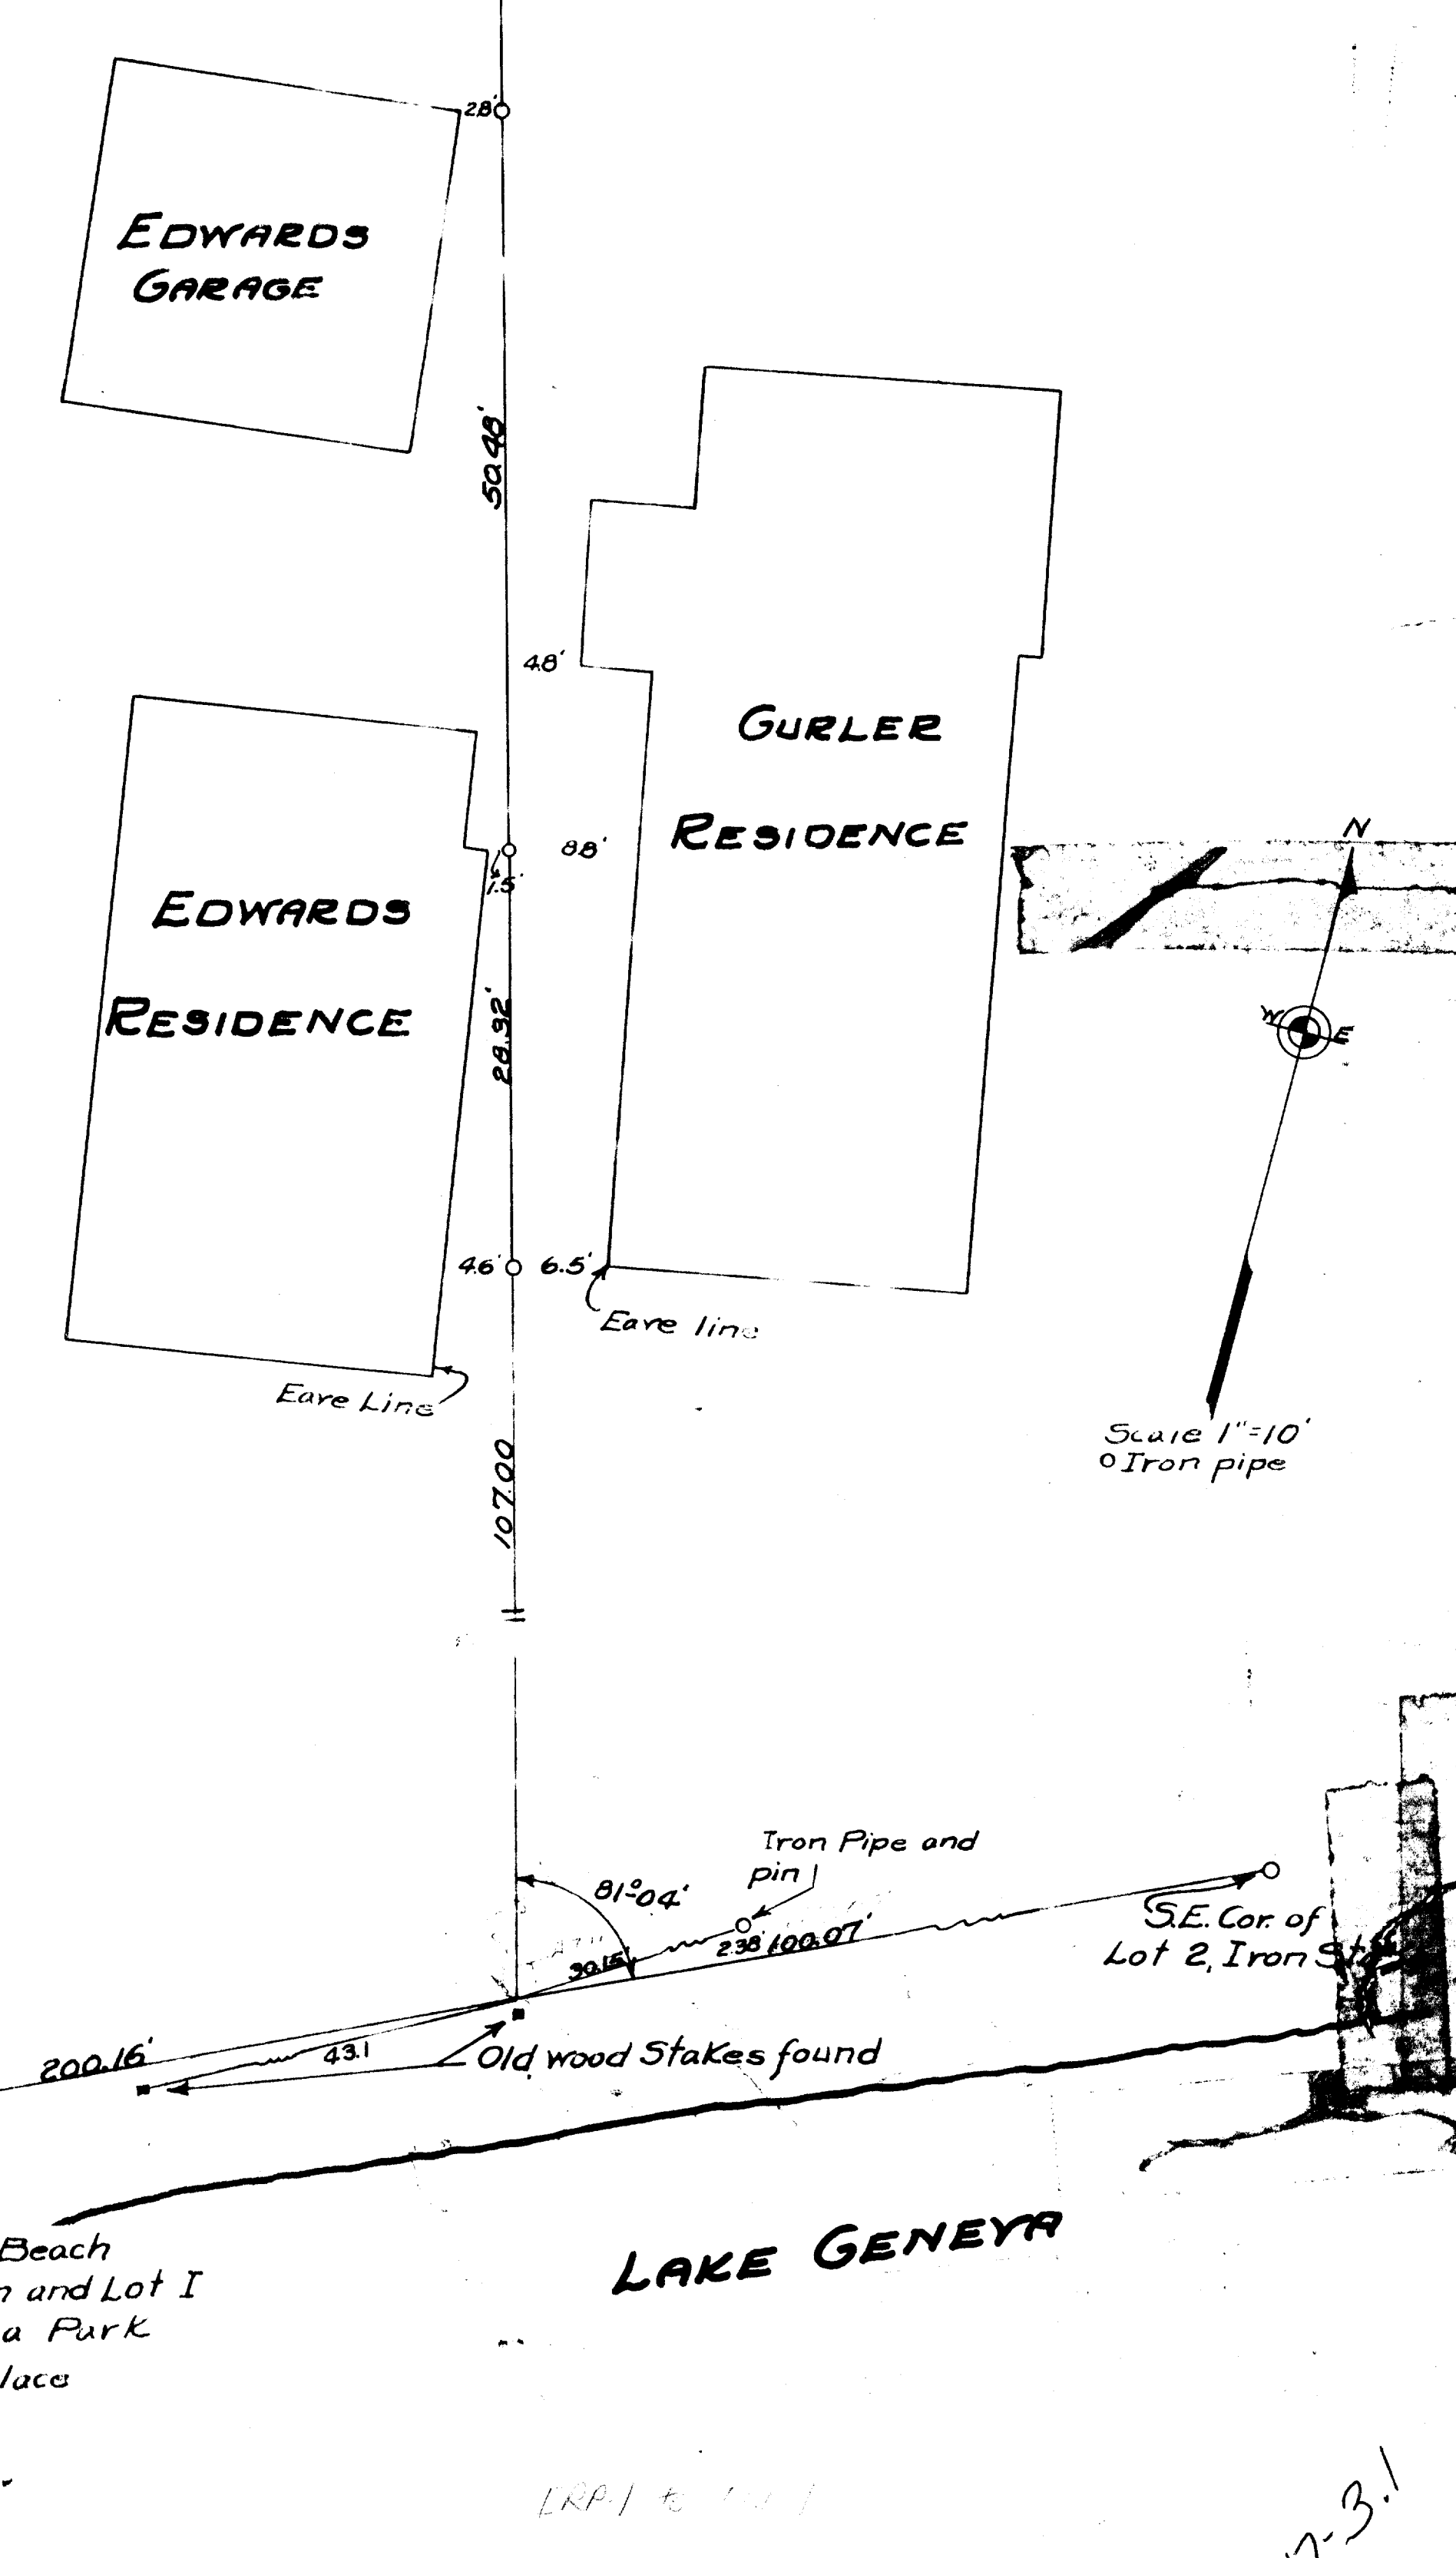

SURVEY OF LOTS 2, 3, 4 & 5
OF
ROWENA PARK LOCATED IN SECTION
5, T1N, R17E

JANUARY 10, 1934

Lloyd S. Jensen
COUNTY SURVEYOR

LAKE GENEVA

117-3.1