


O - INDICATES IRON PIPE

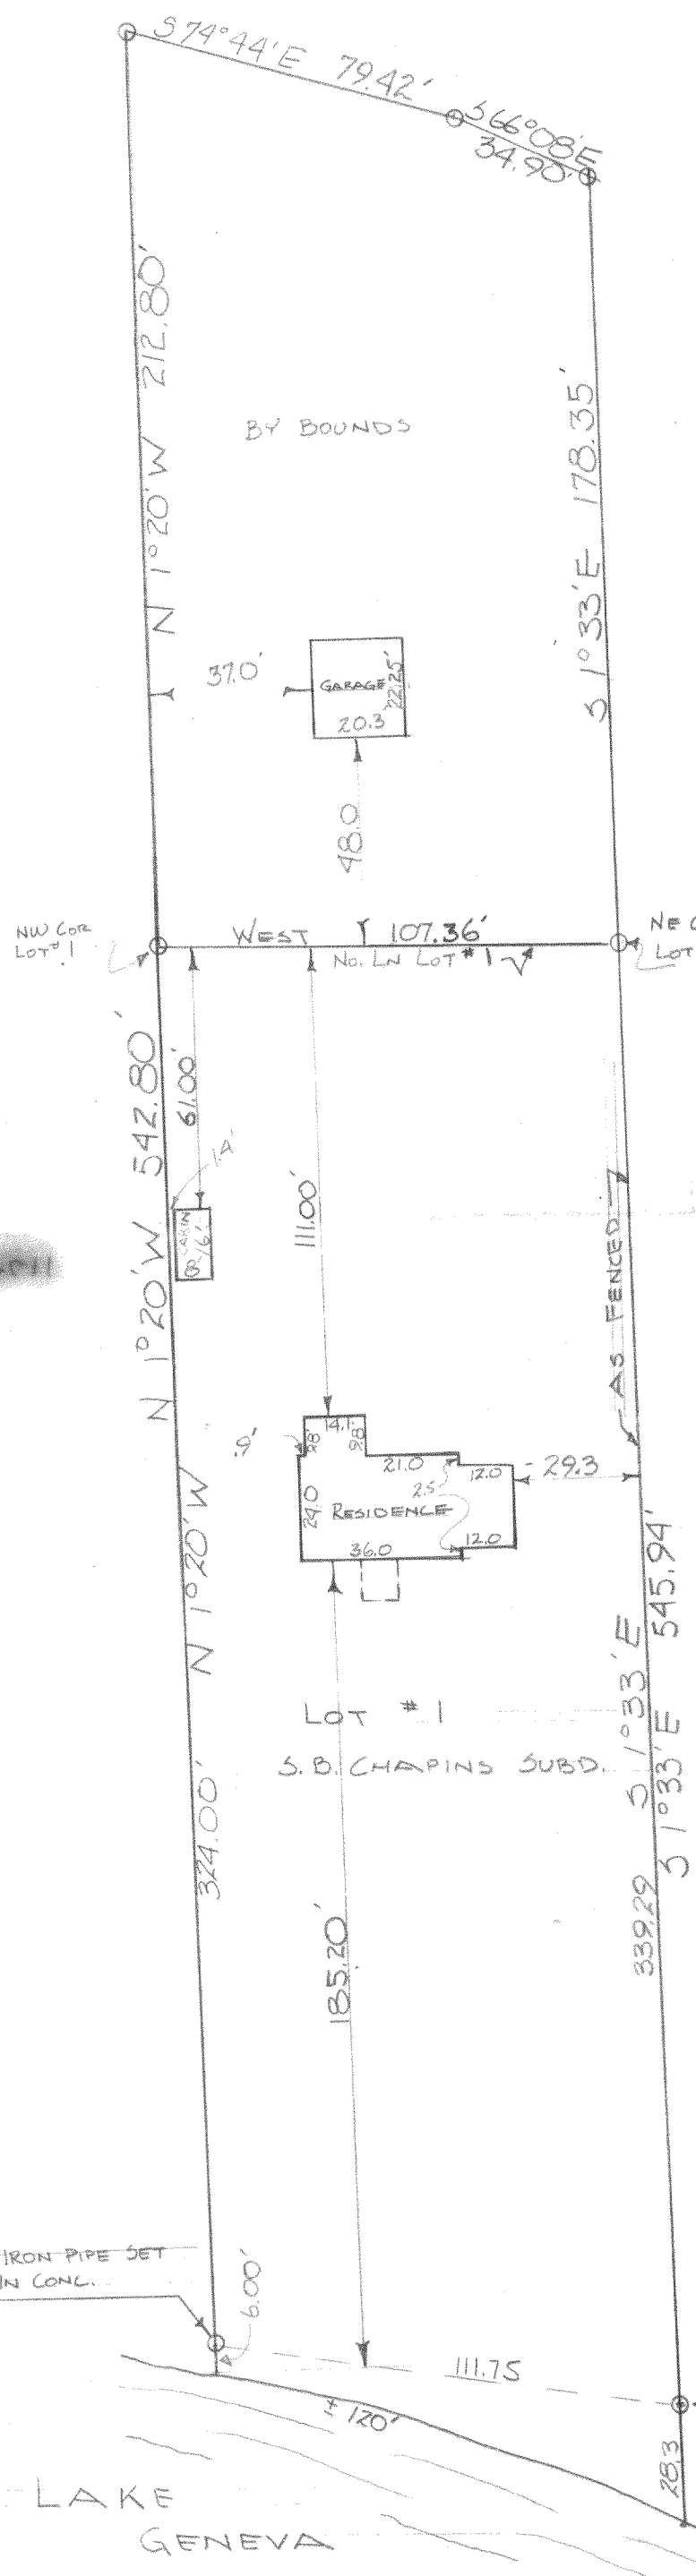


DESCRIPTION: Lot # 1 of S.B. Chapins Subdivision in T. 1 N., R. 17 E., Linn Township, Walworth County, Wisconsin; also commencing at the NW corner of said lot #1 Chapins Subdivision; thence N 1° 20' W 212.80 feet to an iron stake, thence S 74° 44' E 79.42 feet to an iron stake, thence S 66° 08' E 34.90 feet to an iron stake, thence S 1° 33' E 178.35 feet to the NE corner of said lot #1, thence West along the North line of lot #1 107.36 feet to the NW corner of said lot #1 the place of beginning.

CERTIFICATE: I, James F. Biagi, Surveyor, do hereby certify that I have surveyed the property hereon described, and that the location of all the improvements are as shown on the plat.

Surveyed June 22, 1961.

James F. Biagi
James F. Biagi BLS 272

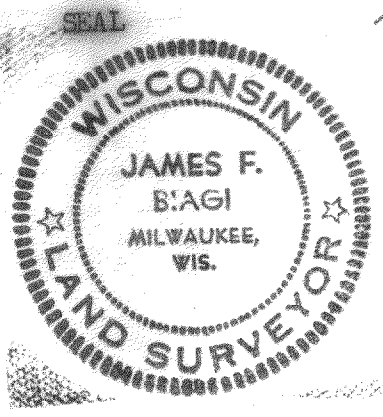

ICH-2
4
L-4-17