


CERTIFIED SURVEY MAP NO. 815

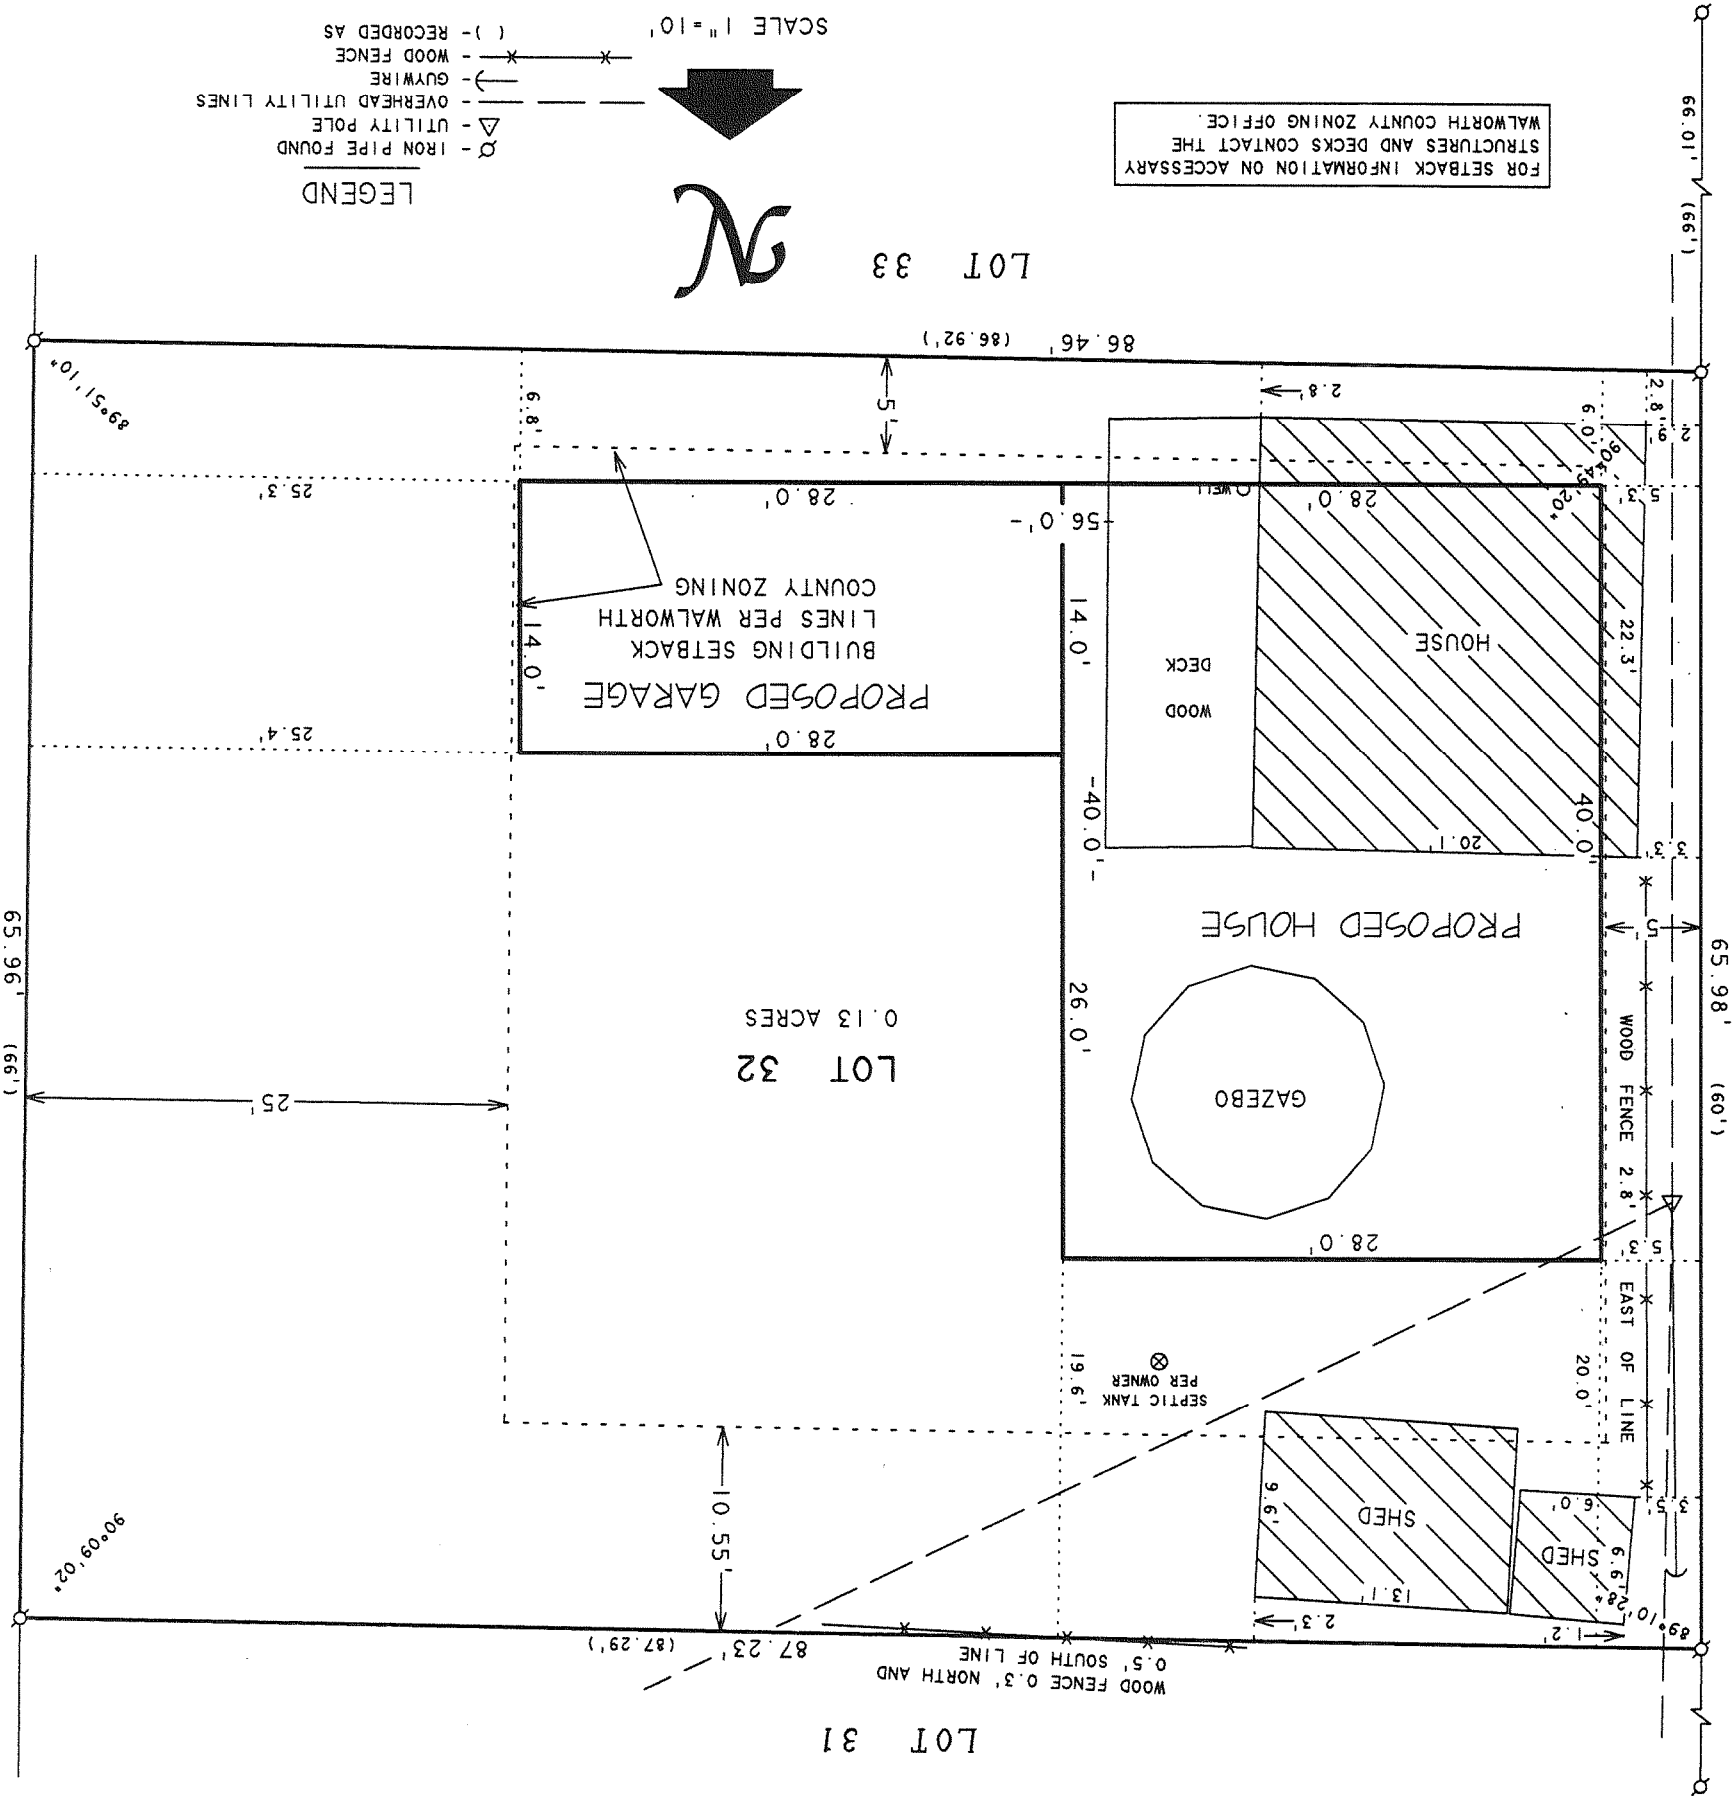

SCALE 1"=10'
LEGEND
- IRON PIPE FOUND
- UTILITY POLE
- OVERHEAD UTILITY LINES
- GUYWIRE
- WOOD FENCE
- RECORDED AS

FOR SETBACK INFORMATION ON ACCESSARY STRUCTURES AND DECKS CONTACT THE WALWORTH COUNTY ZONING OFFICE.

NOTE: THIS IS NOT A CERTIFIED COPY UNLESS SEALED.
JOB NUMBER - 08029A
DATE August 11, 2008


DAVID F. ABELL
WISCONSIN REGISTERED LAND SURVEYOR, S-1596
THIS SURVEY IS MADE FOR THE USE OF THE PRESENT OWNERS OF THE PROPERTY, AND ALSO THOSE WHO PURCHASE, MORTGAGE, OR GUARANTEE THE TITLE THERETO WITHIN ONE (1) YEAR FROM DATE HEREON.

I HEREBY CERTIFY THAT I HAVE SURVEYED THE ABOVE DESCRIBED PROPERTY AND THAT THE ABOVE MAP IS A TRUE REPRESENTATION THEREOF AND SHOWS THE SIZE AND LOCATION OF THE PROPERTY, ITS EXTERIOR BOUNDARIES, THE LOCATION OF ALL VISIBLE STRUCTURES AND DIMENSIONS OF ALL PRINCIPAL BUILDINGS THEREON, BOUNDARY FENCES, APPARENT EASEMENTS, ROADWAYS AND VISIBLE ENCROACHMENTS, IF ANY, TO THE BEST OF MY KNOWLEDGE AND BELIEF.

ORDERED BY: LES ZEMATIS
207 ADLER DRIVE
LIBERTYVILLE, IL 60048
REVISED DATE: DECEMBER 29, 2008
REVISED TO SHOW PROPOSED HOUSE AND GARAGE LOCATION.
ORDERED BY: STURG TAGGART
WISCONSIN HOMES OF LAKE GENEVA
98 E. MAIN STREET
LAKE GENEVA, WI 53147

LOT 32 OF ROBINSONS 2nd SUBDIVISION,
LOCATED IN TIRRIE, TOWN OF LINN,
WALWORTH COUNTY, WISCONSIN.

PLAT OF SURVEY OF

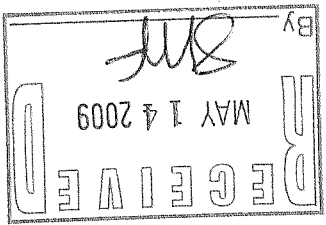

1140 SEQUOIA STREET • DELAVAN, WISCONSIN 53115
262-728-6737

ABELL
SURVEYING & MAPPING

MAPLE STREET

(LOT A - 40 FEET WIDE)

1RB2-06A

117-3030