


PLAT OF SURVEY

-OF-


LOT 1 CERTIFIED SURVEY MAP NO. 4139 LOCATED IN GOVERNMENT LOT 2 OF  
SECTION 11, TOWN 1 NORTH, RANGE 17 EAST WALWORTH COUNTY, WISCONSIN.

KROTT SURVEYING INC.  
N3705 WILLOW BEND LANE  
LAKE GENEVA WI. 53147  
PHONE # (262)248-3697  
FAX # (262)249-0639

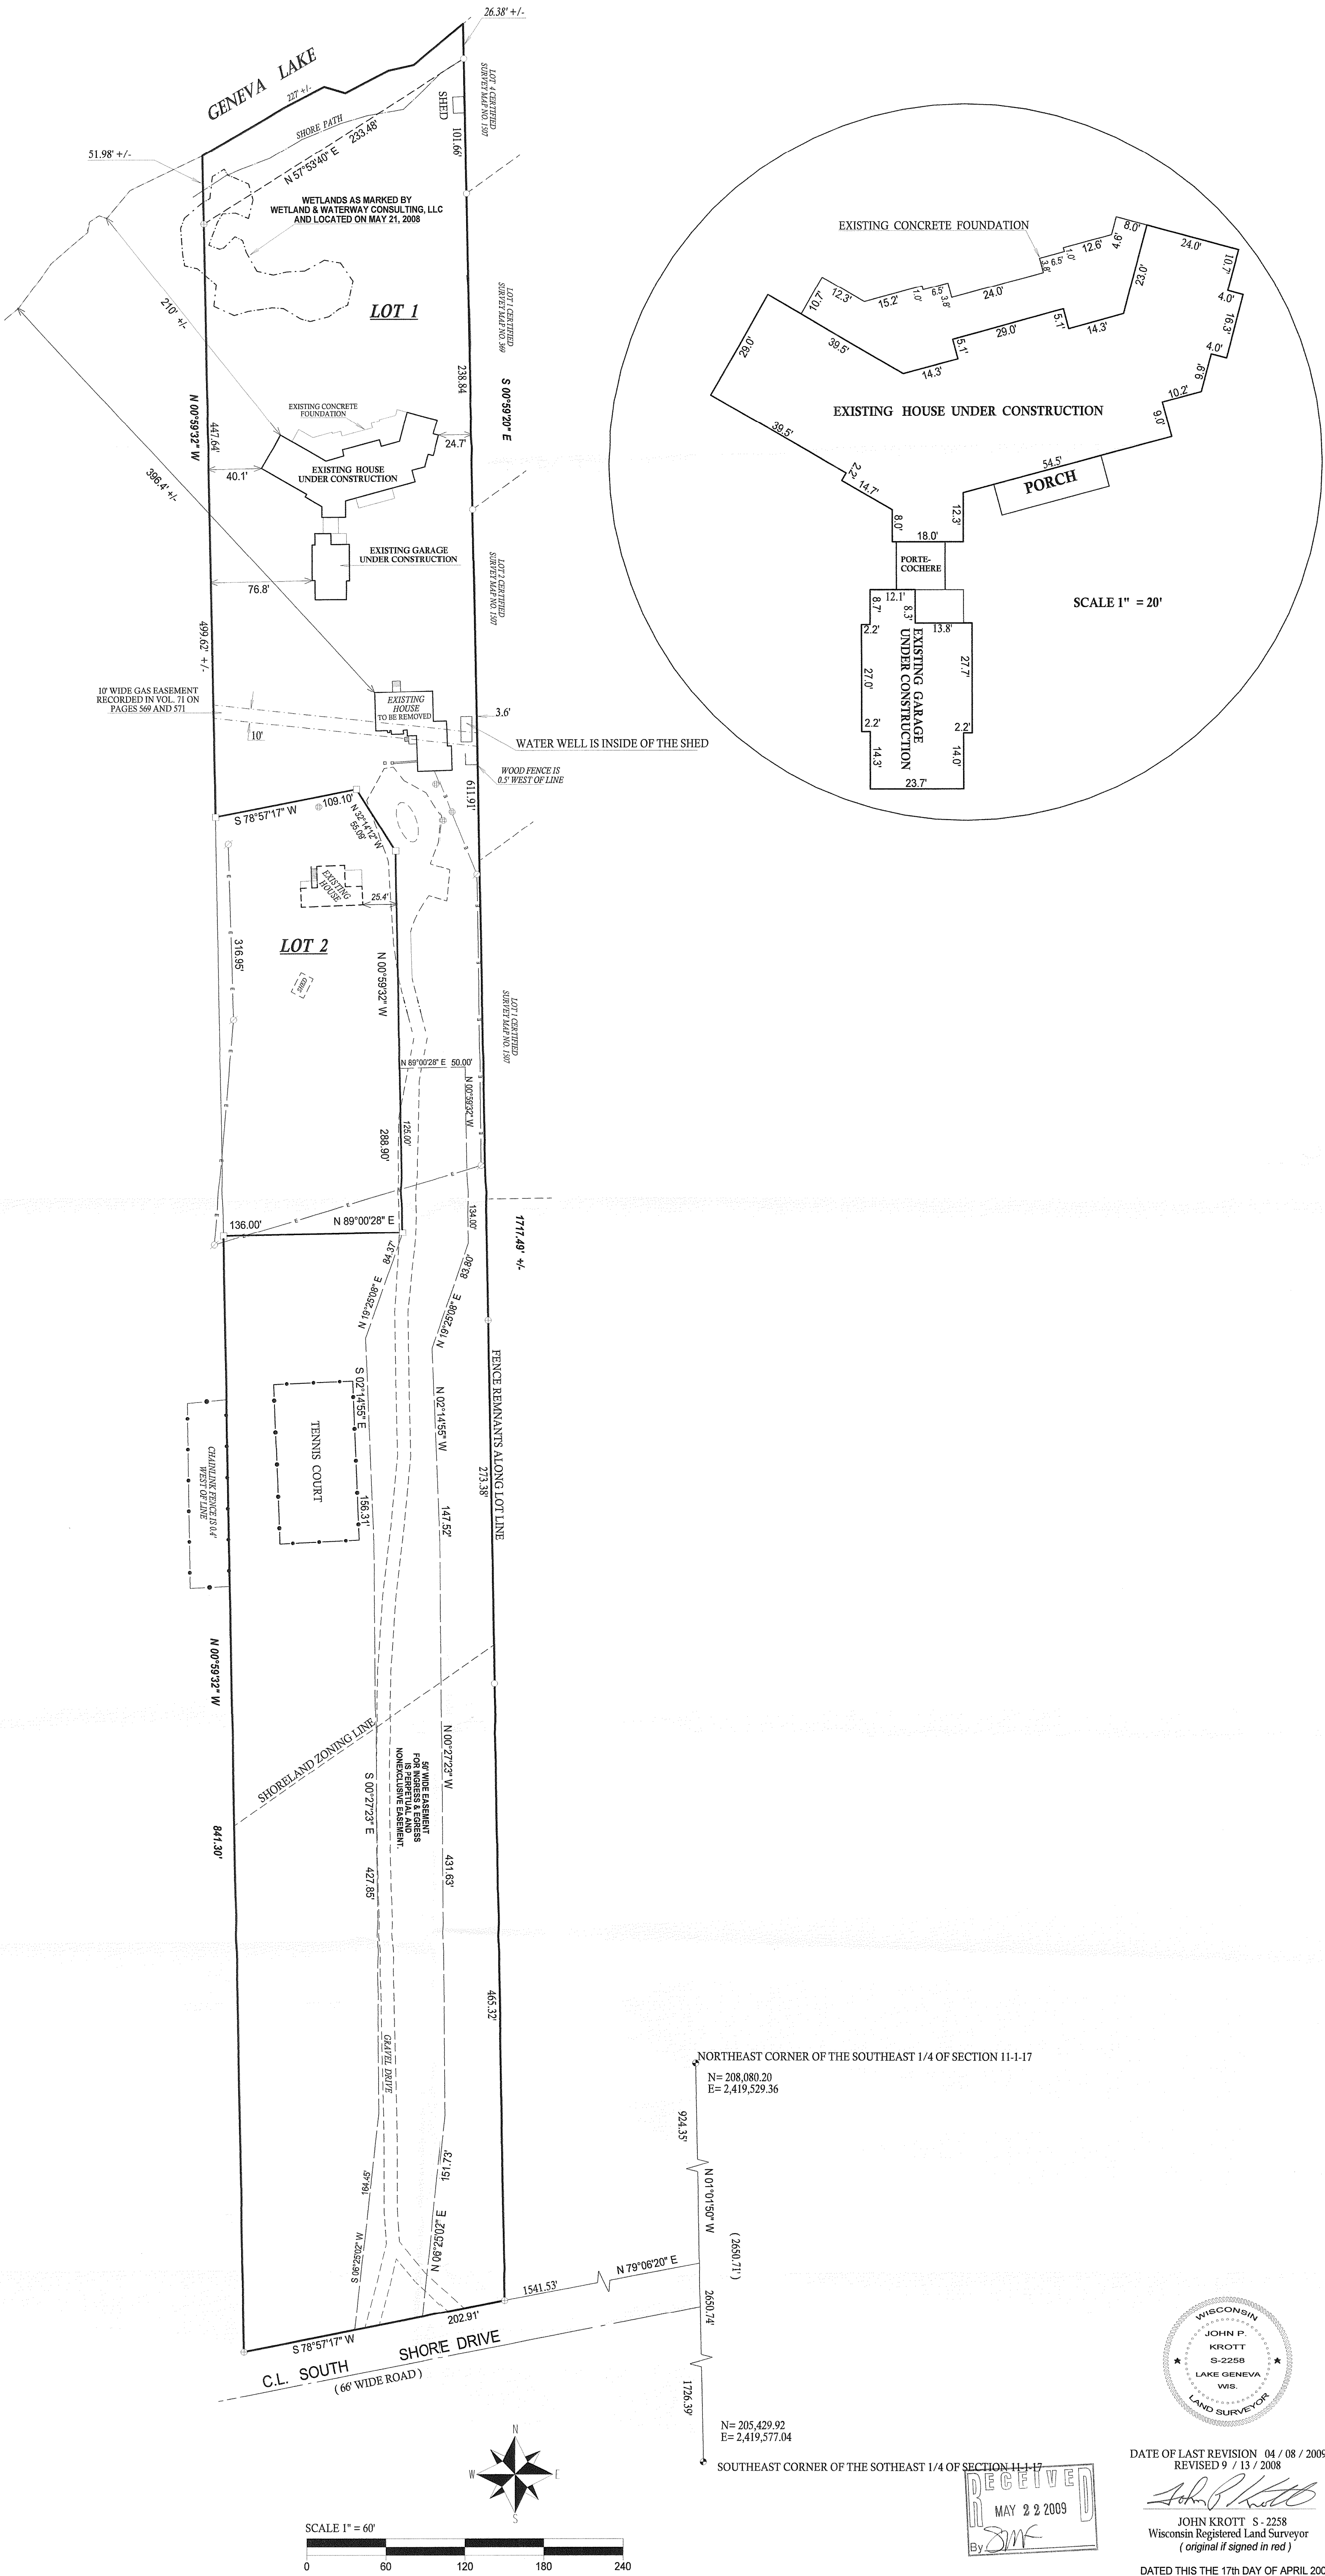


LEGEND  
○ 1" DIA. IRON PIPE, FOUND  
— OVERHEAD WIRES  
⊗ POWER POLE  
⊕ PRIVATE SANITARY SEWER ACCESS COVER  
⊙ FOUND CONCRETE MON.  
□ FOUND IRON BAR  
TAX ID # 1A413900001  
JOB # 07-078AB

SCALE 1" = 60'

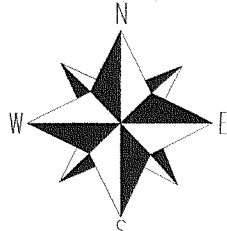

RECEIVED  
MAY 22 2009  
By SMC

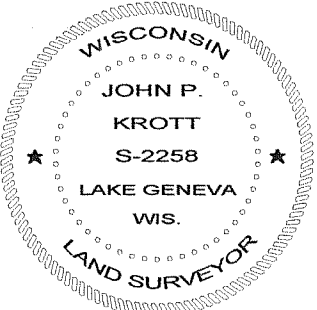

DATE OF LAST REVISION 04 / 08 / 2009  
REVISED 9 / 13 / 2008  
JOHN KROTT S - 2258  
Wisconsin Registered Land Surveyor  
(original if signed in red)  
DATED THIS THE 17th DAY OF APRIL 2008.

117-3053